

SUBBASE OF DENSE GRADED CRUSHED STONE

23+00.0 RT - 27+60.0 RT
22+50.0 RT - 23+34.0 RT

AGGREGATE SHOULDERS, IN PLACE

~~23+75.0 RT - 27+20.0 RT~~
NOT USED

STONE FILL, TYPE II

23+75.0 RT - 27+00.0 RT

STONE FILL, TYPE IV

23+00.0 RT - ~~27+60.0 RT~~ 28+50 RT

RELOCATE MAILBOX, SINGLE SUPPORT

26+43.0 X2 (MOVE TO TEMPORARY LOCATION
THEN RELOCATE BACK TO PERMANENT LOCATION)

REMOVE AND RESET GUARDRAIL

~~23+75.0 RT - 27+25.0 RT~~
~~24+00 RT - 27+00 RT~~

GRUBBING MATERIAL

23+75.0 RT - ~~27+00.0 RT~~
00 28+50

REMOVING SIGNS

25+22.0 RT

ERECTING SALVAGED SIGNS

25+22.0 RT

EXISTING DRAINAGE

3 24+47.9 LT - 24+47.9 RT
EXISTING PIPE - REPLACE 10-FOOT OF PIPE

4 28+13.3 LT - 27+31.1 RT
EXISTING PIPE - REPLACE 10-FOOT OF PIPE

NEW DRAINAGE



3 24+47.9 RT ~ 24+47.9 RT
NEW 18" X 10" PIPE PCCSP

4 27+35.7 RT ~ 27+31.1 RT
NEW 18" X 10" PIPE PCCSP


VT ROUTE 9
CURVE # 1
DELTA = 11°43'31" LT
D = 0°57'29"
R = 5980.51'
T = 614.08'
L = 1223.88'
E = 31.44'
BANK = 0.020 @ 50 MPH

END PROJECT SEARSBURG NH-010-1(48)

POC STA. ~~27+60.00 (MM 3.424)~~ 28+50(MM 3.407)
END EMBANKMENT RECONSTRUCTION

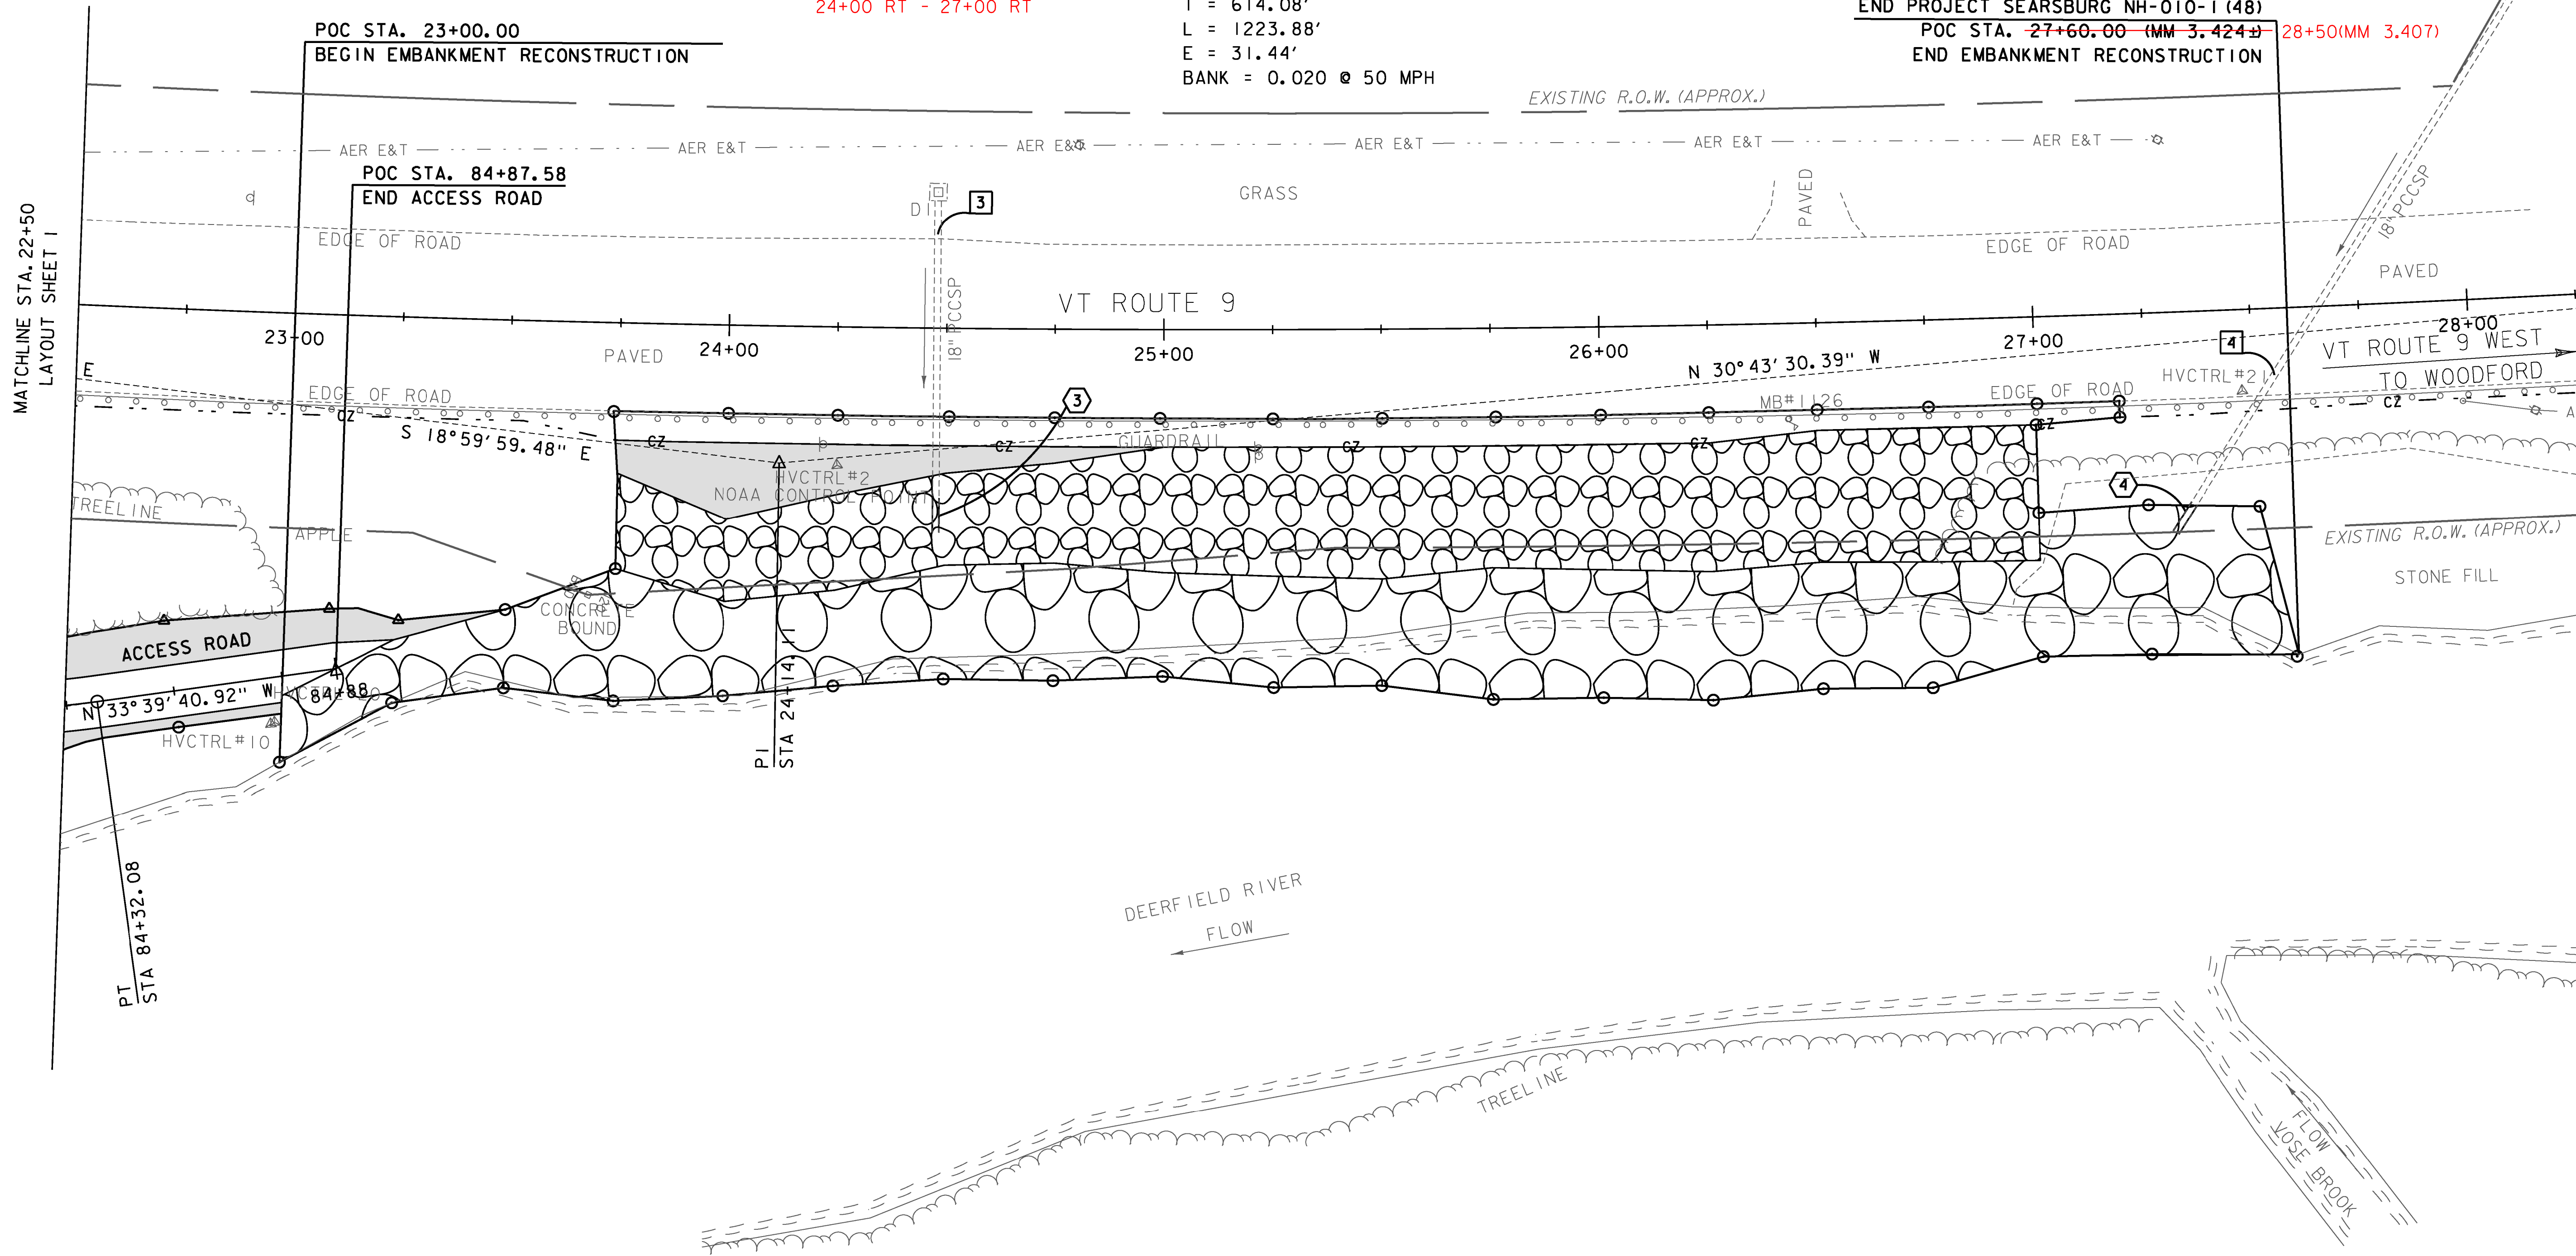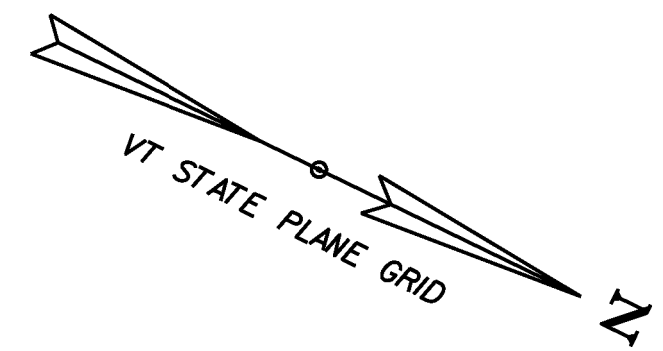

MATCHLINE STA. 22+50
LAYOUT SHEET 1

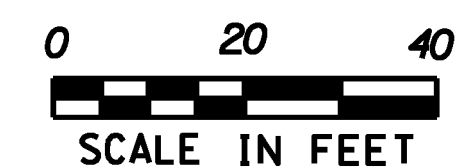

PROJECT NAME: SEARSBURG	
PROJECT NUMBER: NH 010-1(48)	
FILE NAME: z12B404bdr.dgn	PLOT DATE: 6/16/2014
PROJECT LEADER: E. ATKINS	DRAWN BY: M. BRADLEY
DESIGNED BY: M. BRADLEY	CHECKED BY: E. ATKINS
PLAN SHEET 2	SHEET 17 OF 45