


ACCESS ROAD

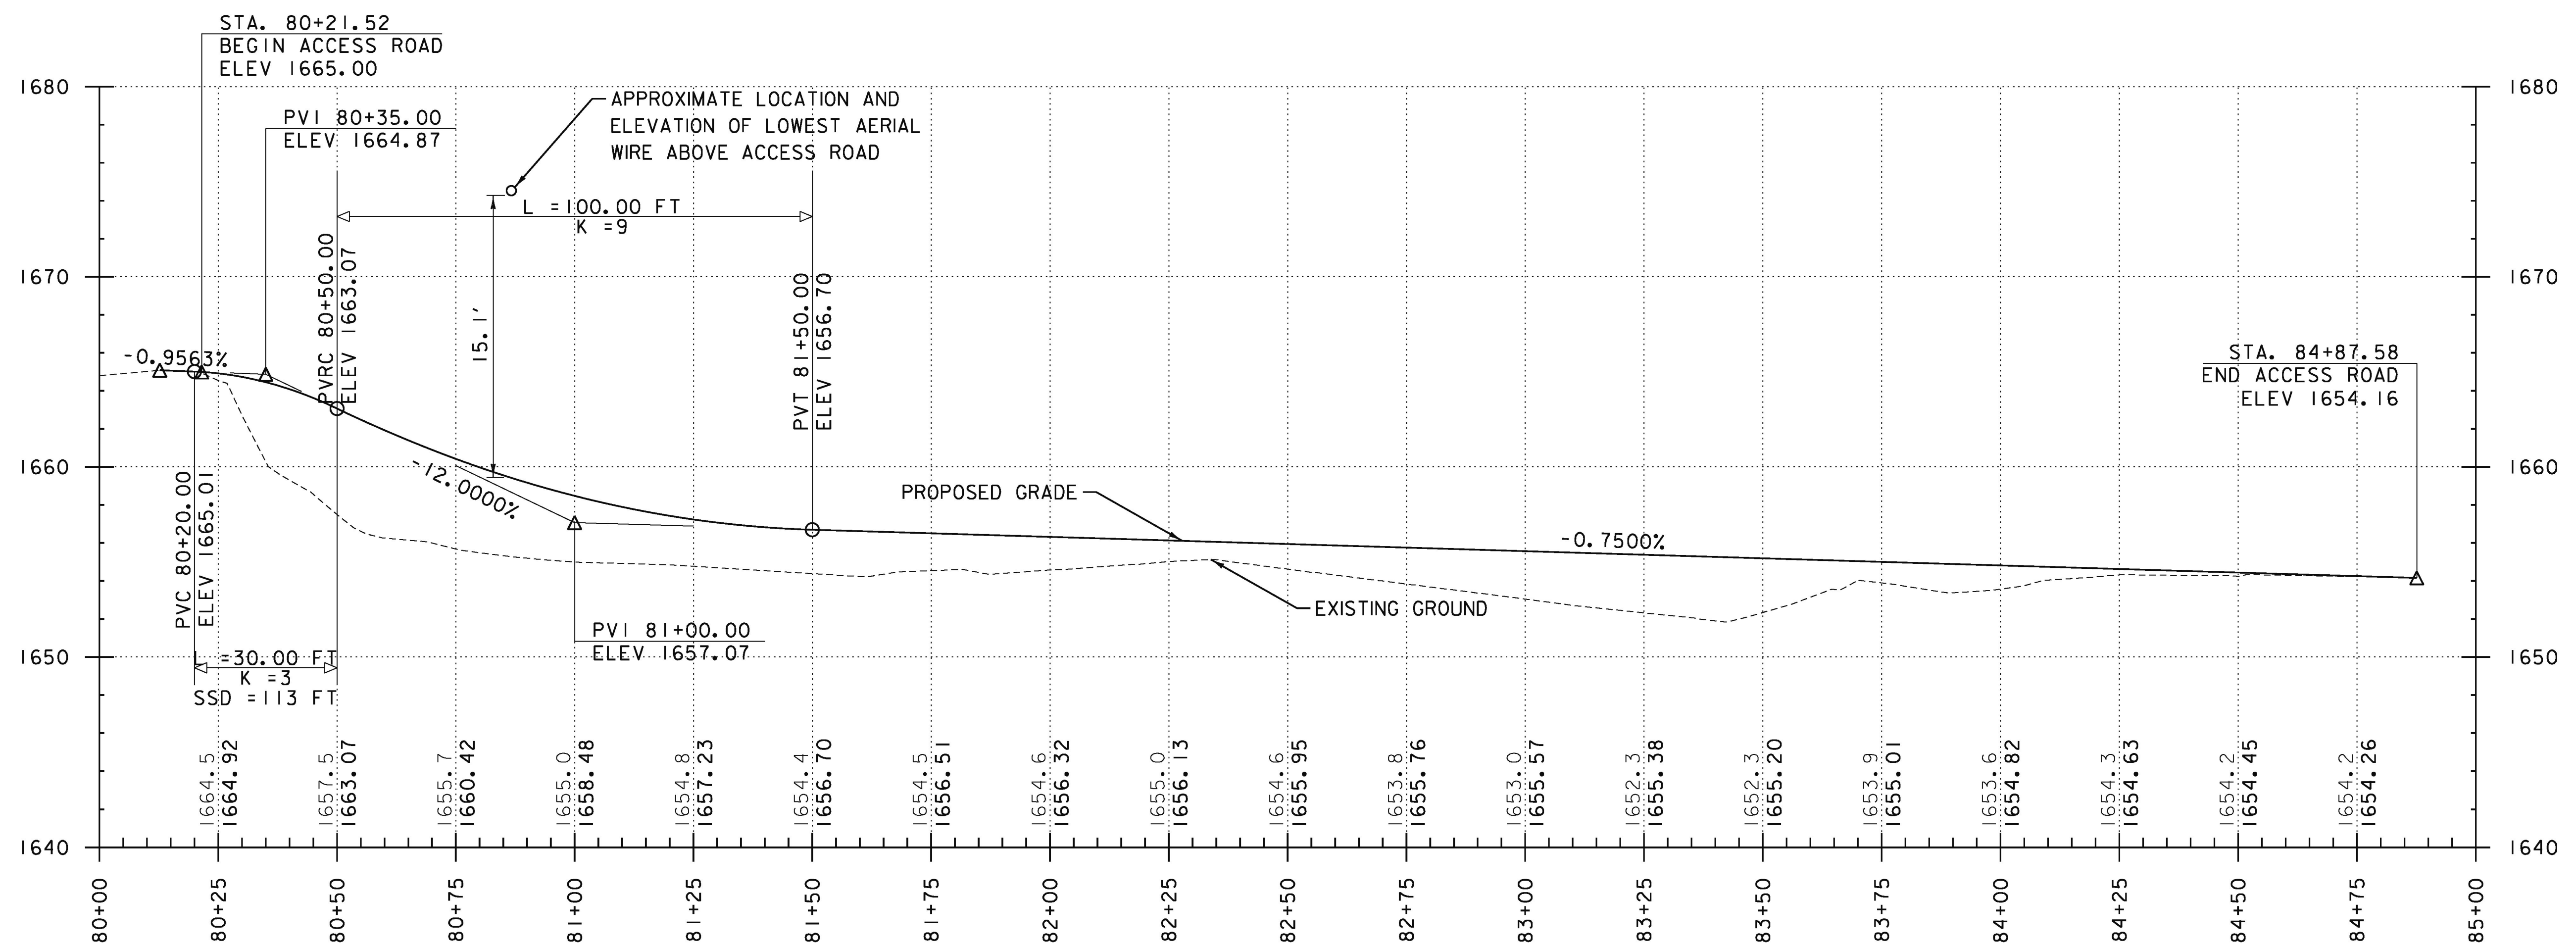

THE GRADES SHOWN TO THE NEAREST TENTH ARE THE EXISTING GROUND ELEVATIONS ALONG THE NEW ALIGNMENT. THE GRADES SHOWN TO THE NEAREST HUNDREDTH ARE THE PROPOSED GRADES FOR THE NEW ALIGNMENT.

NOTES:

1. STATIONING & ELEVATION ARE IN FEET
2. PROFILE GRADES ARE TO FINAL TOPSOIL SURFACE. SUBTRACT 2" (0.17') FOR TOP OF SUBBASE ELEVATIONS



PROJECT NAME: SEARSBURG
PROJECT NUMBER: NH 010-1(48)

FILE NAME: z12B404xsl.dgn
PROJECT LEADER: E. ATKINS
DESIGNED BY: M. BRADLEY
ACCESS ROAD PROFILE

PLOT DATE: 6/16/2014
DRAWN BY: M. BRADLEY
CHECKED BY: E. ATKINS
SHEET 18 OF 45