

MATCHLINE STA. 22+50
SHEET 1


END PROJECT SEARSBURG NH-010-1 (48)
 POC STA. ~~27+60.00 (MM 3.424)~~ 28+50
 END EMBANKMENT RECONSTRUCTION (MM 3.407)

LEGEND

- SOIL TYPE BOUNDARY
- 300 — 10' INTERVAL CONTOUR
- 2' INTERVAL CONTOUR
- EXIST. PROPERTY/ROW LINE
- — △ — LIMIT OF WORK

SOIL LEGEND

SOIL DESIGNATION	HYDROLOGIC SOIL GROUP CLASSIFICATION	SOIL ERODIBILITY COEFFICIENTS (K)
905D = HOUGHTONVILLE - MONADNOCK ASSOCIATION, HILLY, VERY STONY	B	0.24 - 0.32

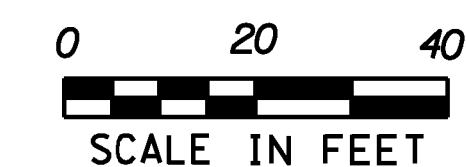

GREEN INTERNATIONAL AFFILIATES, INC.
 CIVIL AND STRUCTURAL ENGINEERS

PROJECT NAME: SEARSBURG	PLOT DATE: 6/16/2014
PROJECT NUMBER: NH 010-1(48)	DRAWN BY: A. ACHARYA
FILE NAME: z12B404ecbdr.dgn	CHECKED BY: E. ATKINS
PROJECT LEADER: E. ATKINS	SHEET 21 OF 45
DESIGNED BY: A. ACHARYA	
EPSC EXISTING CONDITIONS PLAN SHEET 2	