
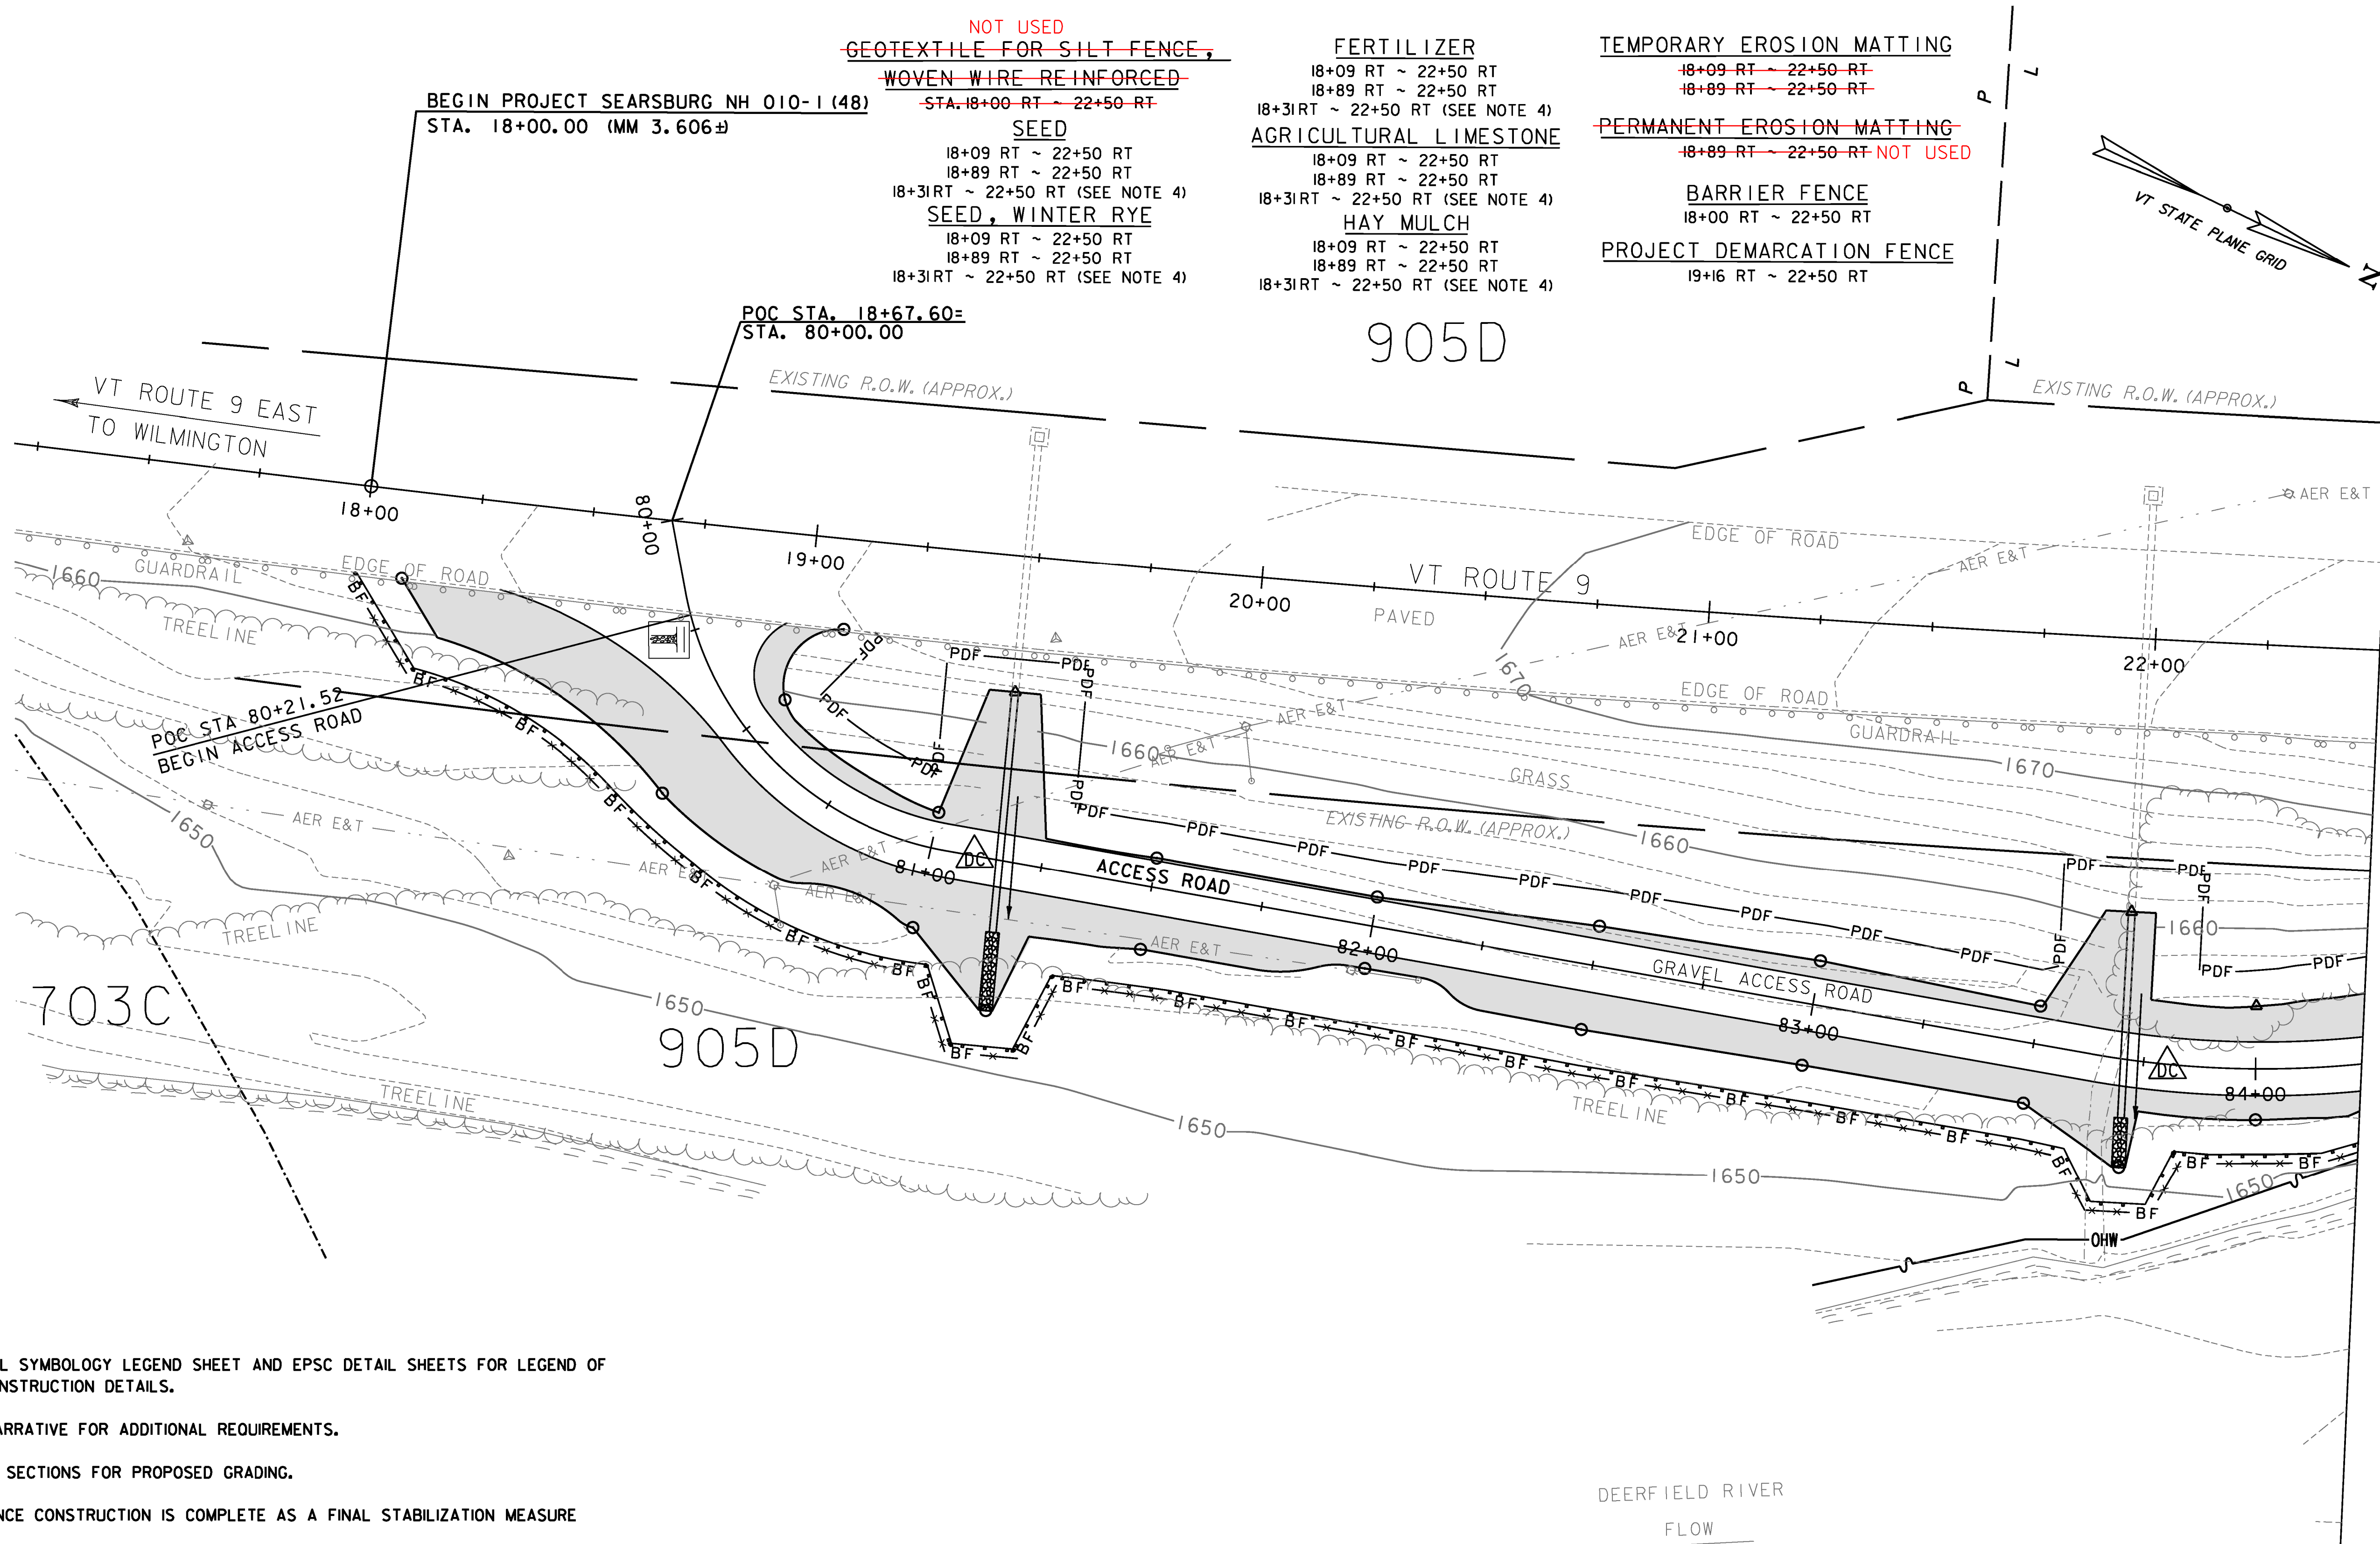


~~NOT USED~~
~~GEOTEXTILE FOR SILT FENCE,~~
~~WOVEN WIRE REINFORCED~~
~~STA. 18+00-RT ~ 22+50-RT~~

SEED
 18+09 RT ~ 22+50 RT
 18+89 RT ~ 22+50 RT
 18+31RT ~ 22+50 RT (SEE NOTE 4)
SEED, WINTER RYE
 18+09 RT ~ 22+50 RT
 18+89 RT ~ 22+50 RT
 18+31RT ~ 22+50 RT (SEE NOTE 4)

FERTILIZER
 18+09 RT ~ 22+50 RT
 18+89 RT ~ 22+50 RT
 18+31RT ~ 22+50 RT (SEE NOTE 4)
AGRICULTURAL LIMESTONE
 18+09 RT ~ 22+50 RT
 18+89 RT ~ 22+50 RT
 18+31RT ~ 22+50 RT (SEE NOTE 4)
HAY MULCH
 18+09 RT ~ 22+50 RT
 18+89 RT ~ 22+50 RT
 18+31RT ~ 22+50 RT (SEE NOTE 4)

TEMPORARY EROSION MATTING
~~18+09 RT ~ 22+50 RT~~
~~18+89 RT ~ 22+50 RT~~
PERMANENT EROSION MATTING
~~18+89 RT ~ 22+50 RT NOT USED~~
BARRIER FENCE
 18+00 RT ~ 22+50 RT
PROJECT DEMARCATION FENCE
 19+16 RT ~ 22+50 RT

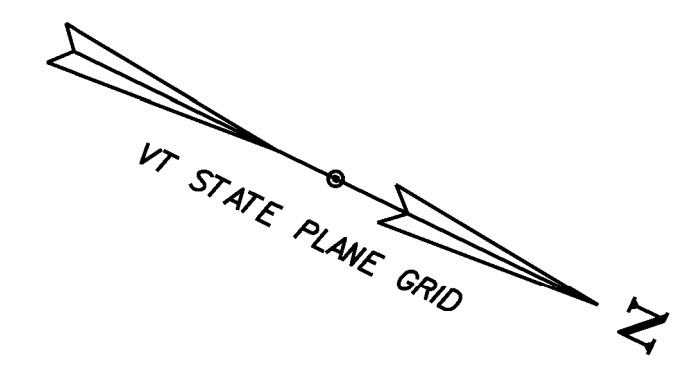

905D

703C

MATCH LINE STA. 22+50 SHEET 2

- NOTES:**
1. SEE CONVENTIONAL SYMBOLY LEGEND SHEET AND EPSC DETAIL SHEETS FOR LEGEND OF SYMBOLS AND CONSTRUCTION DETAILS.
 2. SEE THE EPSC NARRATIVE FOR ADDITIONAL REQUIREMENTS.
 3. REFER TO CROSS SECTIONS FOR PROPOSED GRADING.
 4. TO BE PLACED ONCE CONSTRUCTION IS COMPLETE AS A FINAL STABILIZATION MEASURE

LEGEND	
	SOIL TYPE BOUNDARY
	10' INTERVAL CONTOUR
	2' INTERVAL CONTOUR
	EXIST. PROPERTY/ROW LINE
	LIMIT OF WORK

DEERFIELD RIVER
 FLOW



GREEN INTERNATIONAL AFFILIATES, INC.
 CIVIL AND STRUCTURAL ENGINEERS

PROJECT NAME: SEARSBURG	PLOT DATE: 6/16/2014
PROJECT NUMBER: NH 010-1(48)	DRAWN BY: A. ACHARYA
FILE NAME: z12B404ecbdr.dgn	CHECKED BY: E. ATKINS
PROJECT LEADER: E. ATKINS	SHEET 22 OF 45
DESIGNED BY: A. ACHARYA	
EPSC CONSTRUCTION PLAN SHEET 1	