


22+75

BUILT ESSENTIALLY
AS SHOWN

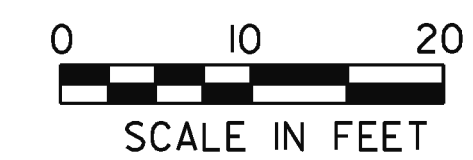

GREEN INTERNATIONAL AFFILIATES, INC.
CIVIL AND STRUCTURAL ENGINEERS

STA. 22+75	
PROJECT NAME:	SEARSBURG
PROJECT NUMBER:	NH 010-1(48)
FILE NAME:	z12B404xsl.dgn
PROJECT LEADER:	E. ATKINS
DESIGNED BY:	M. BRADLEY
CROSS SECTION SHEET 1	
PLOT DATE:	6/16/2014
DRAWN BY:	M. BRADLEY
CHECKED BY:	E. ATKINS
SHEET	29 OF 45