



23+25

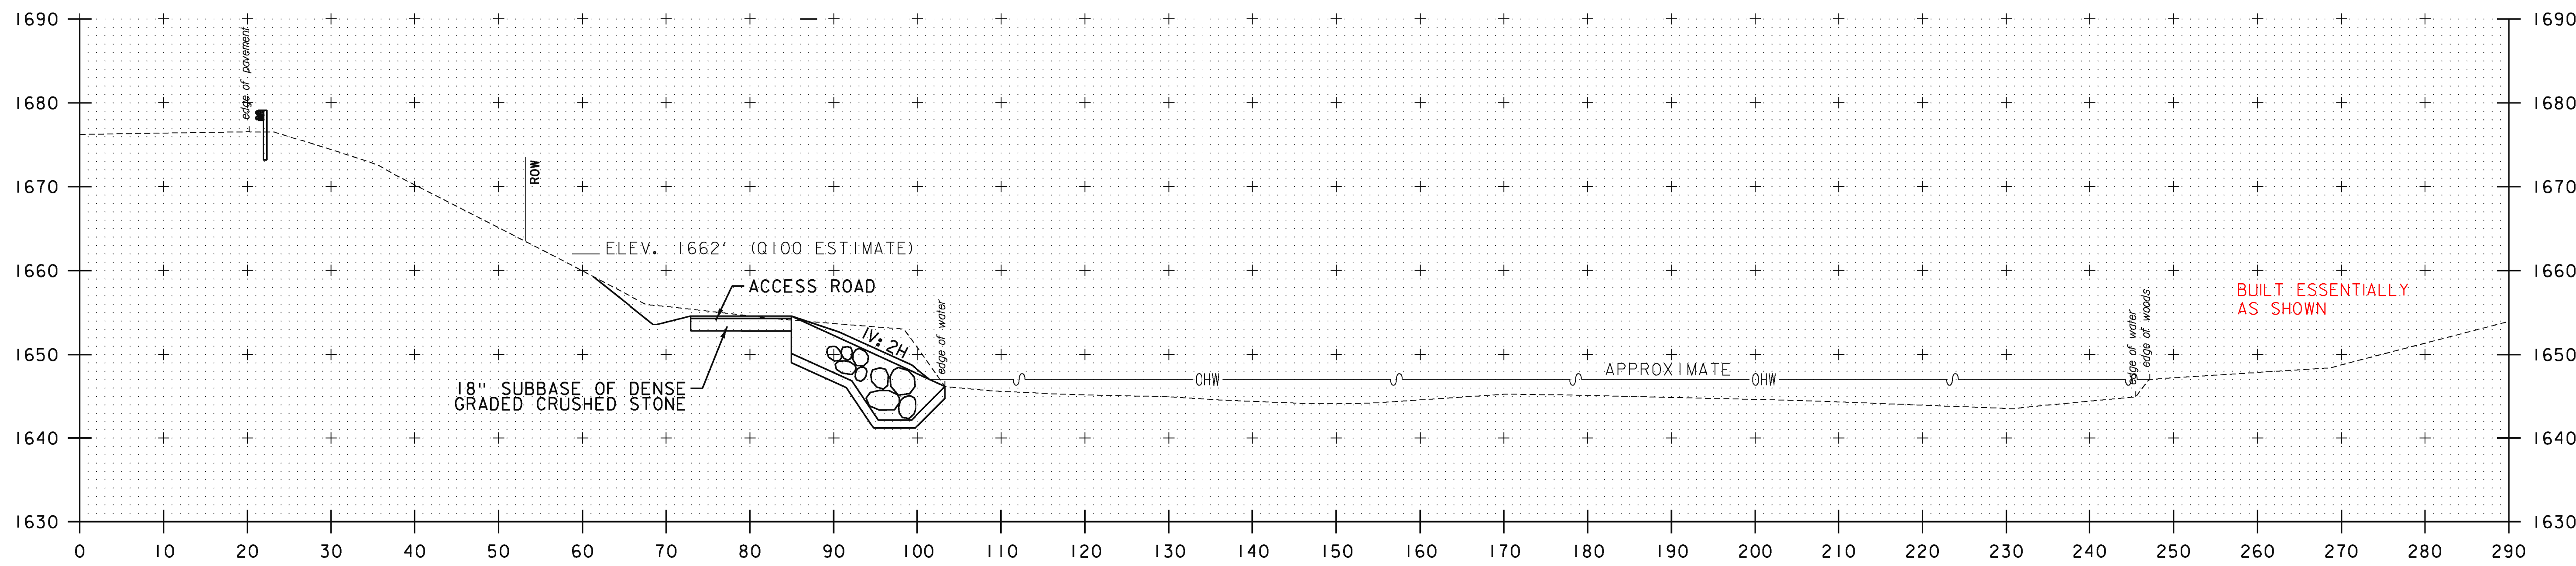

23+00  
BEG IN EMBANKMENT RECONSTRUCTION

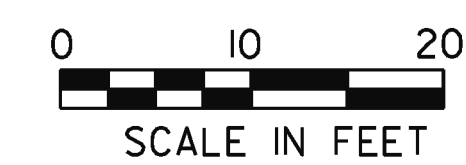

GREEN INTERNATIONAL AFFILIATES, INC.  
CIVIL AND STRUCTURAL ENGINEERS

PROJECT NAME: SEARSBURG		STA. 23+00 TO STA. 23+25	
PROJECT NUMBER: NH 010-I(48)			
FILE NAME: z12B404xsl.dgn	DESIGNED BY: M. BRADLEY	CHECKED BY: E. ATKINS	PLOT DATE: 6/16/2014
PROJECT LEADER: E. ATKINS	CROSS SECTION SHEET 2		DRAWN BY: M. BRADLEY
			SHEET 30 OF 45