



23+75

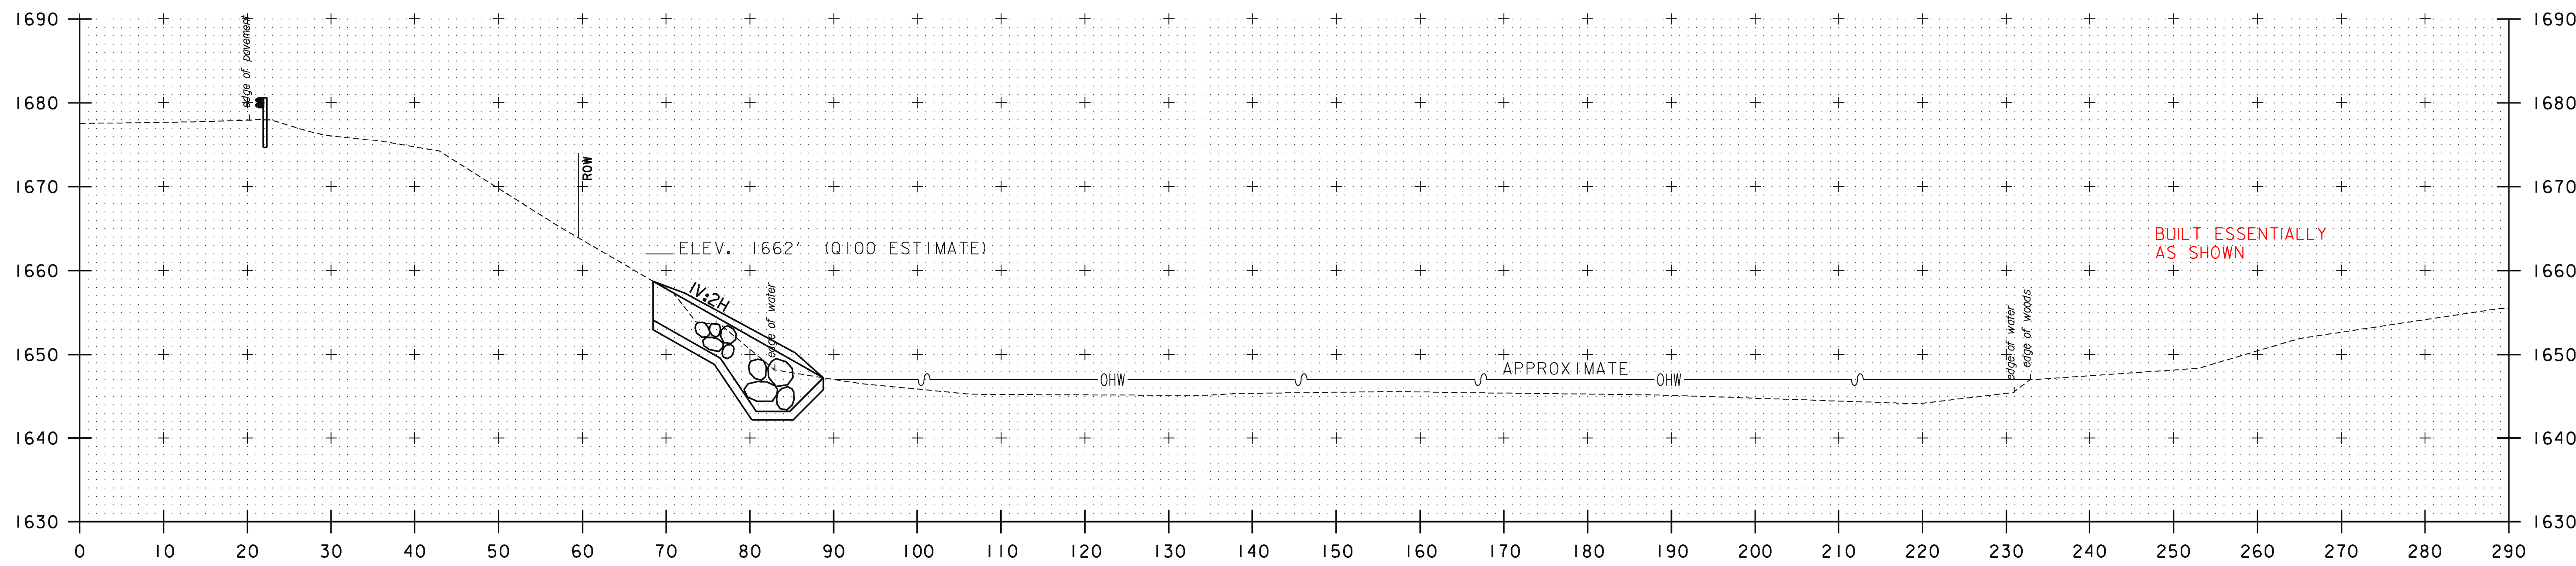

23+50

STA. 23+50 TO STA. 23+75

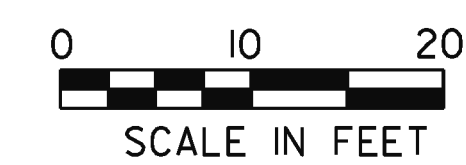

GREEN INTERNATIONAL AFFILIATES, INC.  
CIVIL AND STRUCTURAL ENGINEERS

PROJECT NAME:	SEARSBURG	FILE NAME:	z12B404xsl.dgn	PLOT DATE:	6/16/2014
PROJECT NUMBER:	NH 010-1(48)	PROJECT LEADER:	E. ATKINS	DRAWN BY:	M. BRADLEY
		DESIGNED BY:	M. BRADLEY	CHECKED BY:	E. ATKINS
		CROSS SECTION SHEET 3		SHEET	31 OF 45