



24+75

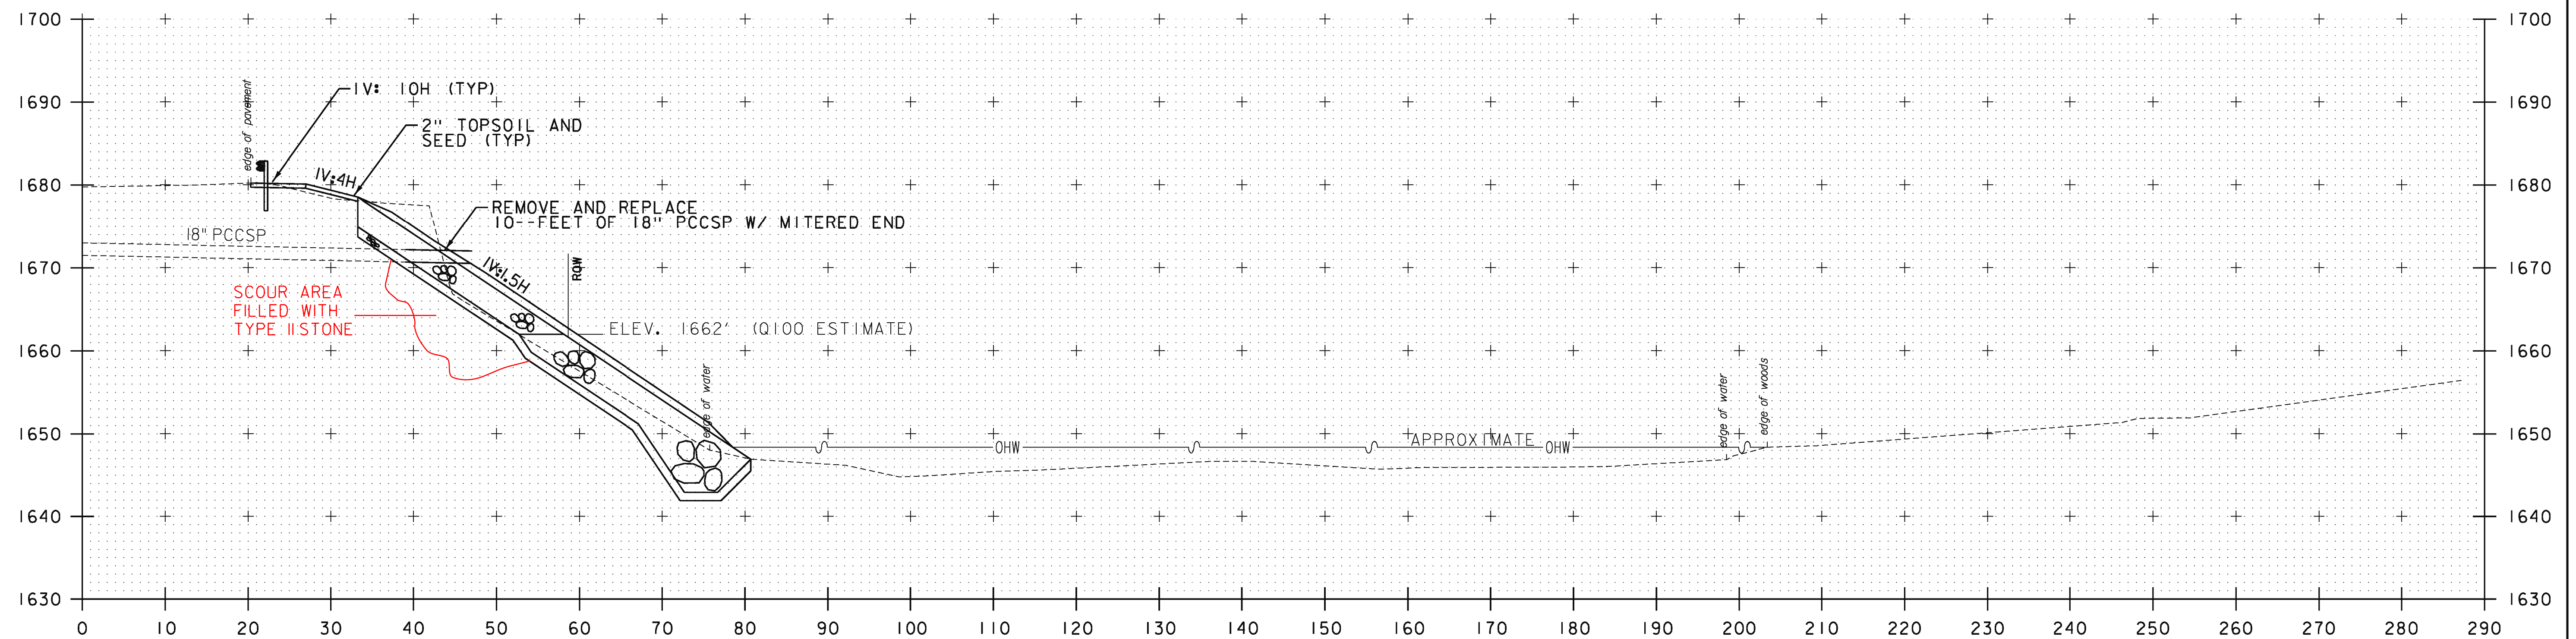

24+50

STA. 24+50 TO STA. 24+75

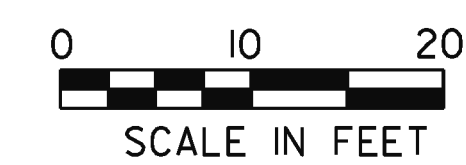

GREEN INTERNATIONAL AFFILIATES, INC.
CIVIL AND STRUCTURAL ENGINEERS

PROJECT NAME: SEARSBURG	PLOT DATE: 6/16/2014
PROJECT NUMBER: NH 010-1(48)	DRAWN BY: M. BRADLEY
FILE NAME: z12B404xsl.dgn	CHECKED BY: E. ATKINS
PROJECT LEADER: E. ATKINS	SHEET 33 OF 45
DESIGNED BY: M. BRADLEY	
CROSS SECTION SHEET 5	