



25+75

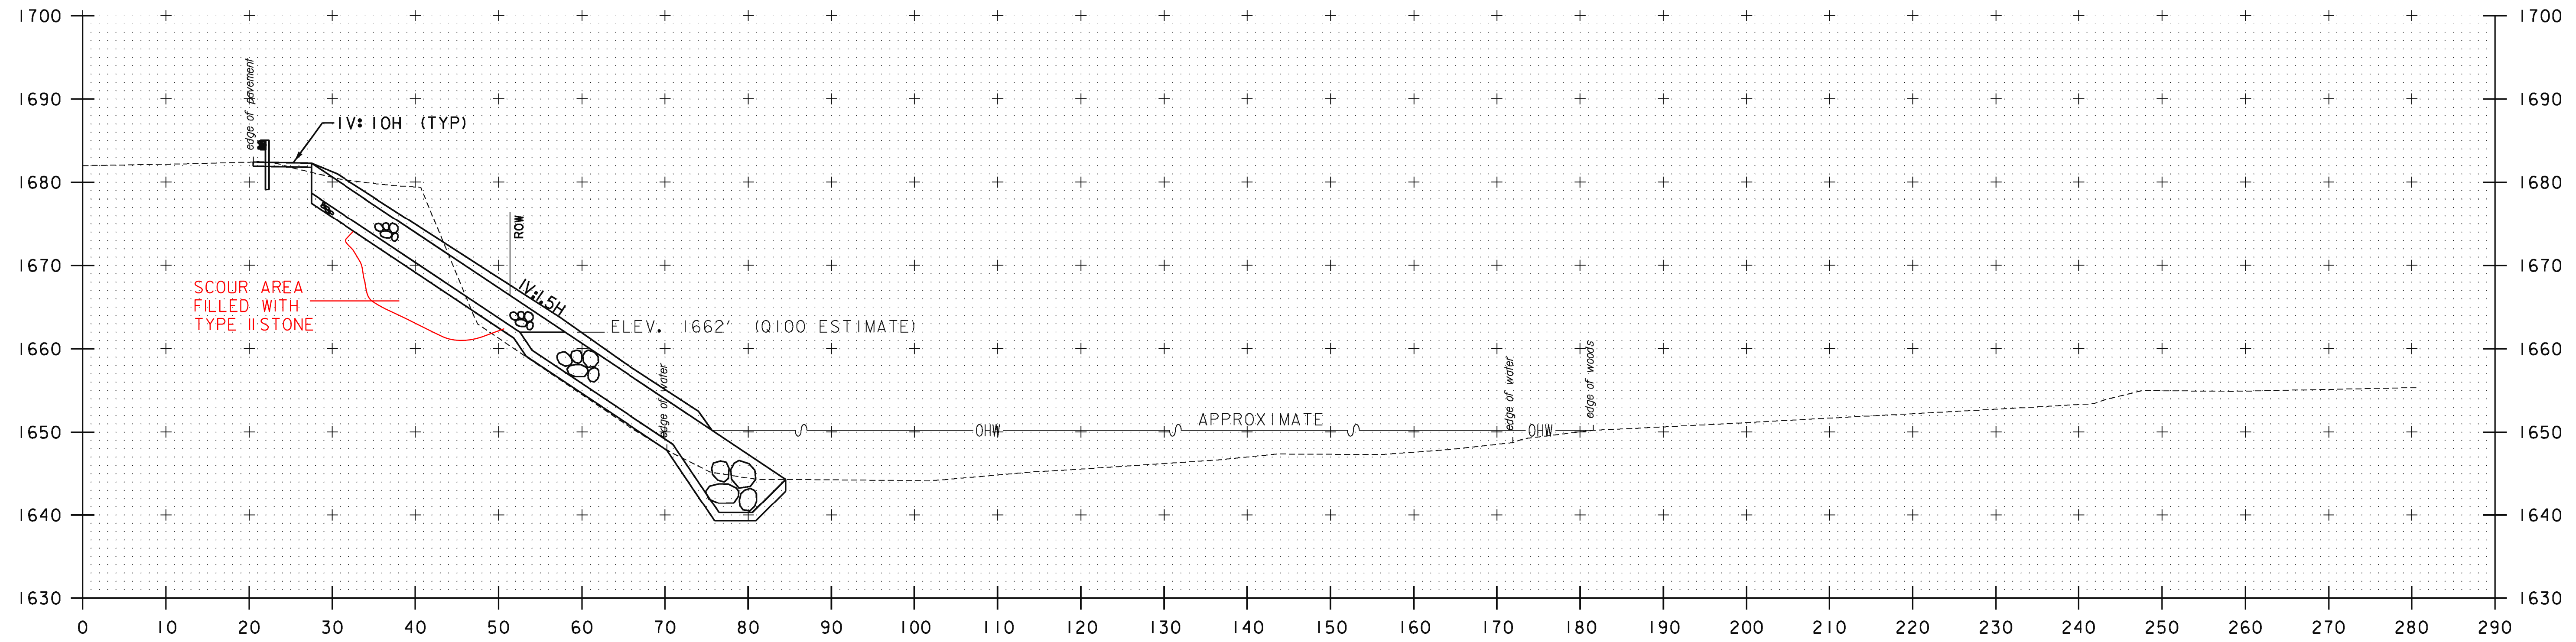

25+50

STA. 25+50 TO STA. 25+75

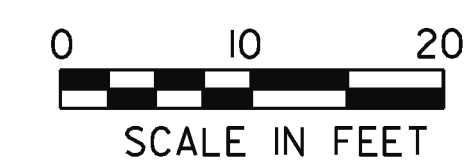

GREEN INTERNATIONAL AFFILIATES, INC.
CIVIL AND STRUCTURAL ENGINEERS

PROJECT NAME: SEARSBURG	
PROJECT NUMBER: NH 010-1(48)	
FILE NAME: z12B404xsl.dgn	PLOT DATE: 6/16/2014
PROJECT LEADER: E. ATKINS	DRAWN BY: M. BRADLEY
DESIGNED BY: M. BRADLEY	CHECKED BY: E. ATKINS
CROSS SECTION SHEET 7	SHEET 35 OF 45