



26+25

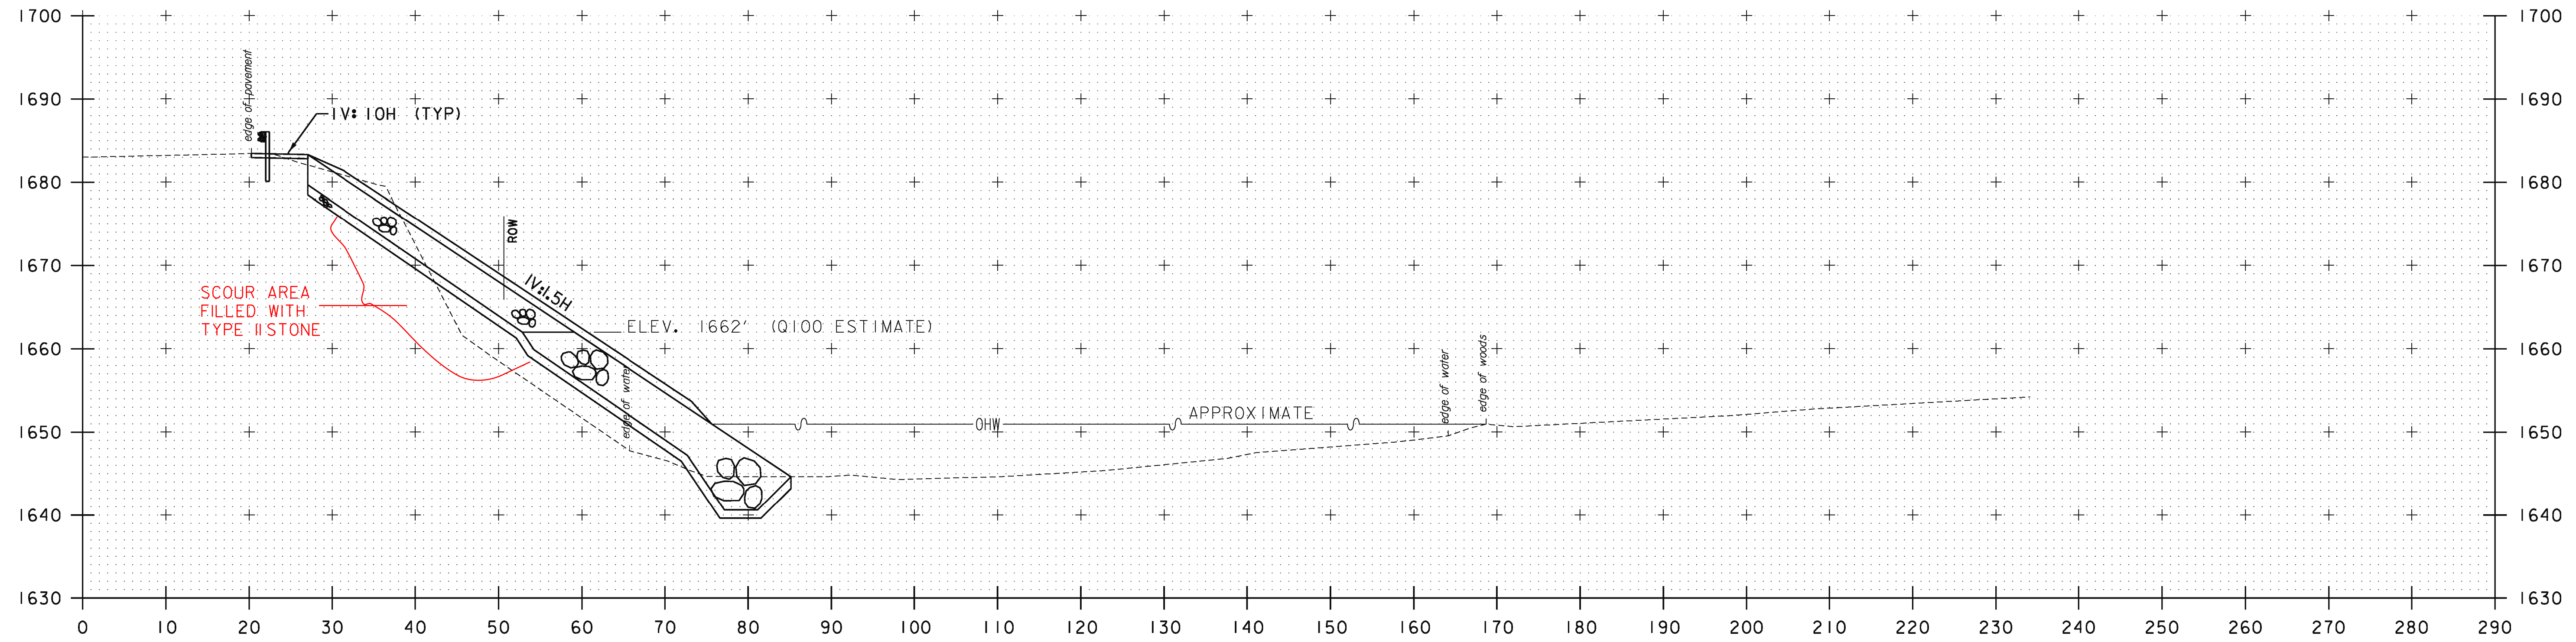

26+00

STA. 26+00 TO STA. 26+25

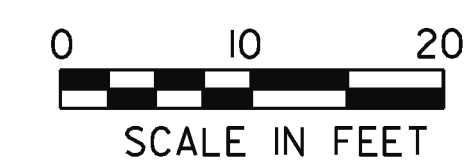

GREEN INTERNATIONAL AFFILIATES, INC.
CIVIL AND STRUCTURAL ENGINEERS

PROJECT NAME: SEARSBURG	FILE NAME: z12B404xsl.dgn	PLOT DATE: 6/16/2014
PROJECT NUMBER: NH 010-I(48)	PROJECT LEADER: E. ATKINS	DRAWN BY: M. BRADLEY
	DESIGNED BY: M. BRADLEY	CHECKED BY: E. ATKINS
	CROSS SECTION SHEET 8	SHEET 36 OF 45