



27+60  
END EMBANKMENT RECONSTRUCTION

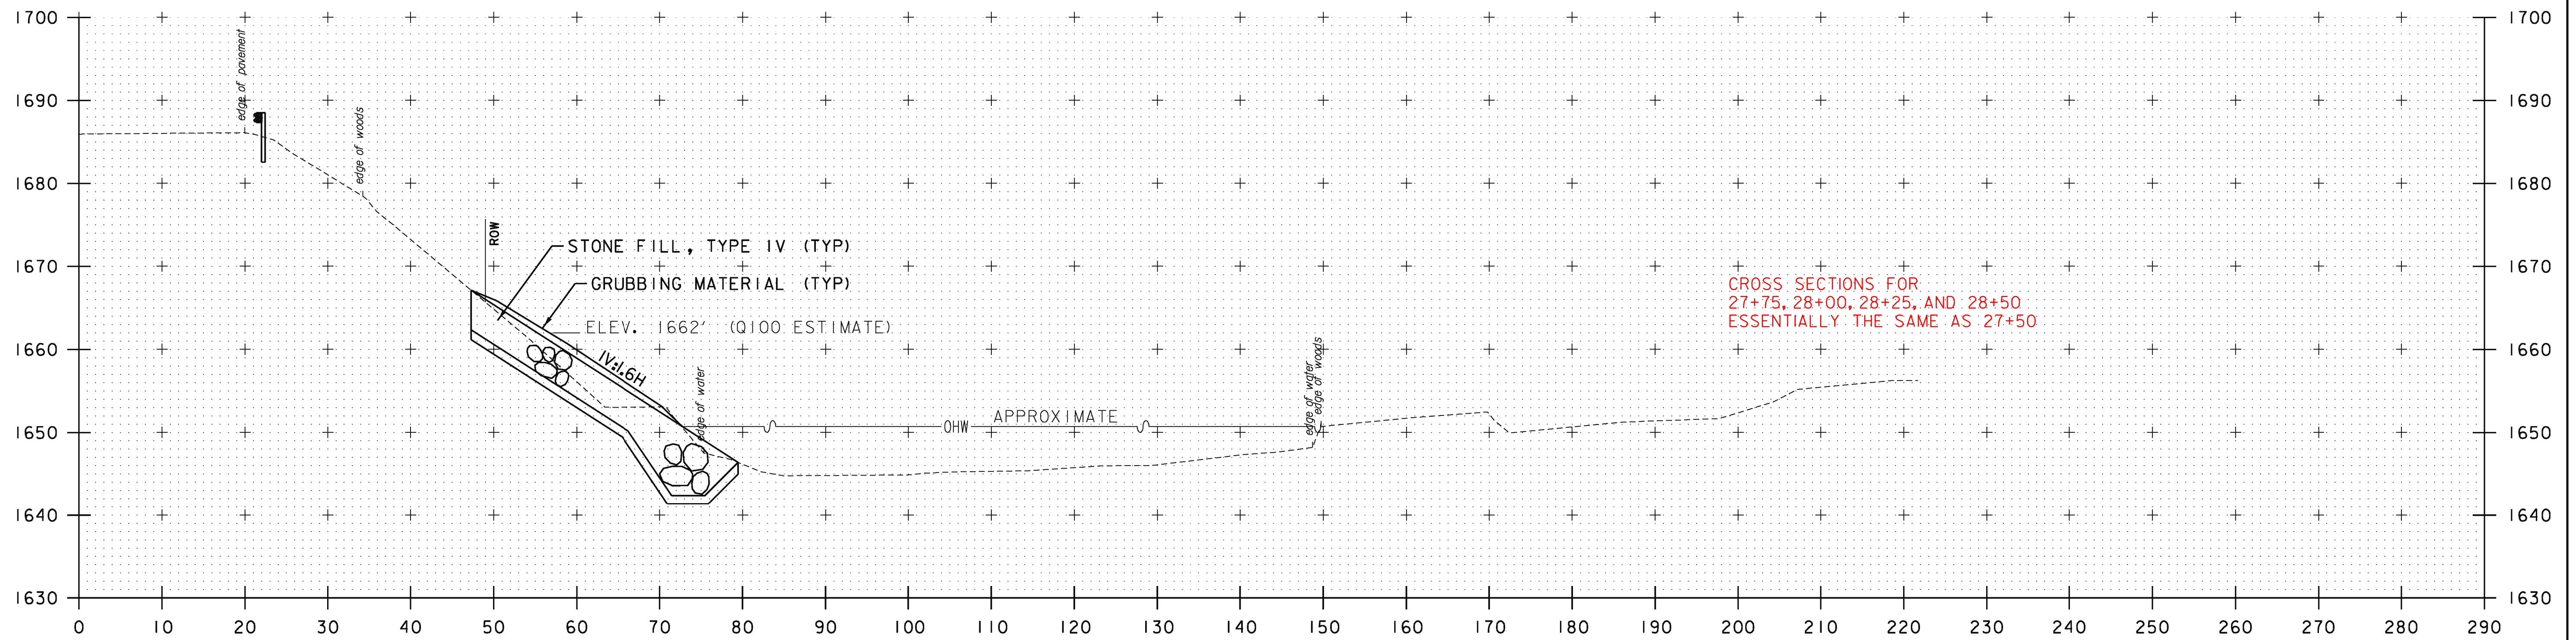

CROSS SECTIONS FOR  
27+75, 28+00, 28+25, AND 28+50  
ESSENTIALLY THE SAME AS 27+50

27+50

STA. 27+50 TO STA. 27+75

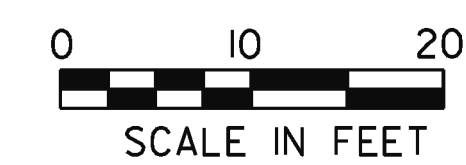

GREEN INTERNATIONAL AFFILIATES, INC.  
CIVIL AND STRUCTURAL ENGINEERS

PROJECT NAME: SEARSBURG	
PROJECT NUMBER: NH 010-I(48)	
FILE NAME: z12B404xsl.dgn	PLOT DATE: 6/16/2014
PROJECT LEADER: E. ATKINS	DRAWN BY: M. BRADLEY
DESIGNED BY: M. BRADLEY	CHECKED BY: E. ATKINS
CROSS SECTION SHEET II	SHEET 39 OF 45