




81+00

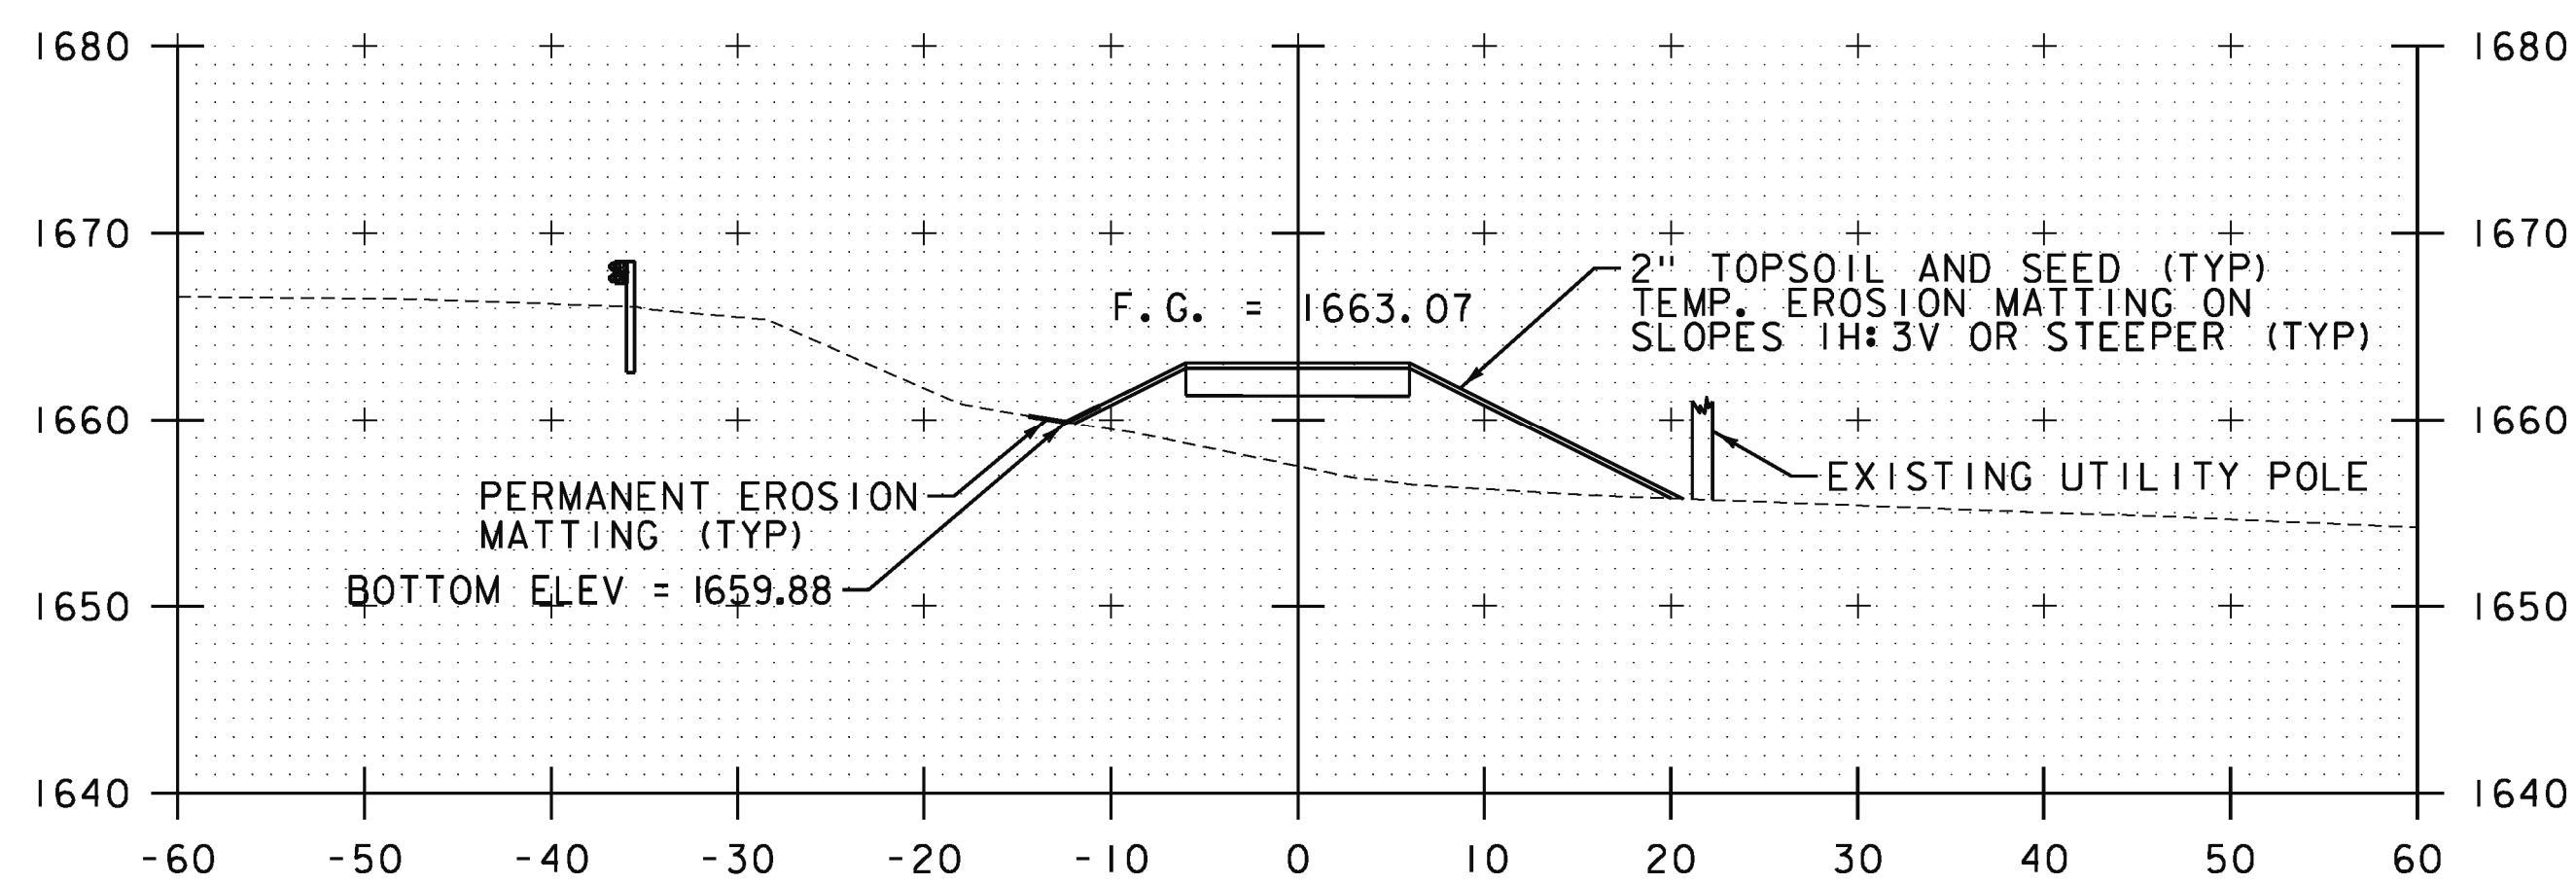


80+50

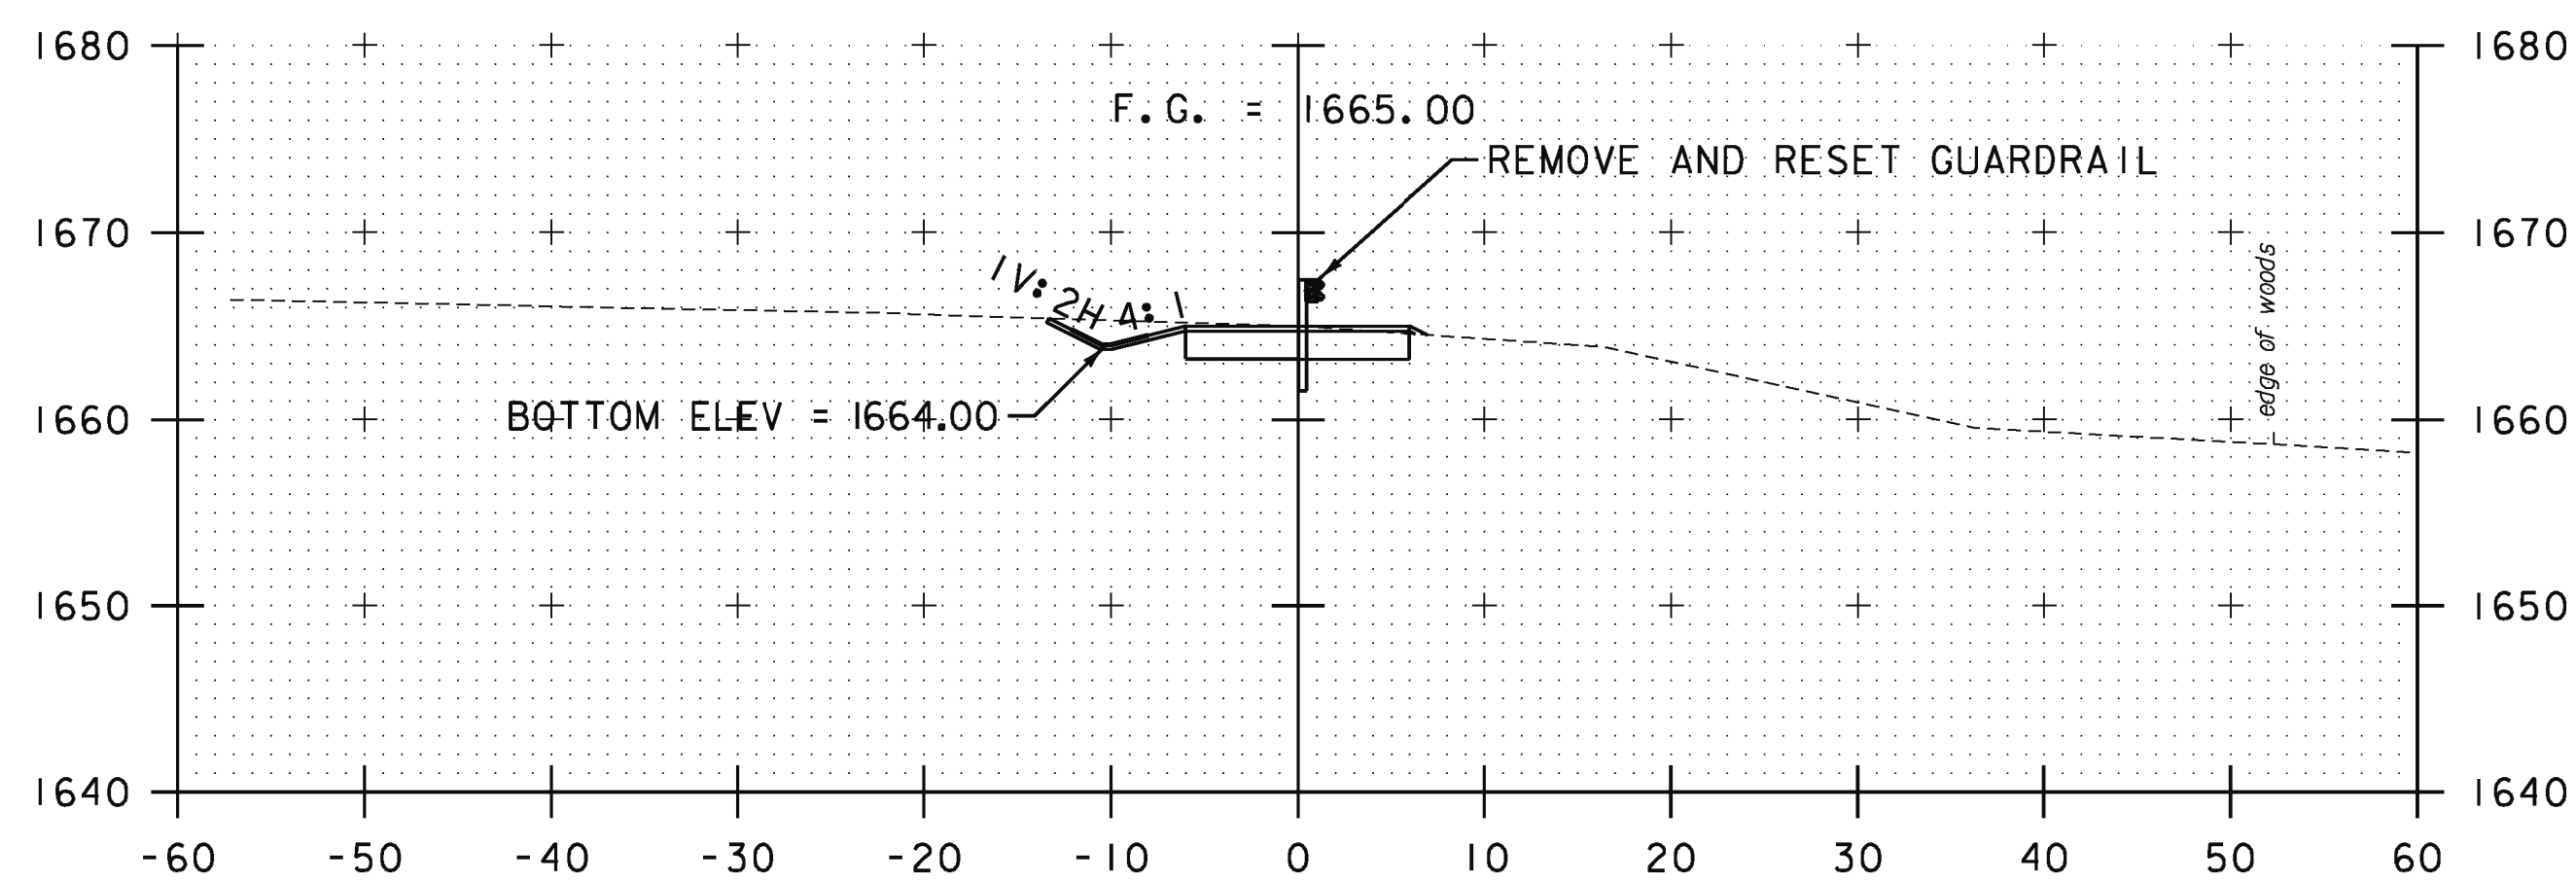

80+21.52  
BEGIN ACCESS ROAD

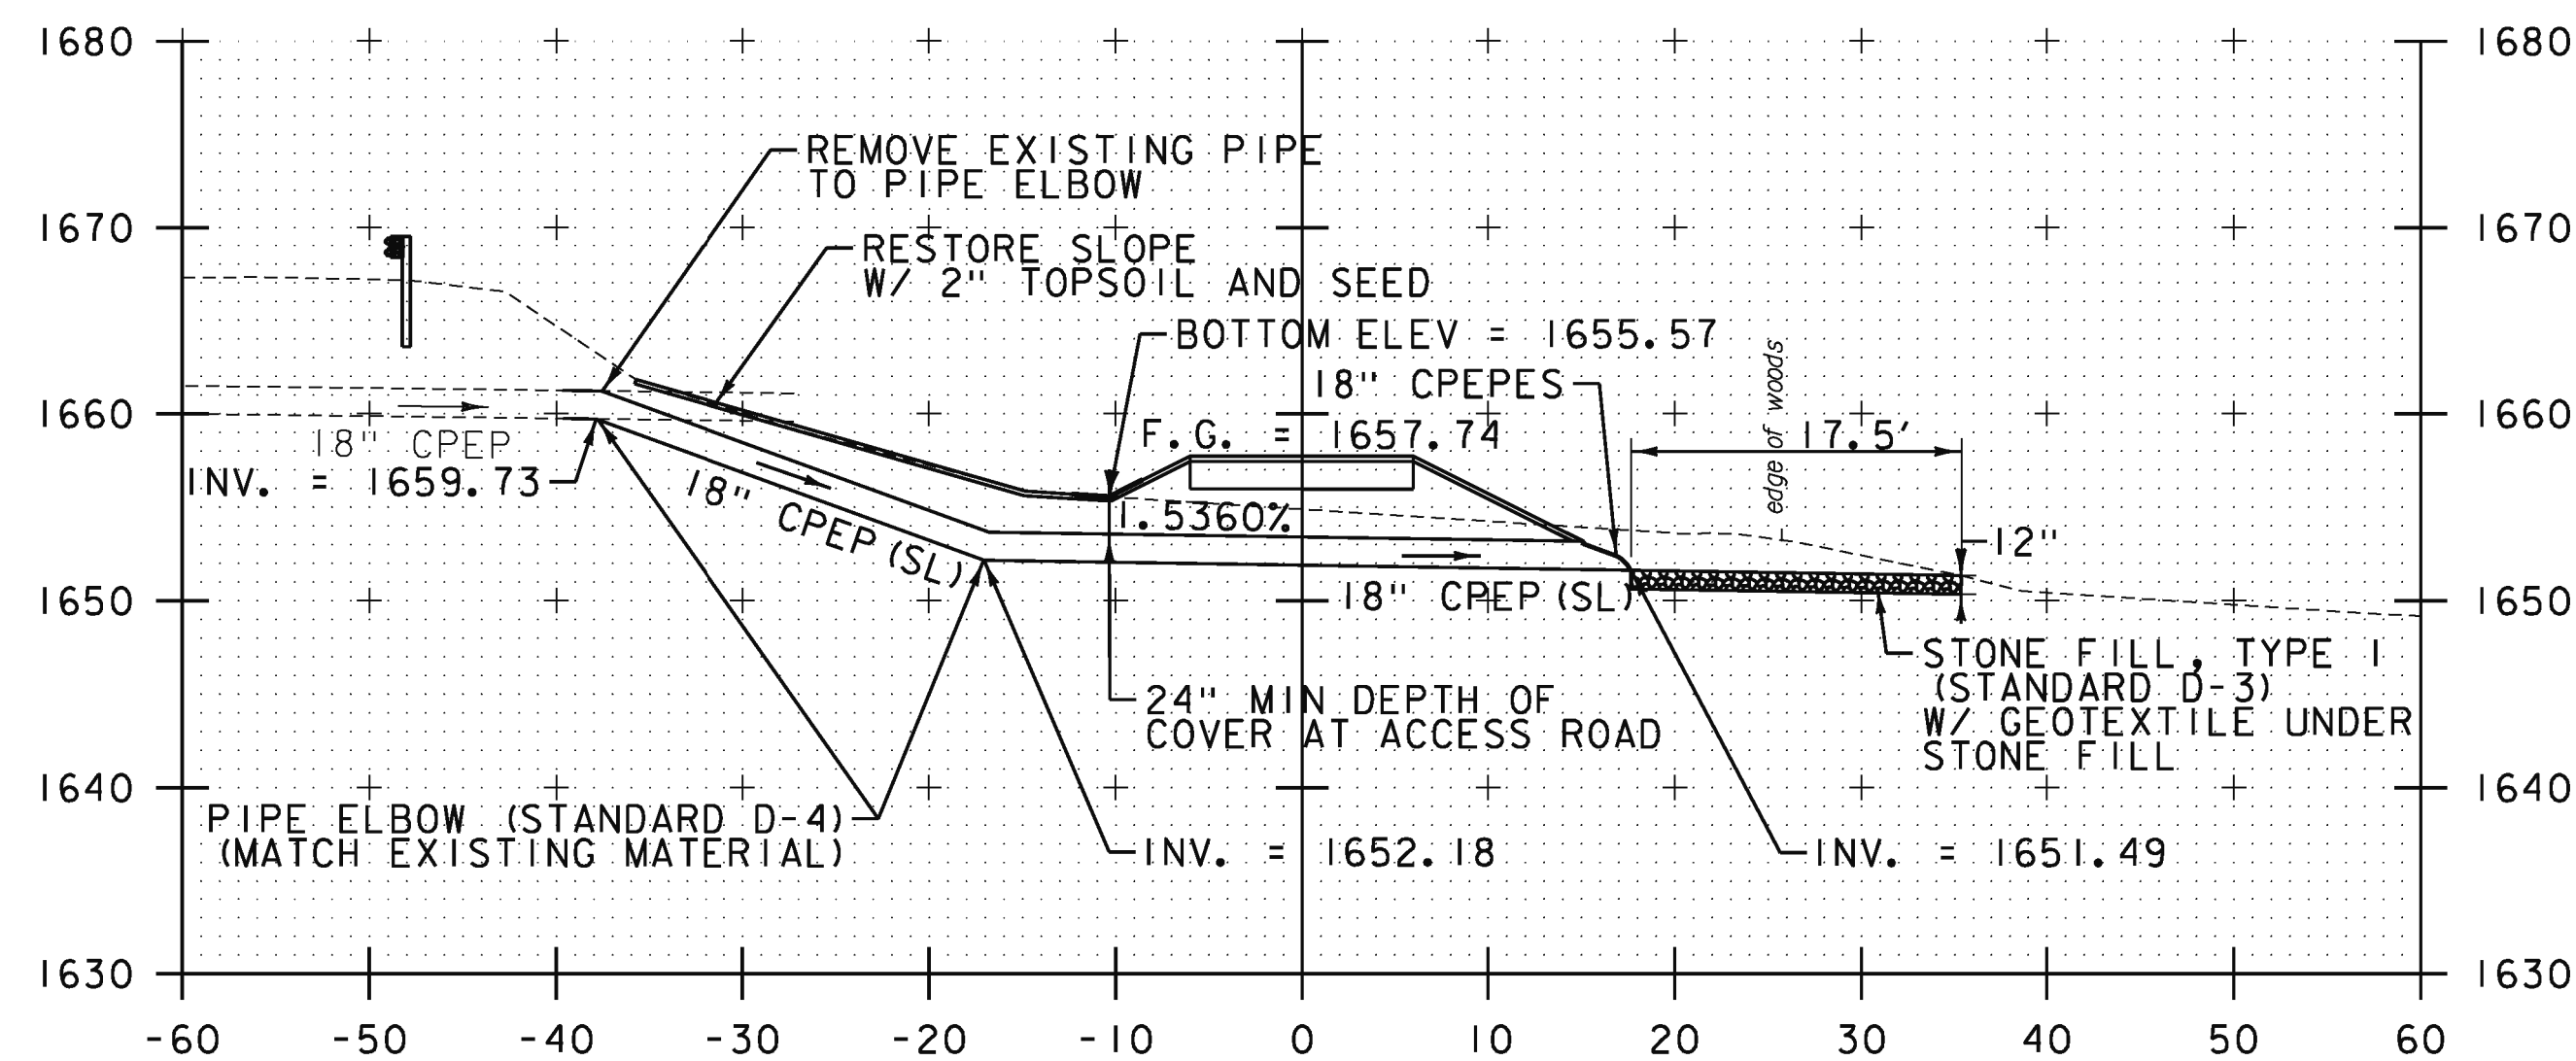

81+13.02 18" CPEP (SL) CULVERT  
SKEWED 85° 17' 58.6" LT

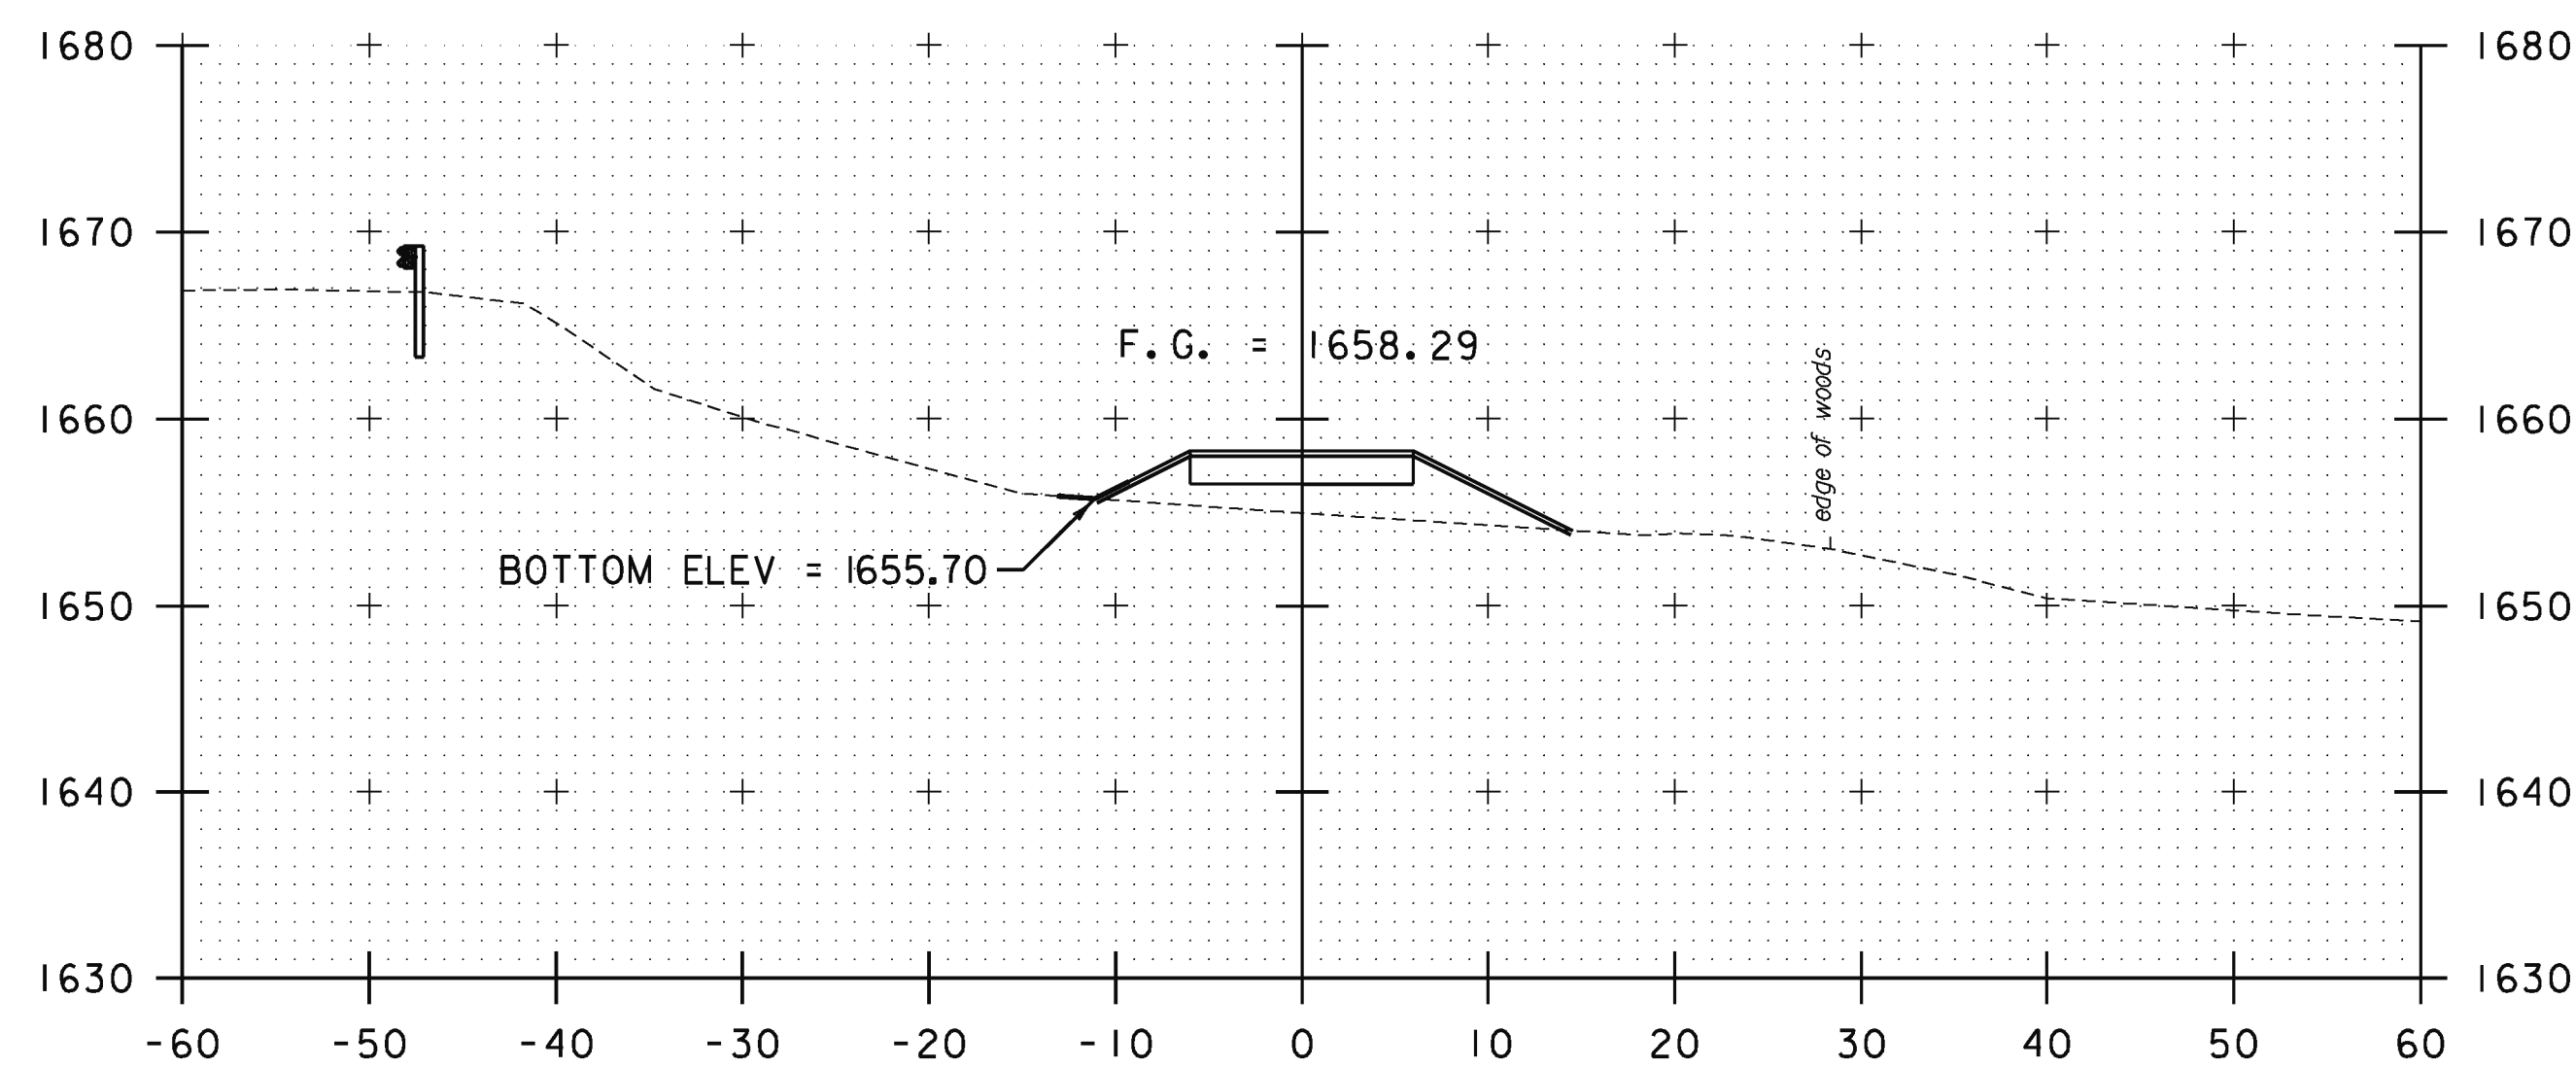

81+03.36 PT

STA. 80+21.52 TO STA. 81+13.02

PROJECT NAME: SEARSBURG  
PROJECT NUMBER: NH 010-1(48)

FILE NAME: z12B404xsl.dgn  
PROJECT LEADER: E. ATKINS  
DESIGNED BY: M. BRADLEY  
CROSS SECTION SHEET 12

PLOT DATE: 6/16/2014  
DRAWN BY: M. BRADLEY  
CHECKED BY: E. ATKINS  
SHEET 40 OF 45

BUILT  
ESSENTIALLY  
AS SHOWN