




82+00

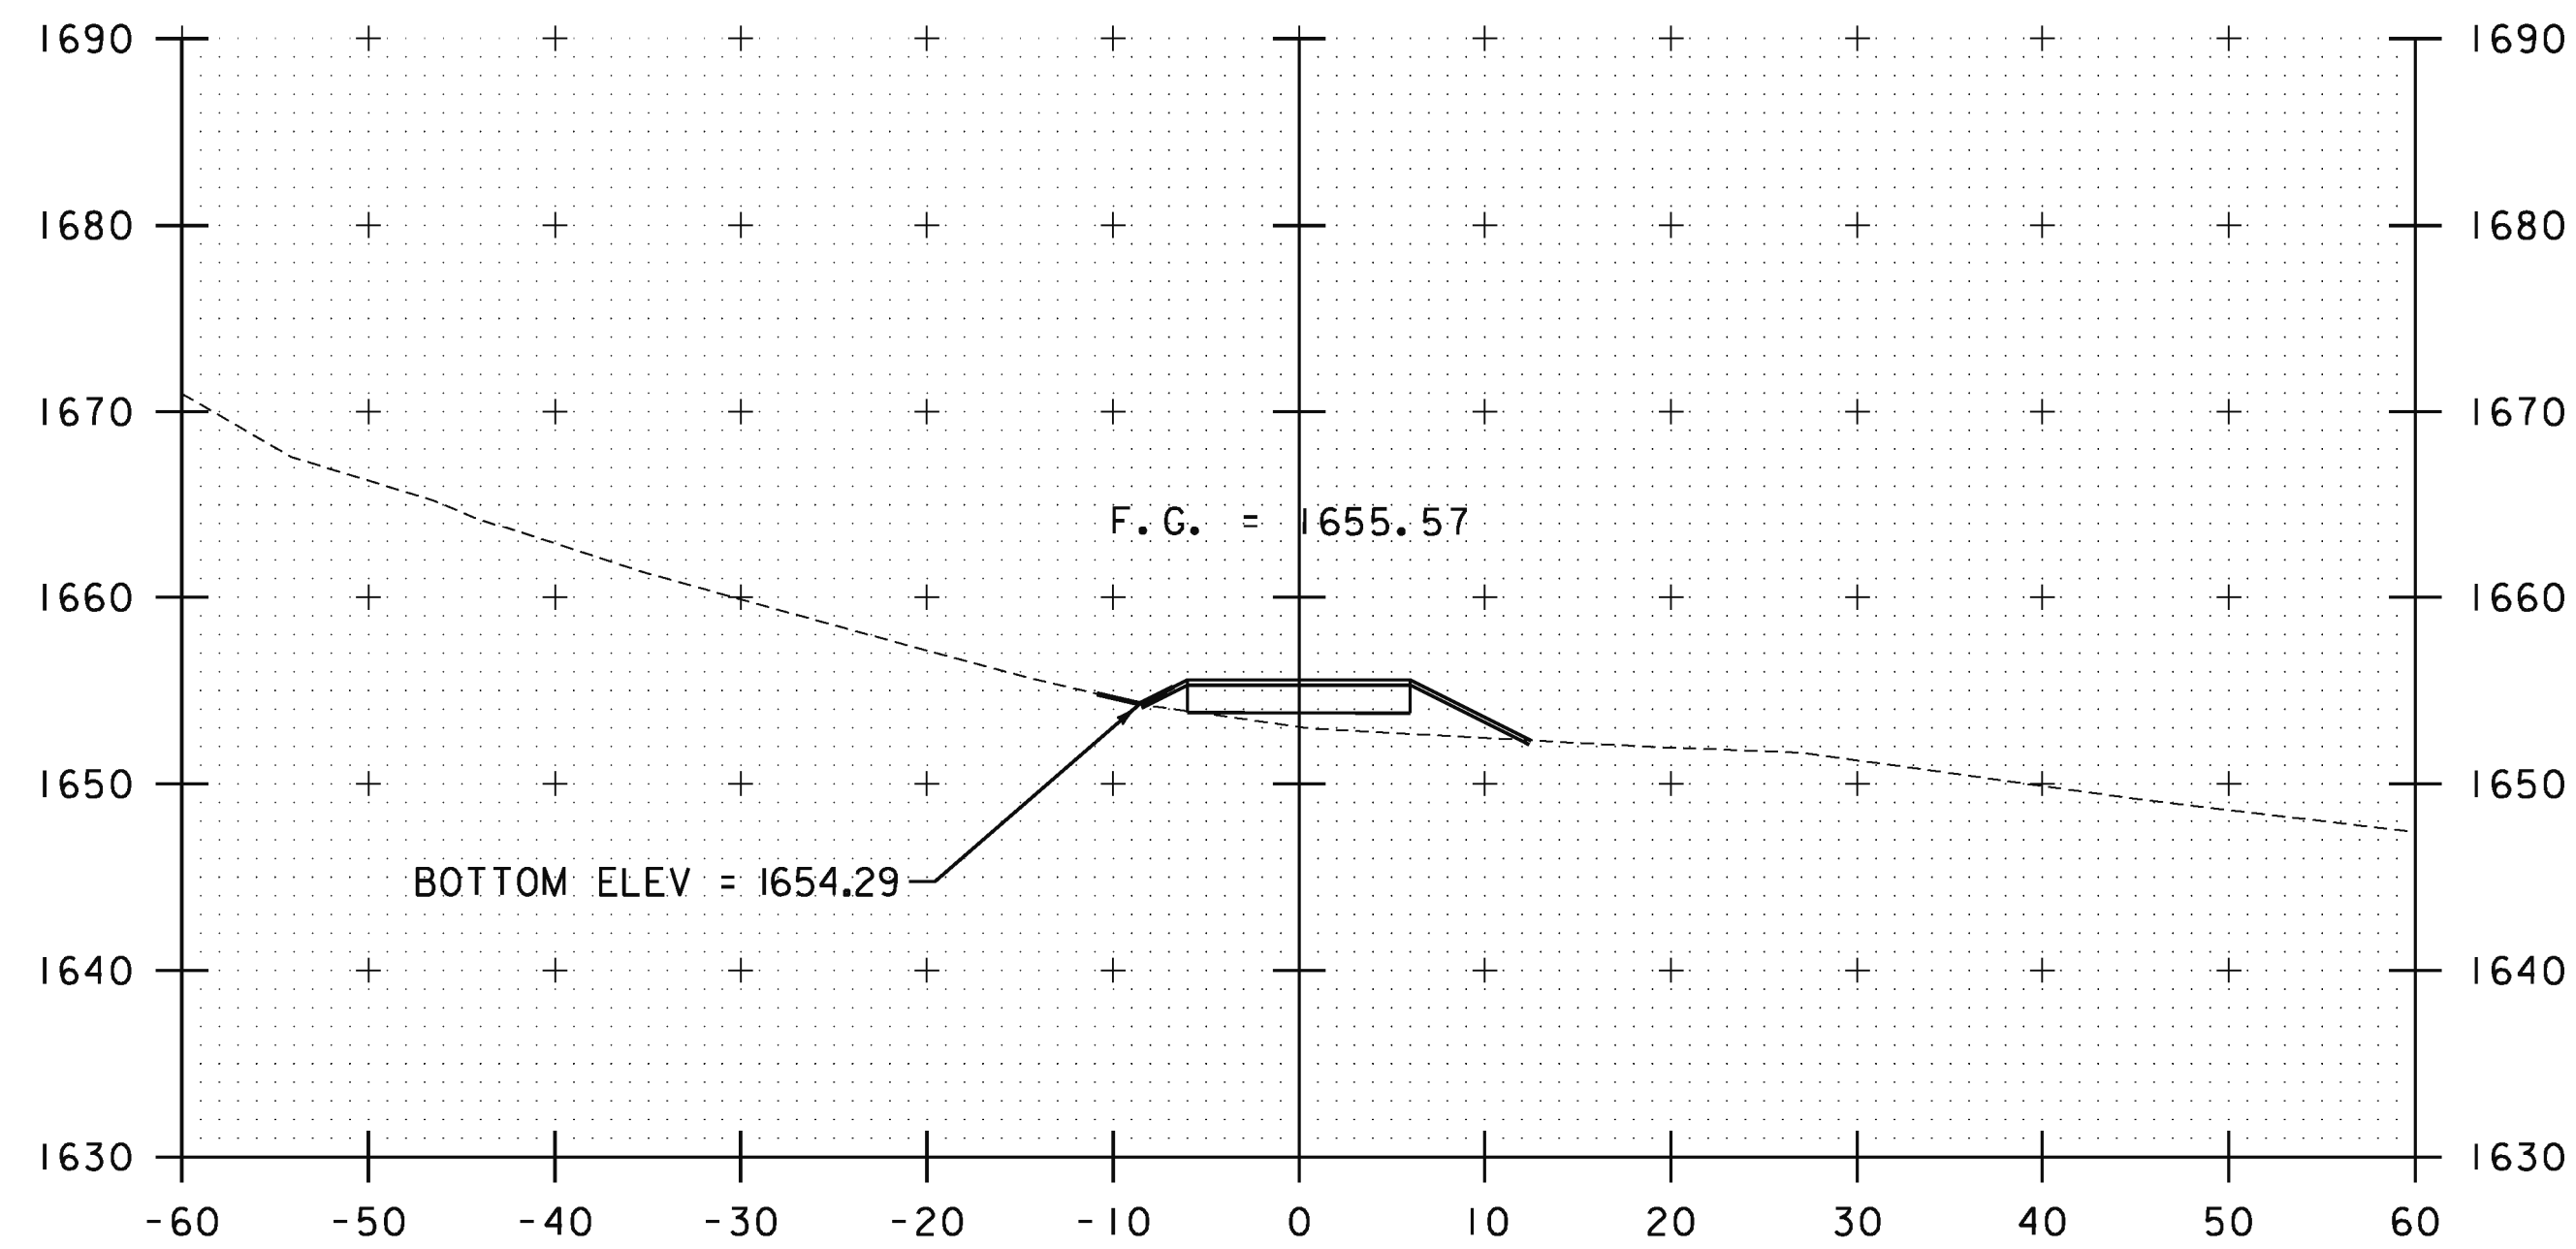

83+00

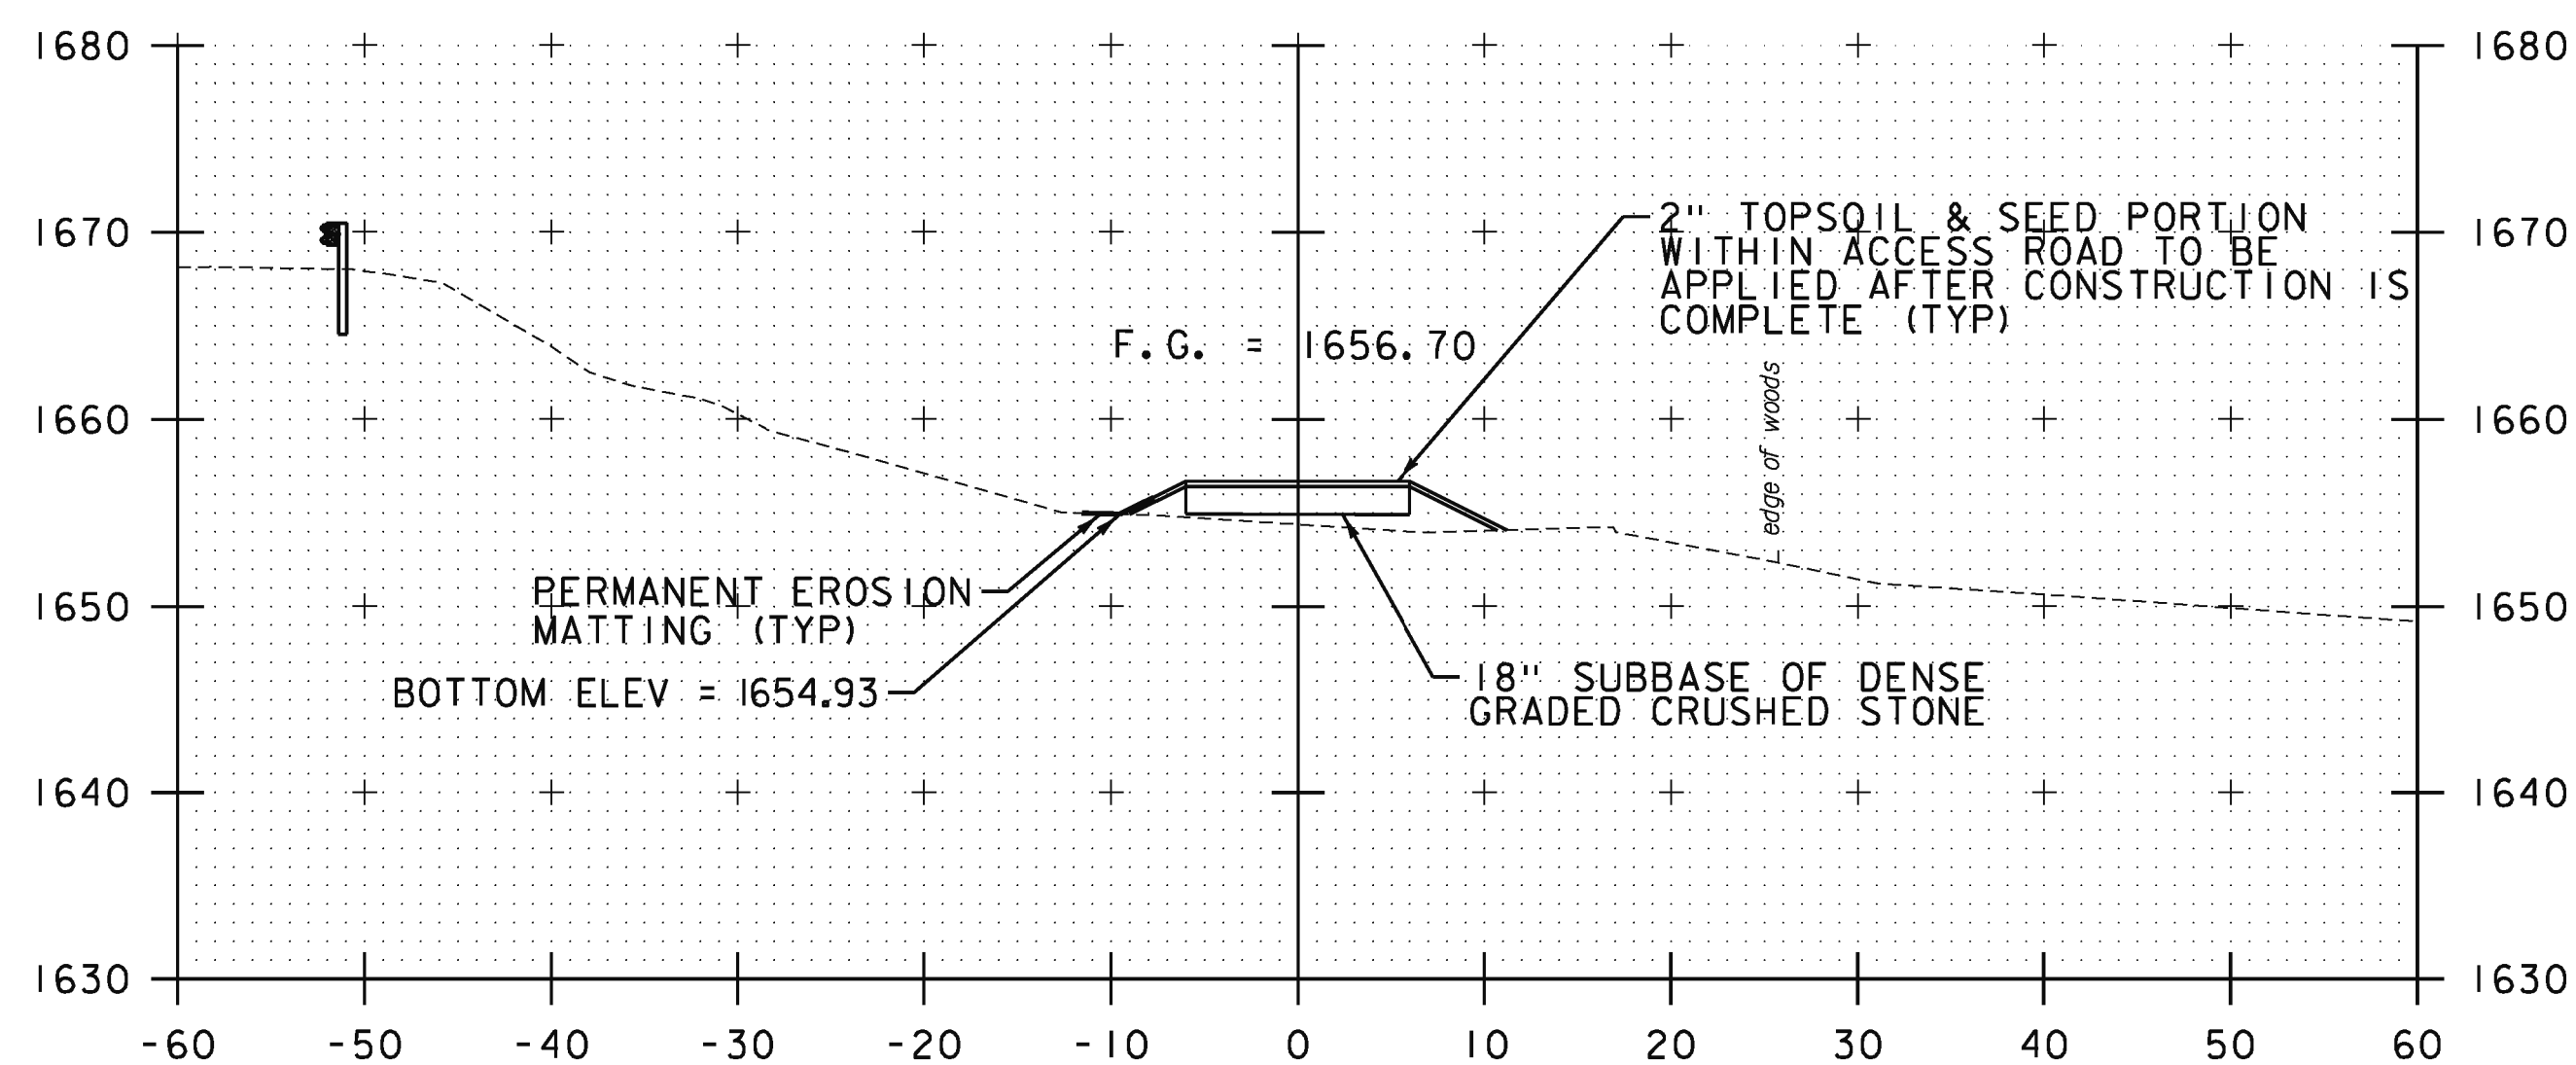

81+50

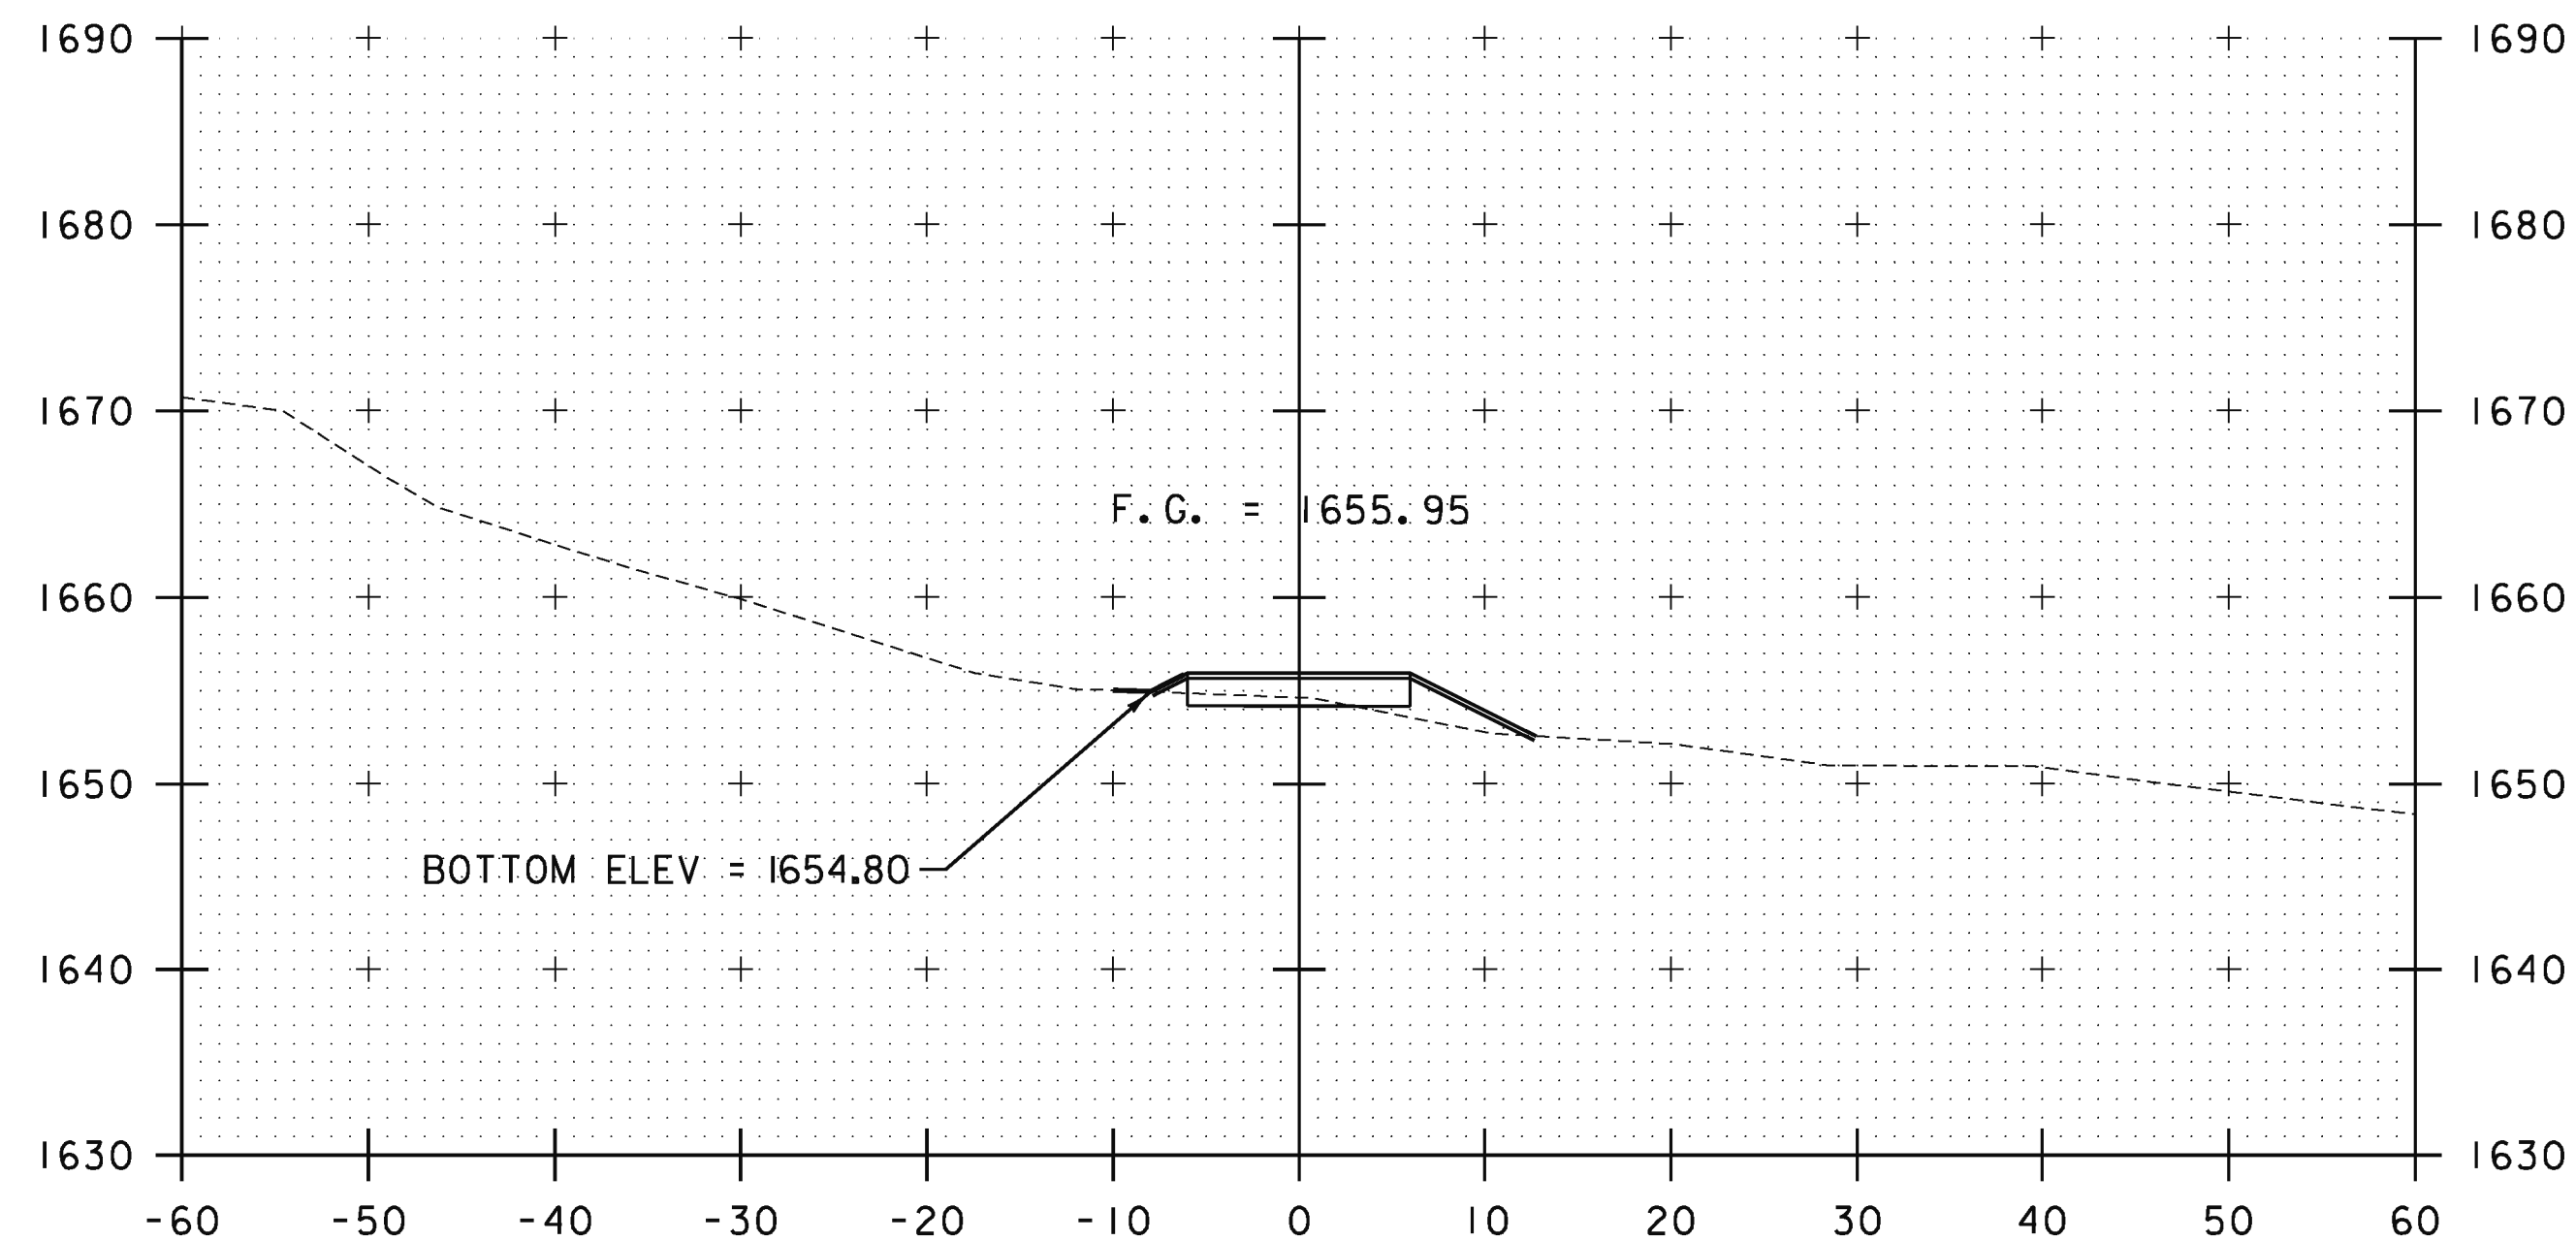

82+50

BUILT
ESSENTIALLY
AS SHOWN

STA. 81+50 TO STA. 83+00

PROJECT NAME: SEARSBURG
PROJECT NUMBER: NH 010-1(48)

FILE NAME: z12B404xsl.dgn
PROJECT LEADER: E. ATKINS
DESIGNED BY: M. BRADLEY
CROSS SECTION SHEET 13

PLOT DATE: 6/16/2014
DRAWN BY: M. BRADLEY
CHECKED BY: E. ATKINS
SHEET 41 OF 45