




83+62.58 PC

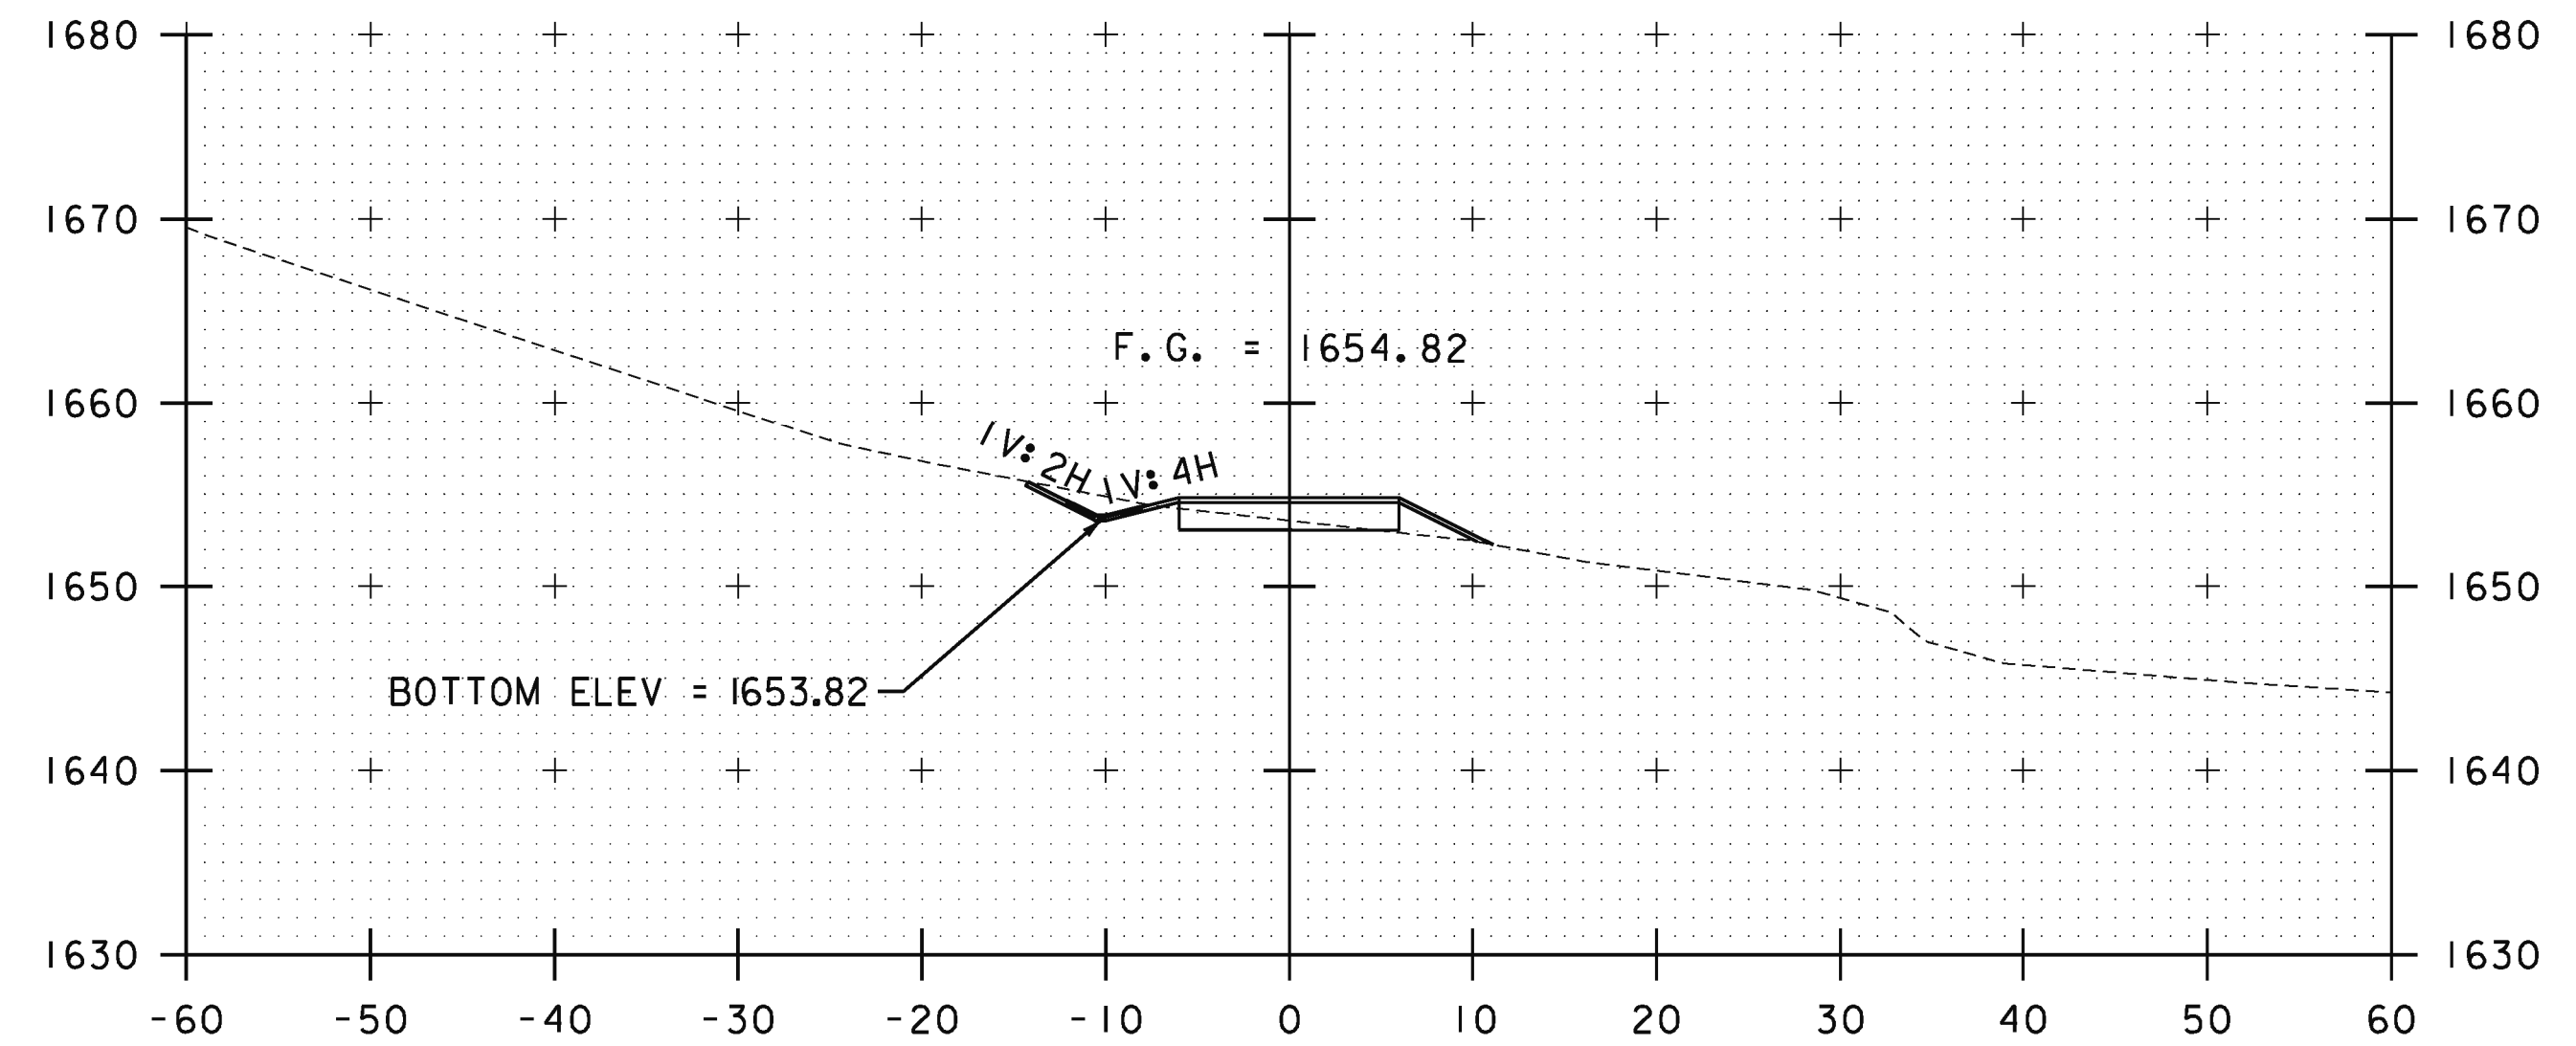

84+00

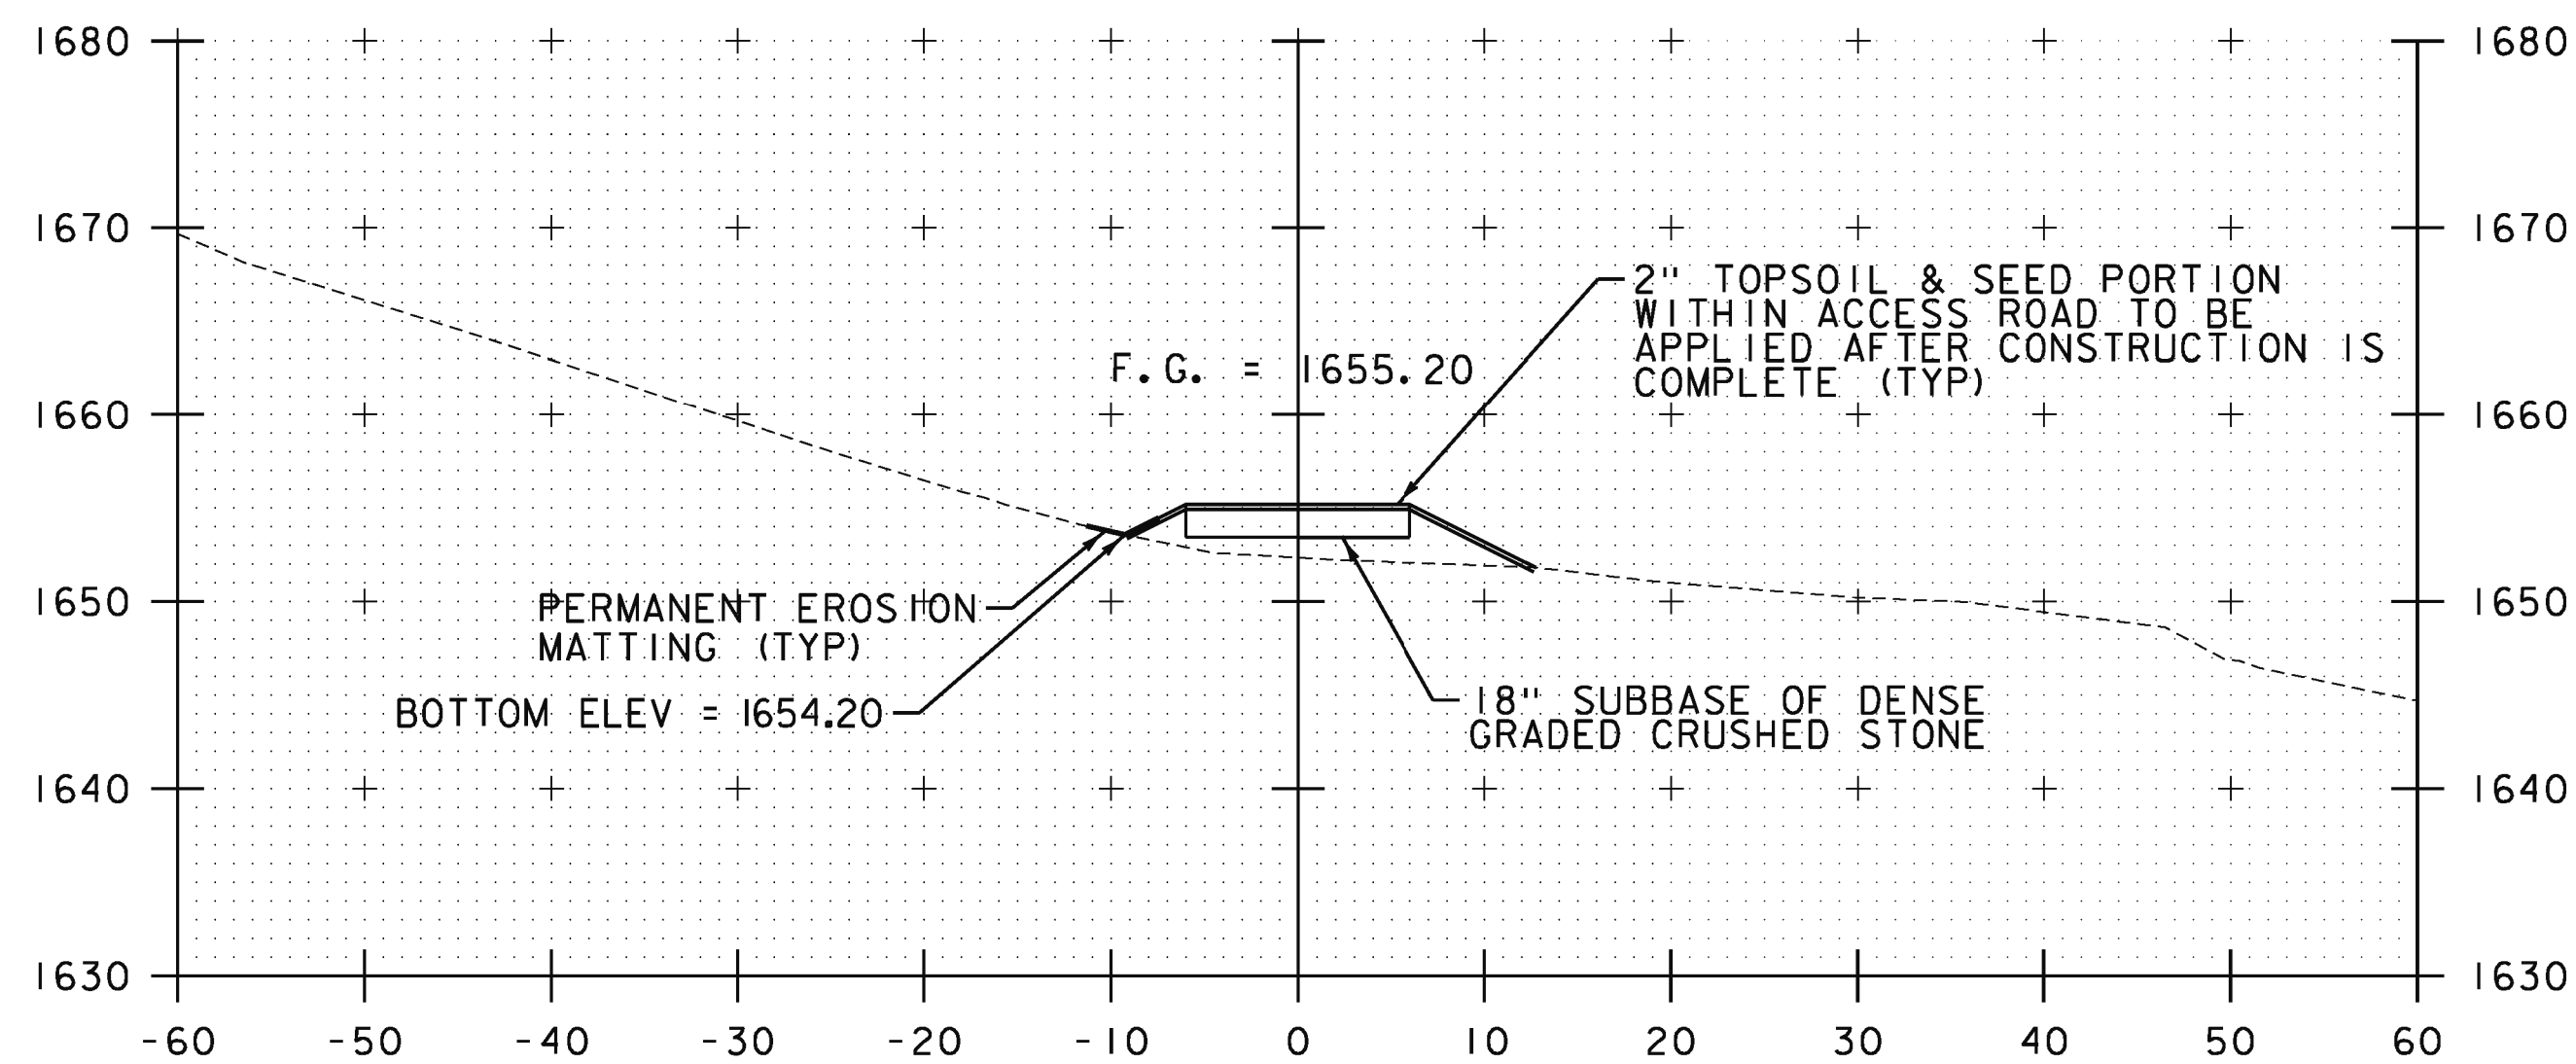

83+50

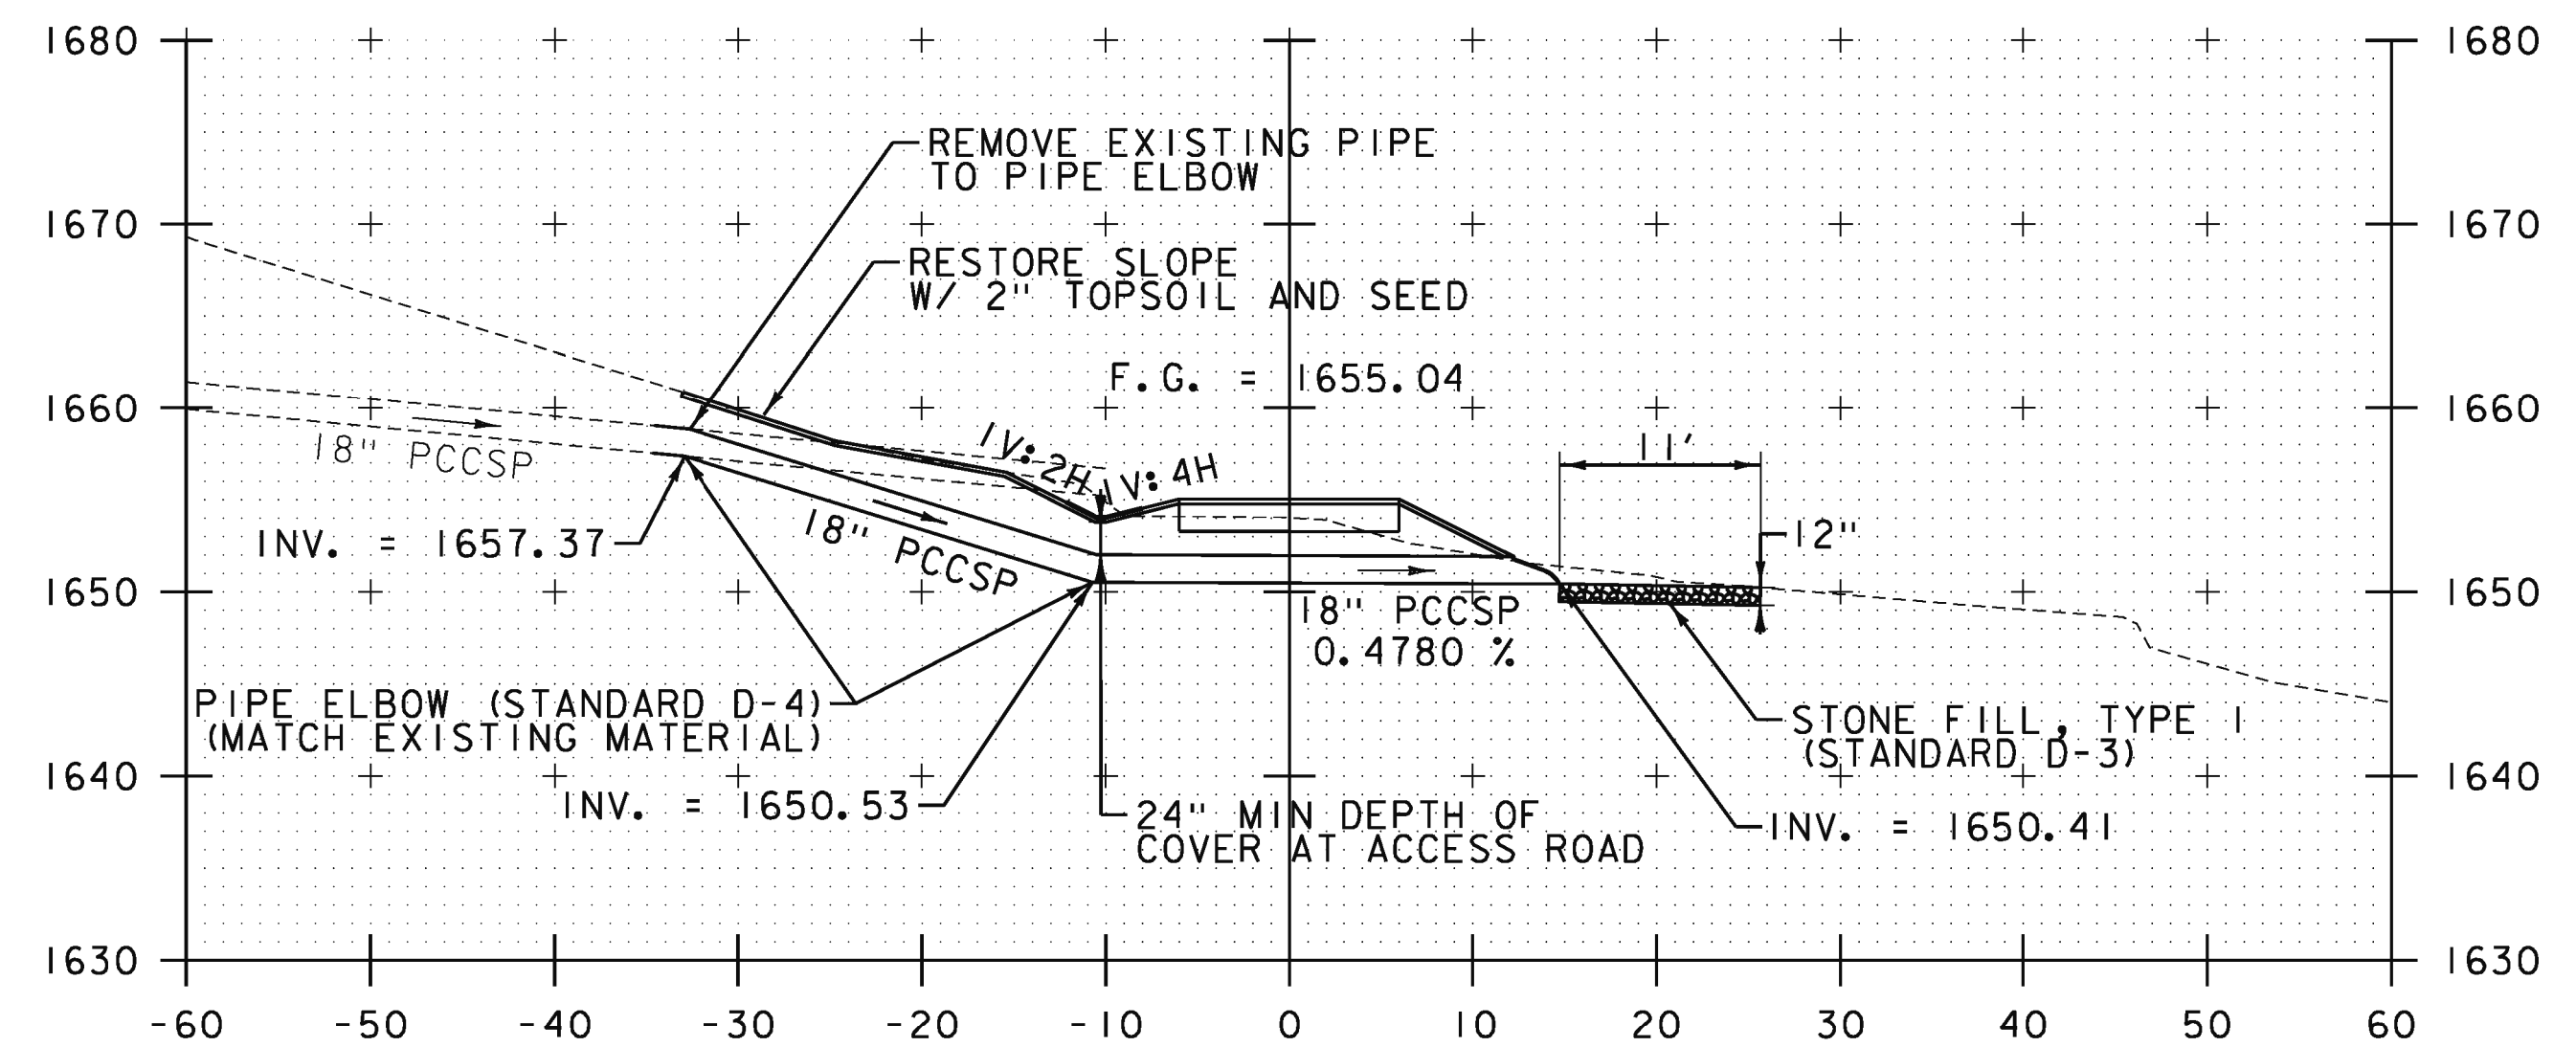

83+70.52 18" PCCSP CULVERT
SKEWED 85° 17' 30.5" LT

BUILT
ESSENTIALLY
AS SHOWN

STA. 83+50 TO STA. 84+00

| | |
|------------------------------|-----------------------|
| PROJECT NAME: SEARSBURG | |
| PROJECT NUMBER: NH 010-1(48) | |
| FILE NAME: z12B404xsl.dgn | PLOT DATE: 6/16/2014 |
| PROJECT LEADER: E. ATKINS | DRAWN BY: M. BRADLEY |
| DESIGNED BY: M. BRADLEY | CHECKED BY: E. ATKINS |
| CROSS SECTION SHEET 14 | SHEET 42 OF 45 |