



84+50

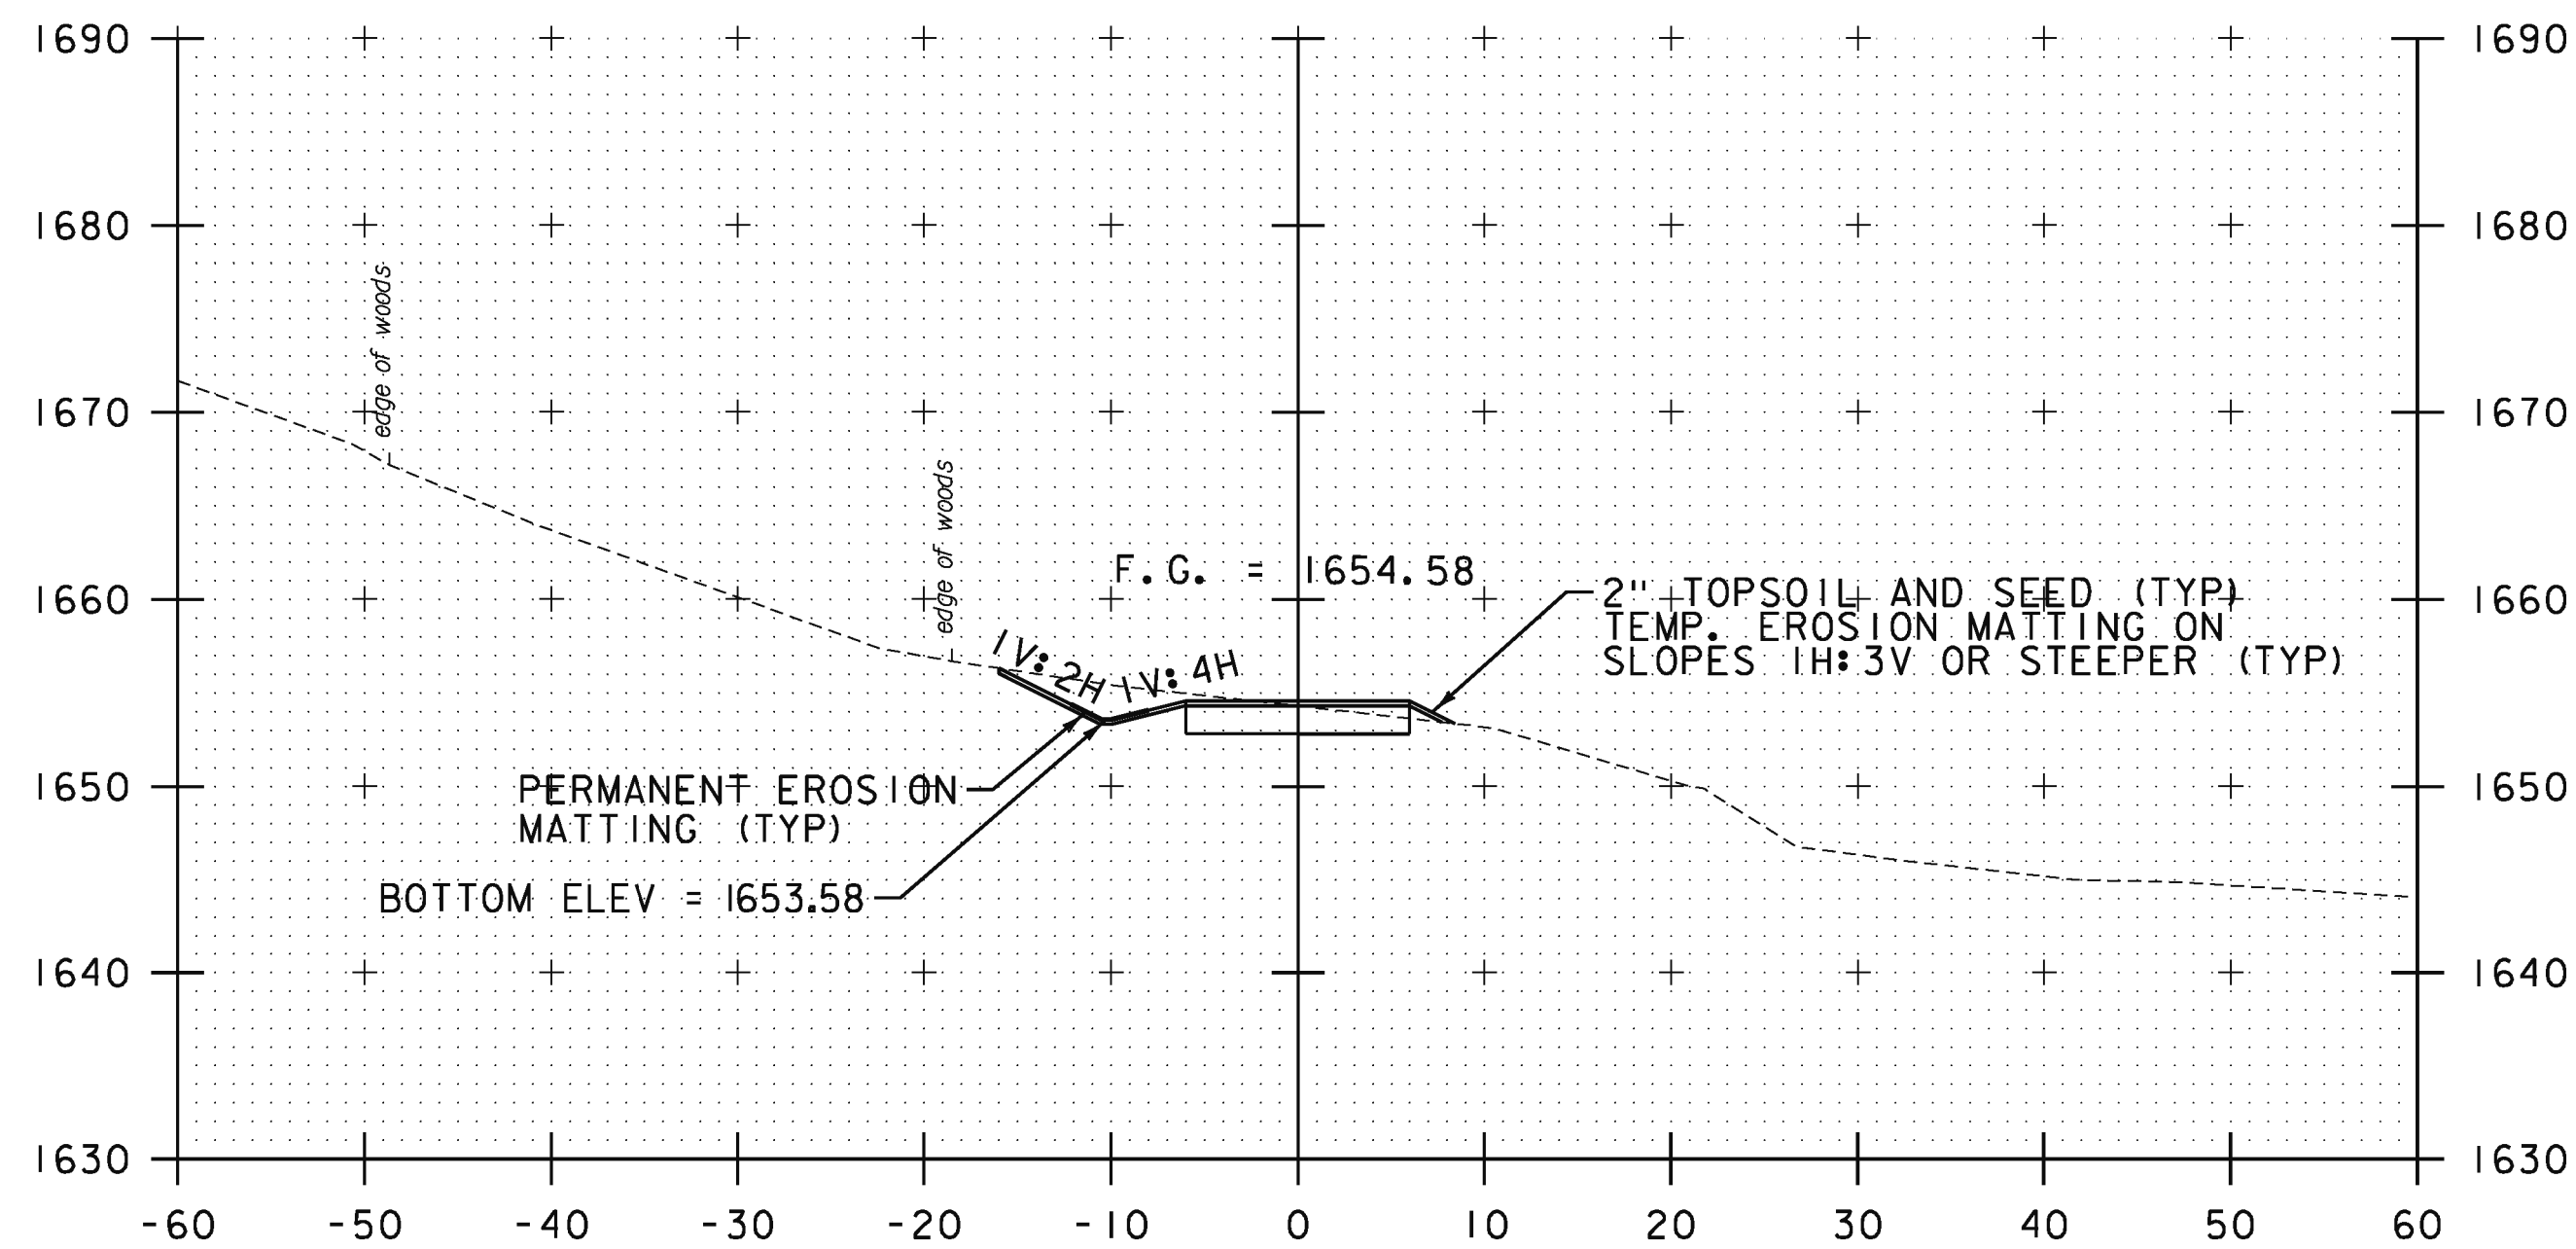

84+32.08 PT

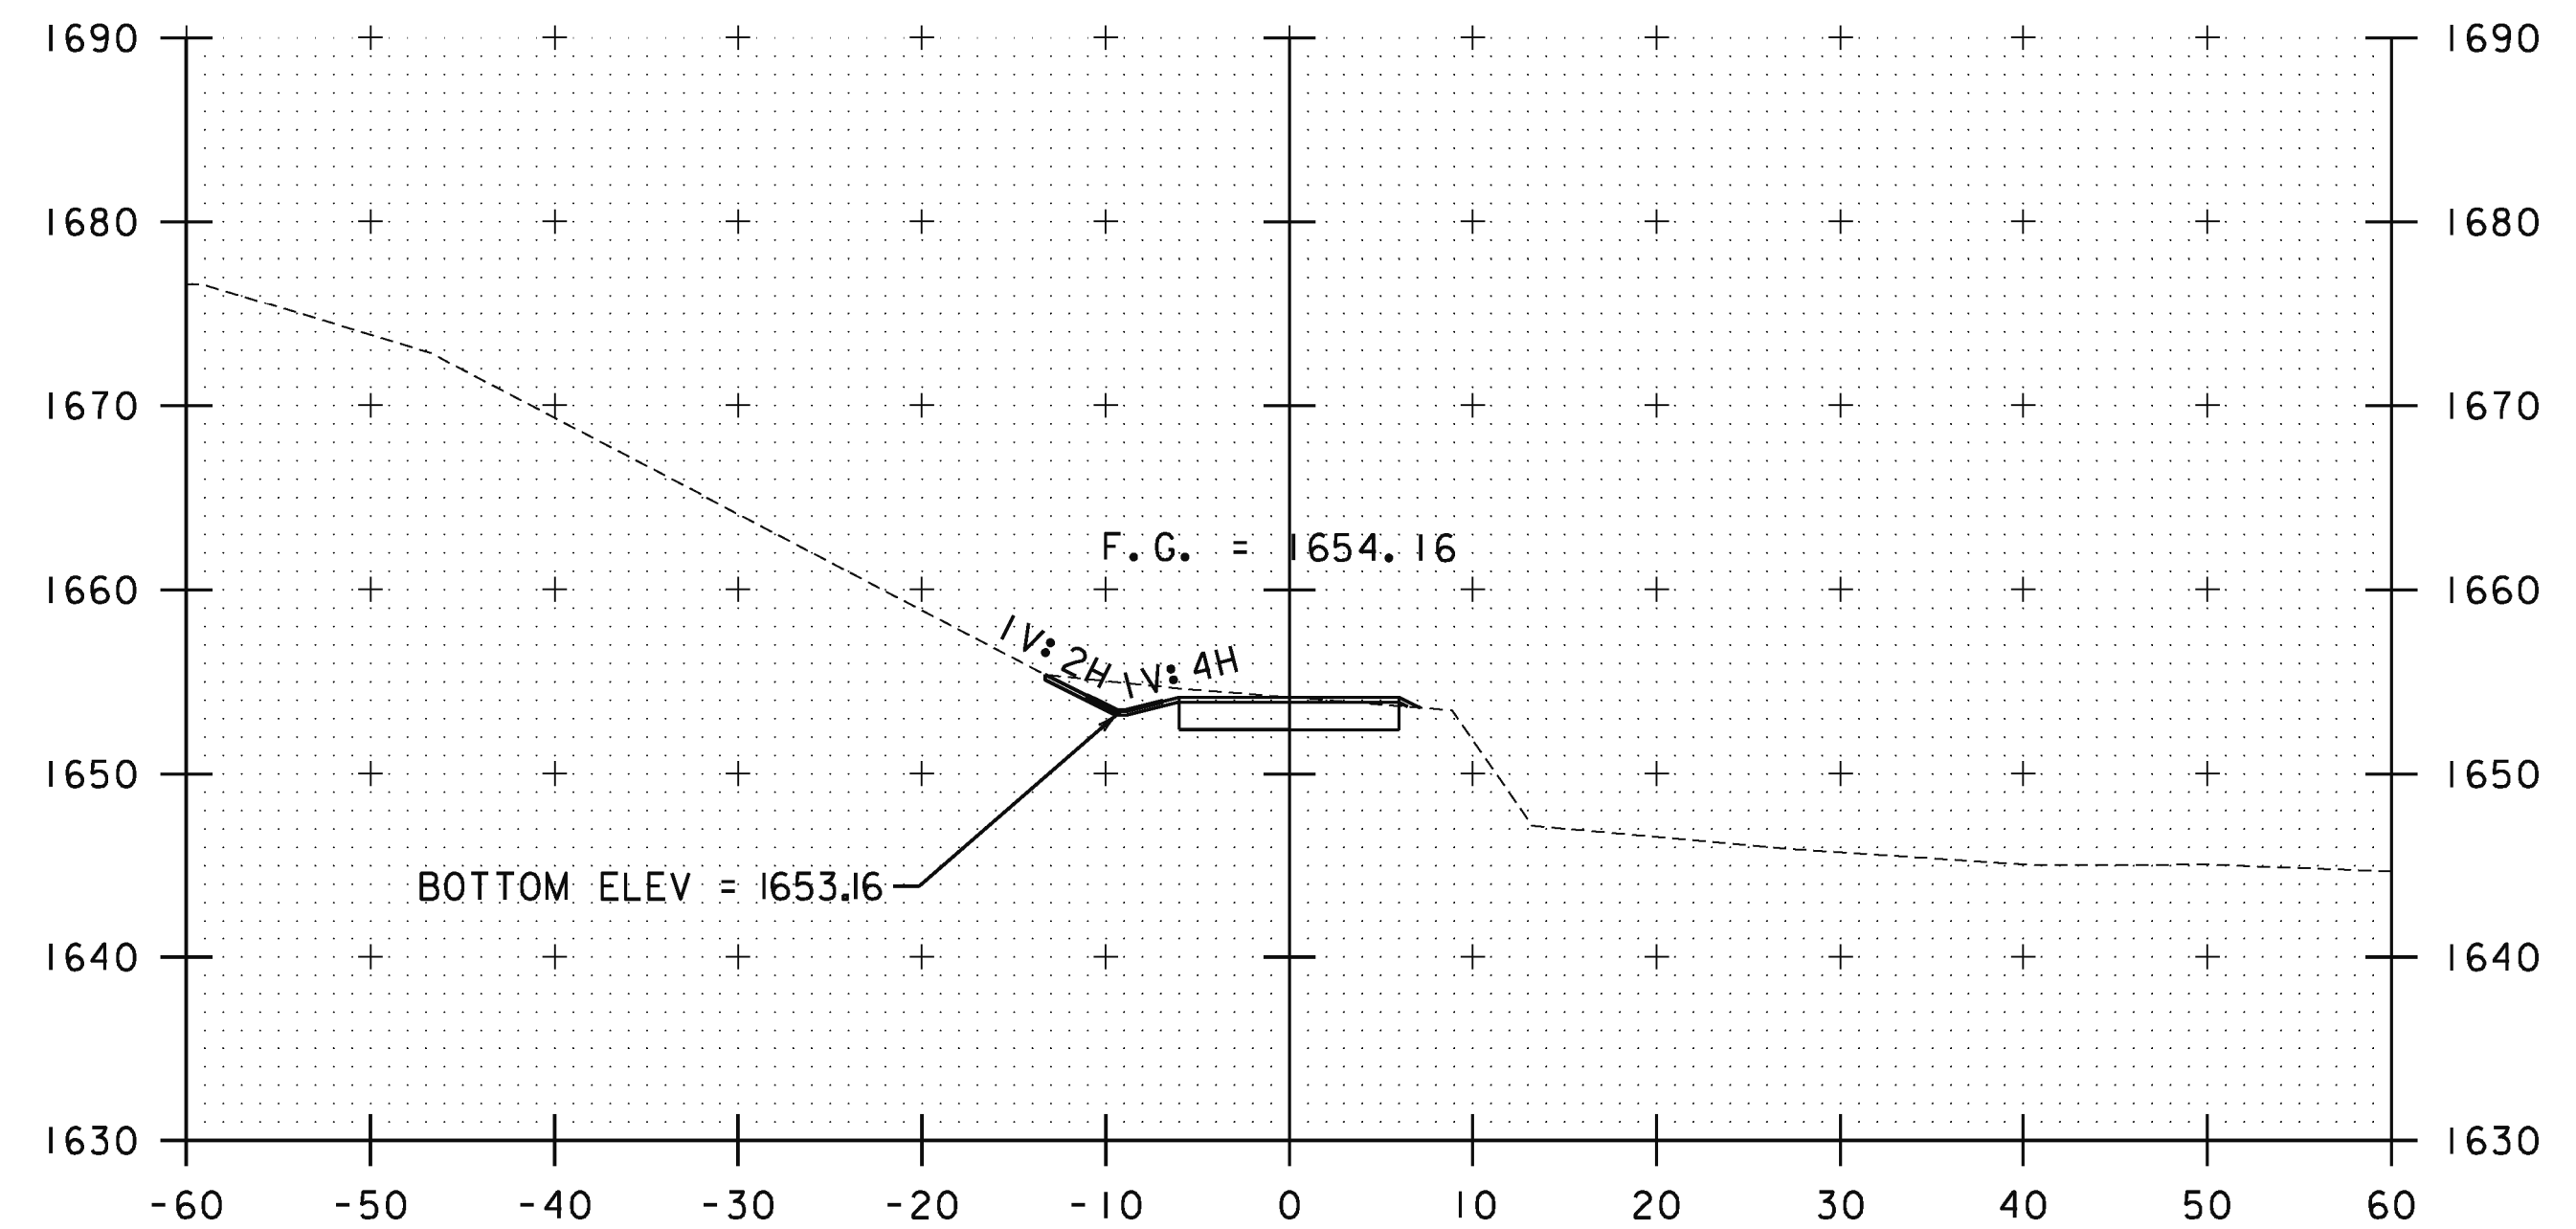

84+87.58
END ACCESS ROAD

BUILT
ESSENTIALLY
AS SHOWN

STA. 84+32.08 TO STA. 84+87.58

PROJECT NAME: SEARSBURG
PROJECT NUMBER: NH 010-1(48)

FILE NAME: z12B404xsl.dgn
PROJECT LEADER: E. ATKINS
DESIGNED BY: M. BRADLEY
CROSS SECTION SHEET 15

PLOT DATE: 6/16/2014
DRAWN BY: M. BRADLEY
CHECKED BY: E. ATKINS
SHEET 43 OF 45