

STATE OF VERMONT AGENCY OF TRANSPORTATION




PROPOSED IMPROVEMENT TOWN OF JAMAICA COUNTY OF WINDHAM


VT ROUTE 100 (MINOR ARTERIAL) BRIDGE 82

BEGINNING IN THE TOWN OF JAMAICA ON VT ROUTE 100 AT STATION 11+00.00 (MM 3.802) EXTENDING NORTHERLY ALONG
VT ROUTE 100 FOR A DISTANCE OF 285 FEET (0.054 MILE) TO STATION 13+85.00 (MM 3.856)
LENGTH OF ROADWAY = 274.68 FEET (0.052 MILE)
LENGTH OF STRUCTURE = 10.32 FEET
LENGTH OF CHANNEL = 452.00 FEET (0.086 MILE)
LENGTH OF PROJECT = 285.00 FEET (0.054 MILE)

WORK TO BE PERFORMED UNDER THIS PROJECT INCLUDES REPLACEMENT OF AN EXISTING CULVERT WITH A PRECAST CONCRETE BOX STRUCTURE WITH ASSOCIATED CHANNEL AND ROADWAY WORK.

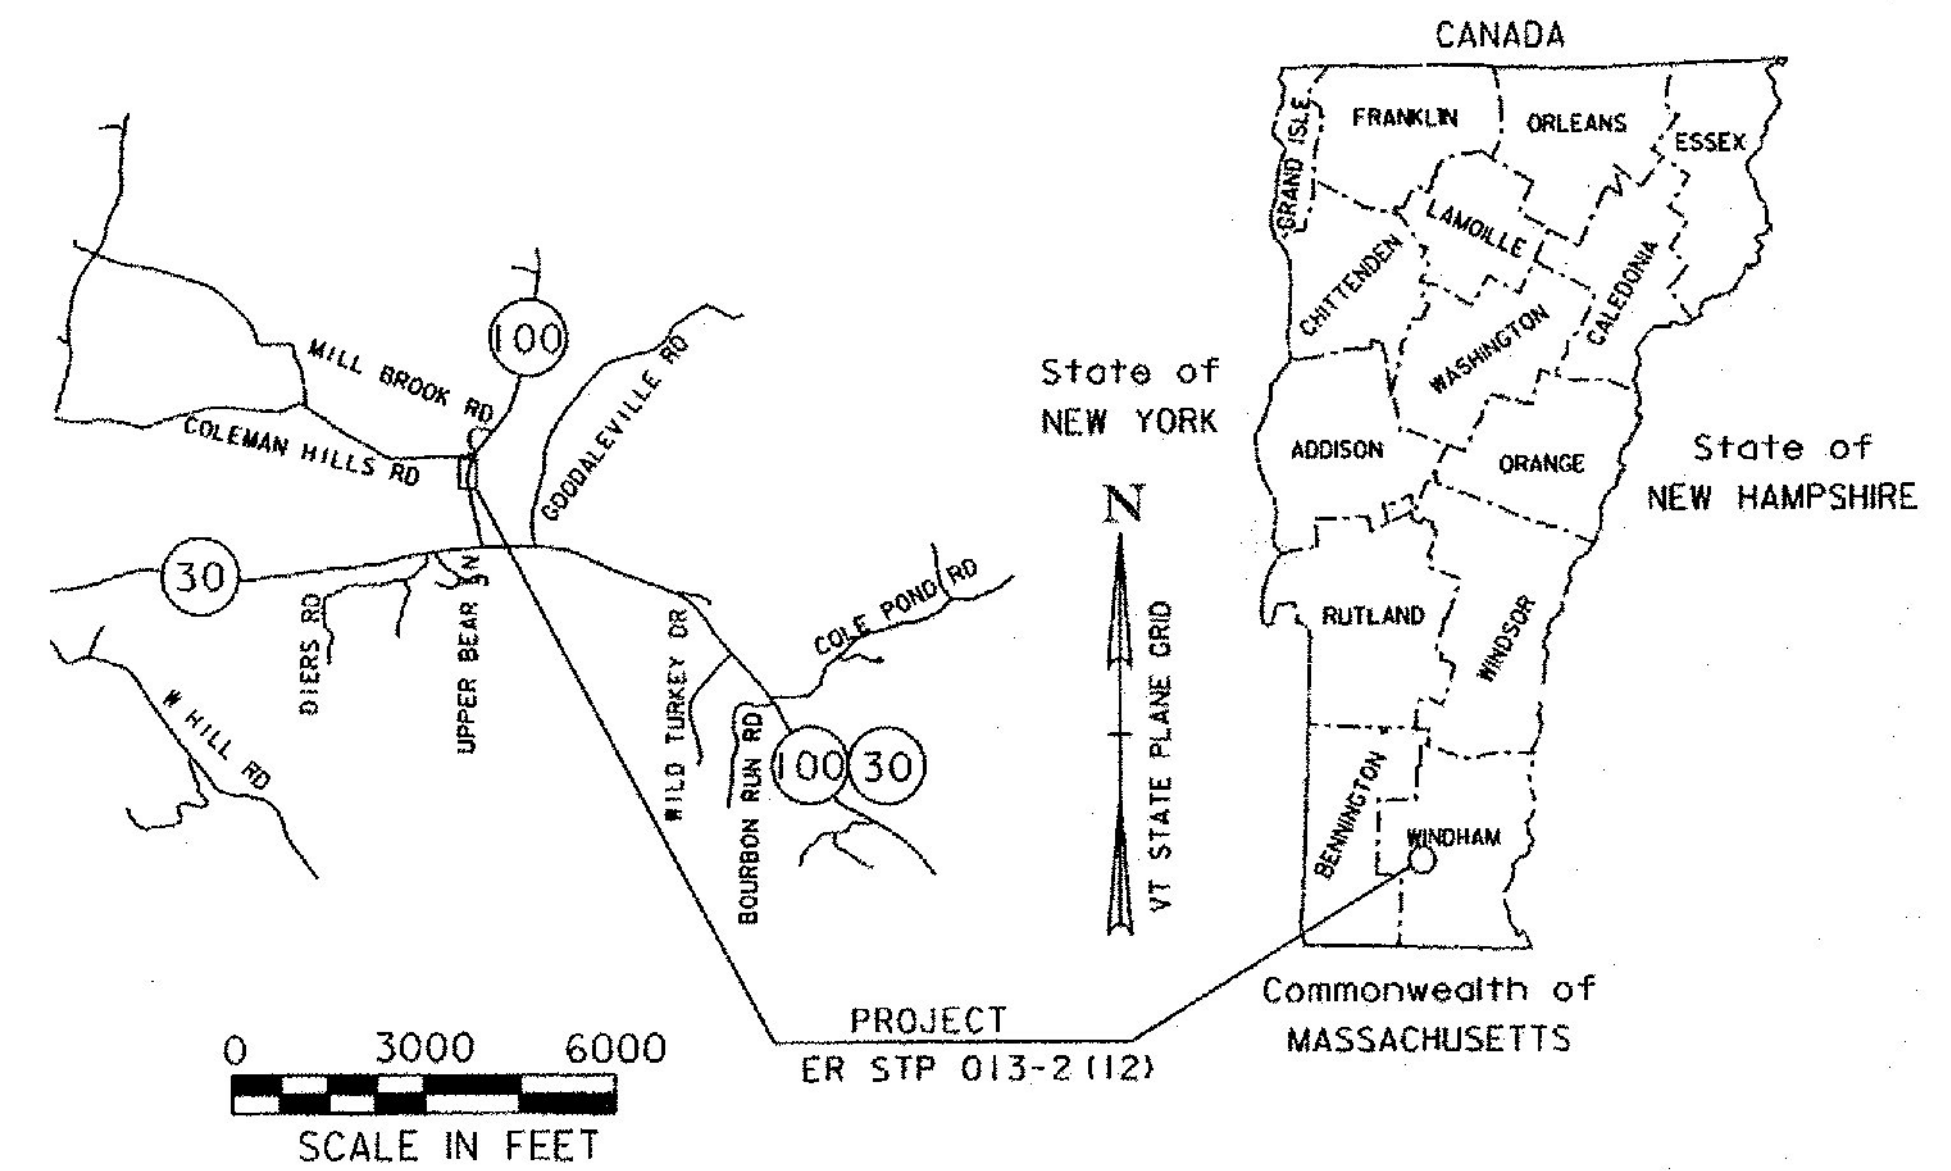

RECORD PLANS	
CONTRACTOR:	CASELLA CONSTRUCTION, INC. - MENDON, VT.
RESIDENT ENGINEER:	CHAD GREENWOOD
CONSTRUCTION BEGAN:	SEPTEMBER 2, 2015
CONSTRUCTION COMPLETE:	OCTOBER 23, 2015
RECORD PLANS BY:	CHAD GREENWOOD & KEVIN KING
I HEREBY CERTIFY THAT ALL THE CONSTRUCTION REQUIRED BY THIS SET OF DRAWINGS HAS BEEN ACCOMPLISHED AS INDICATED HEREIN.	
BY <i>Chad Greenwood</i>	RESIDENT ENGINEER
DATE <u>1/30/17</u>	
NOTE: Any further information concerning final quantities, amounts or other details relative to this project may be found at Central Files in the electronic archives.	

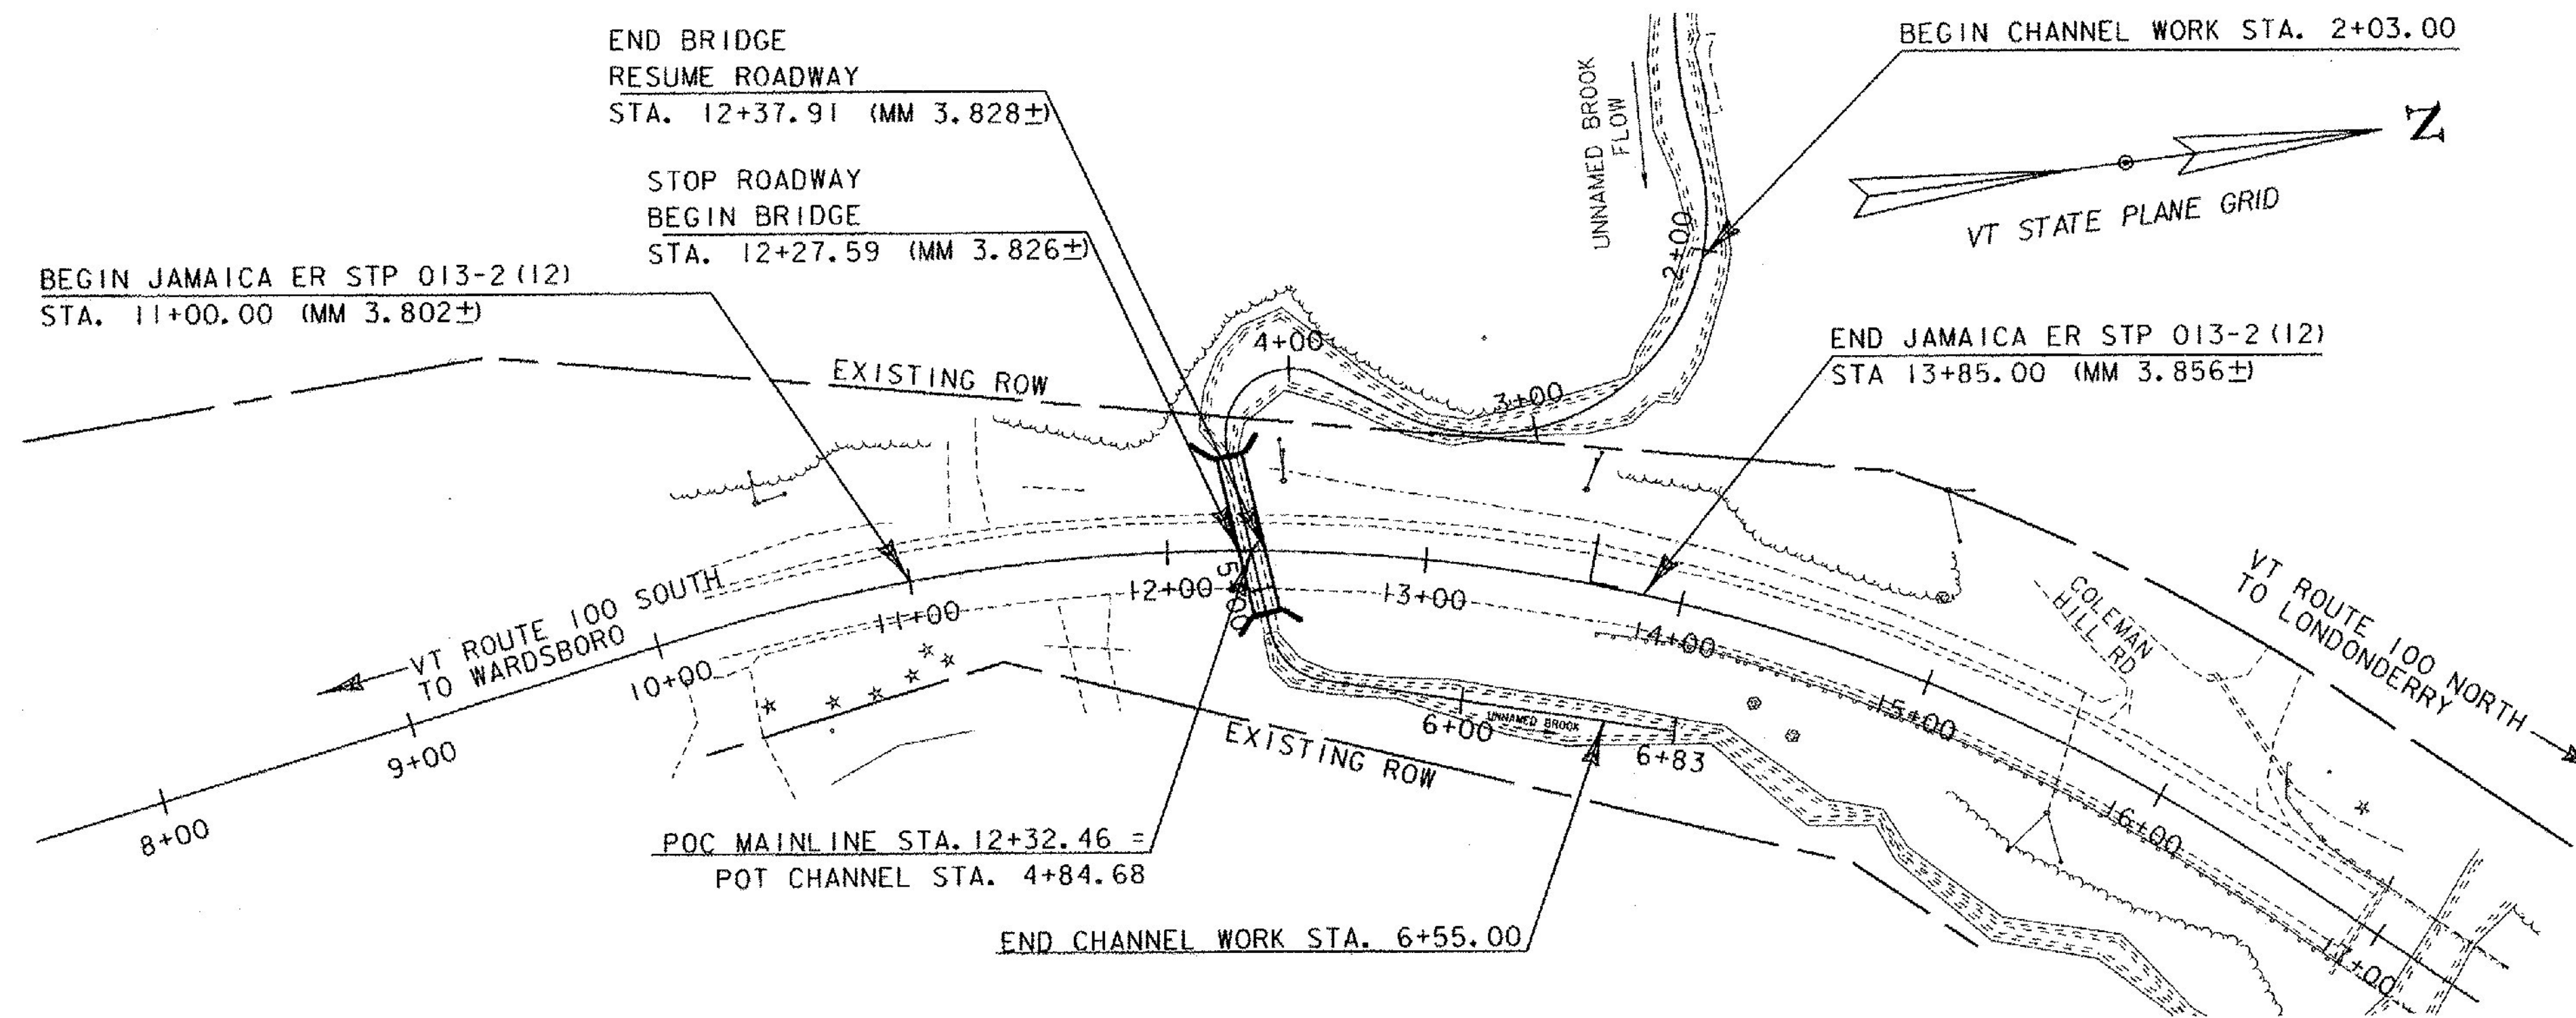

CONSTRUCTION IS TO BE CARRIED ON IN ACCORDANCE WITH THESE PLANS AND THE STANDARD SPECIFICATIONS FOR CONSTRUCTION DATED 2011, AS APPROVED BY THE FEDERAL HIGHWAY ADMINISTRATION ON JULY 20, 2011 FOR USE ON THIS PROJECT, INCLUDING ALL SUBSEQUENT REVISIONS AND SUCH REVISED SPECIFICATIONS AND SPECIAL PROVISIONS AS ARE INCORPORATED IN THESE PLANS.

QUALITY ASSURANCE PROGRAM : LEVEL 2
SURVEYED BY : VERMONT SURVEY & ENGINEERING
SURVEYED DATE : 02/27/2013
DATUM
VERTICAL 88 (GEOID12A) FT
HORIZONTAL NAD 83 (2011) SFT



DIRECTOR OF PROJECT DELIVERY	
APPROVED <i>Paul Libby</i>	DATE 3/9/2015
PROJECT MANAGER : PAUL LIBBY	
PROJECT NAME : JAMAICA	
PROJECT NUMBER : ER STP 013-2 (12)	
SHEET 1 OF 48 SHEETS	