

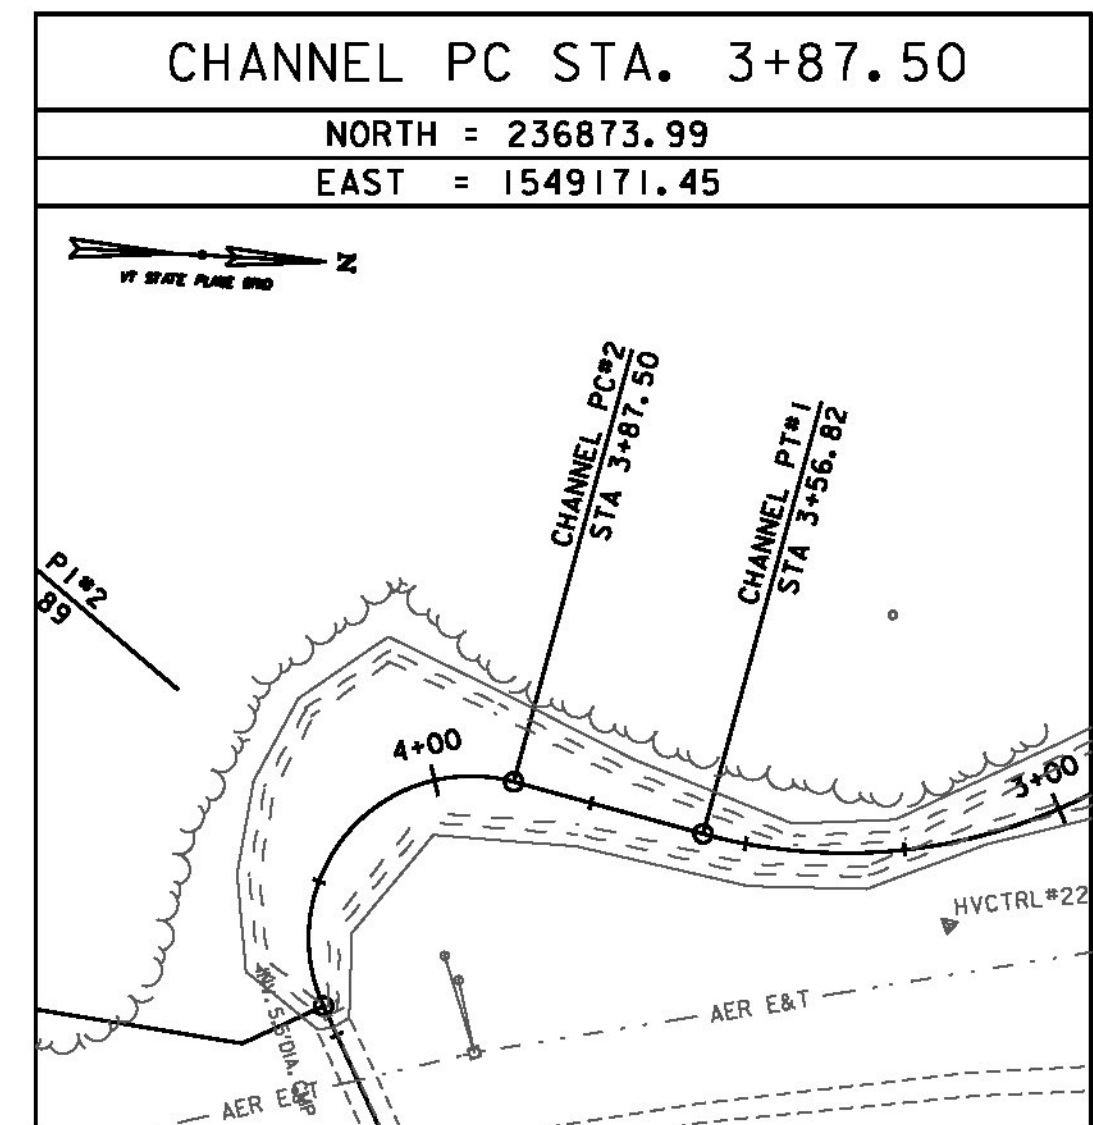
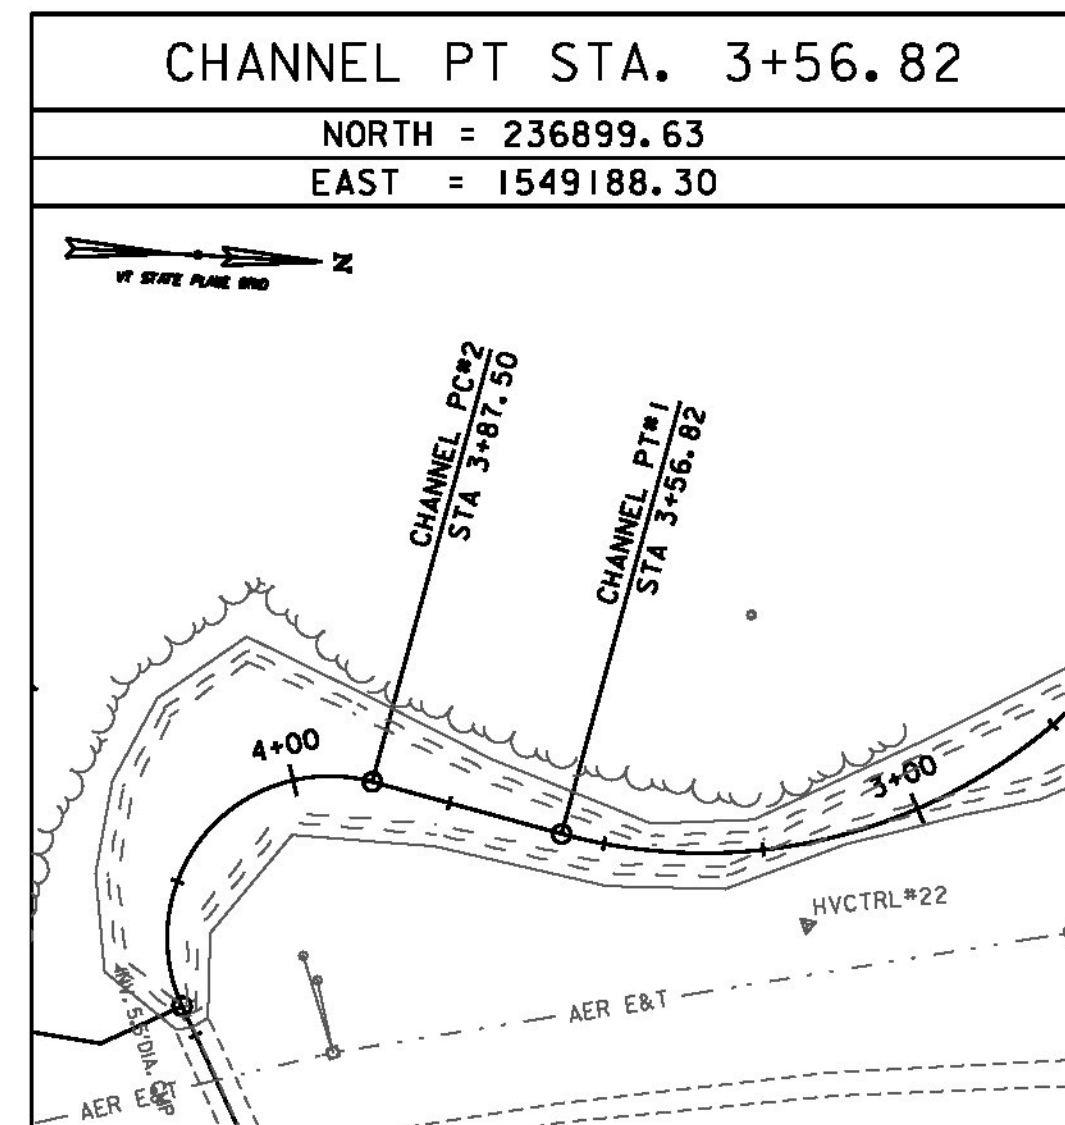
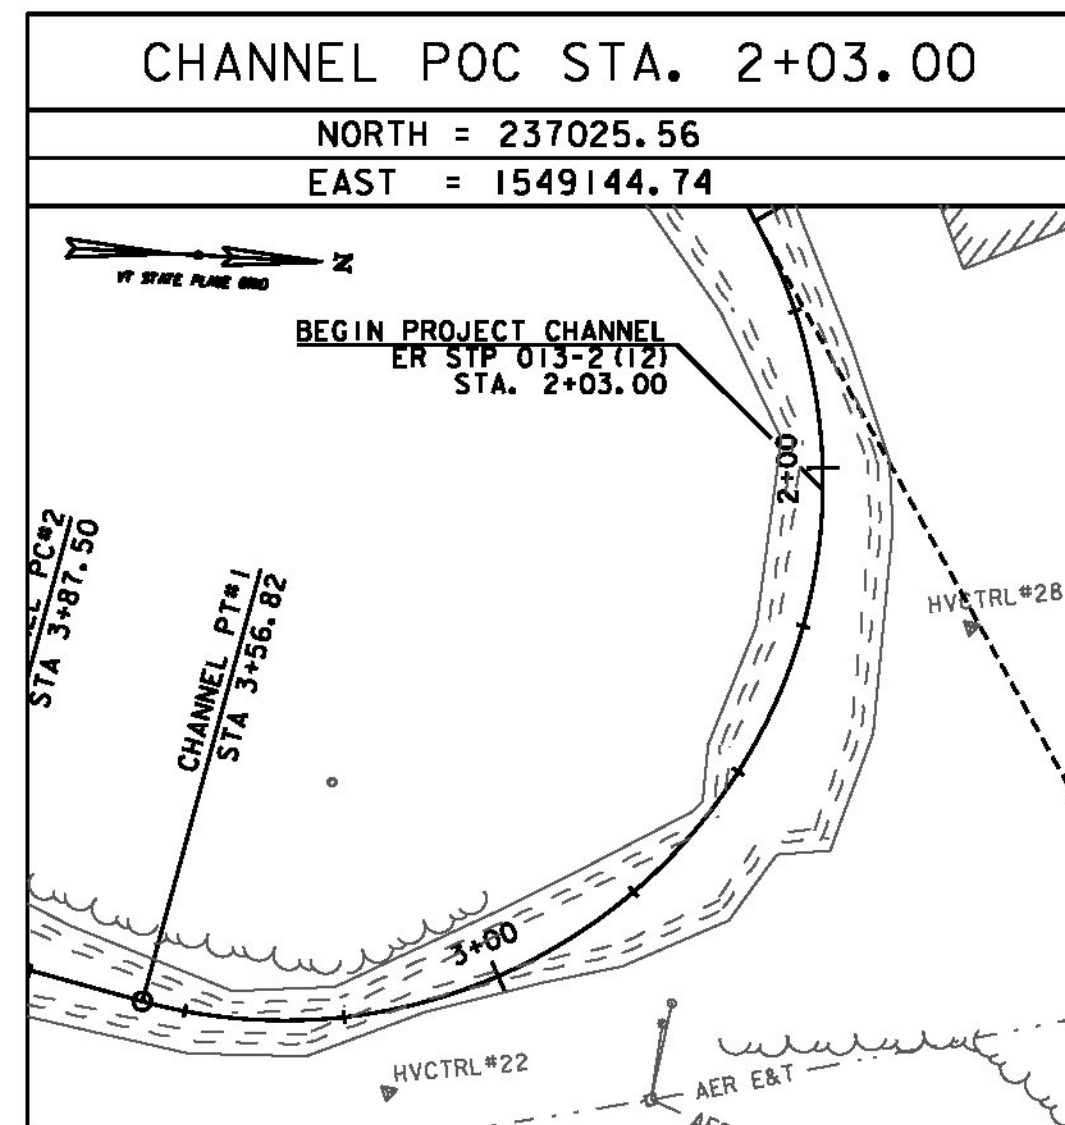
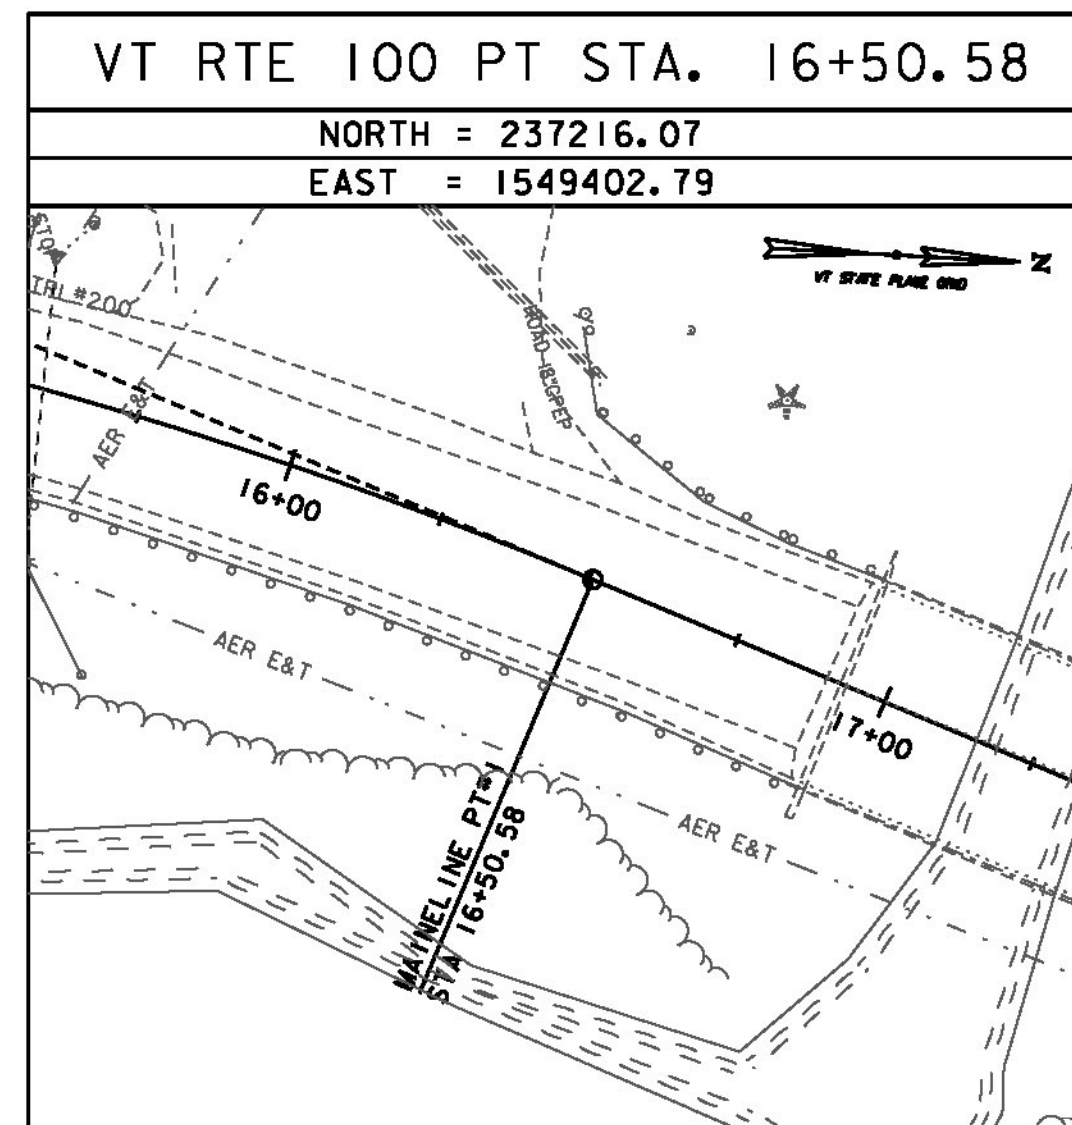
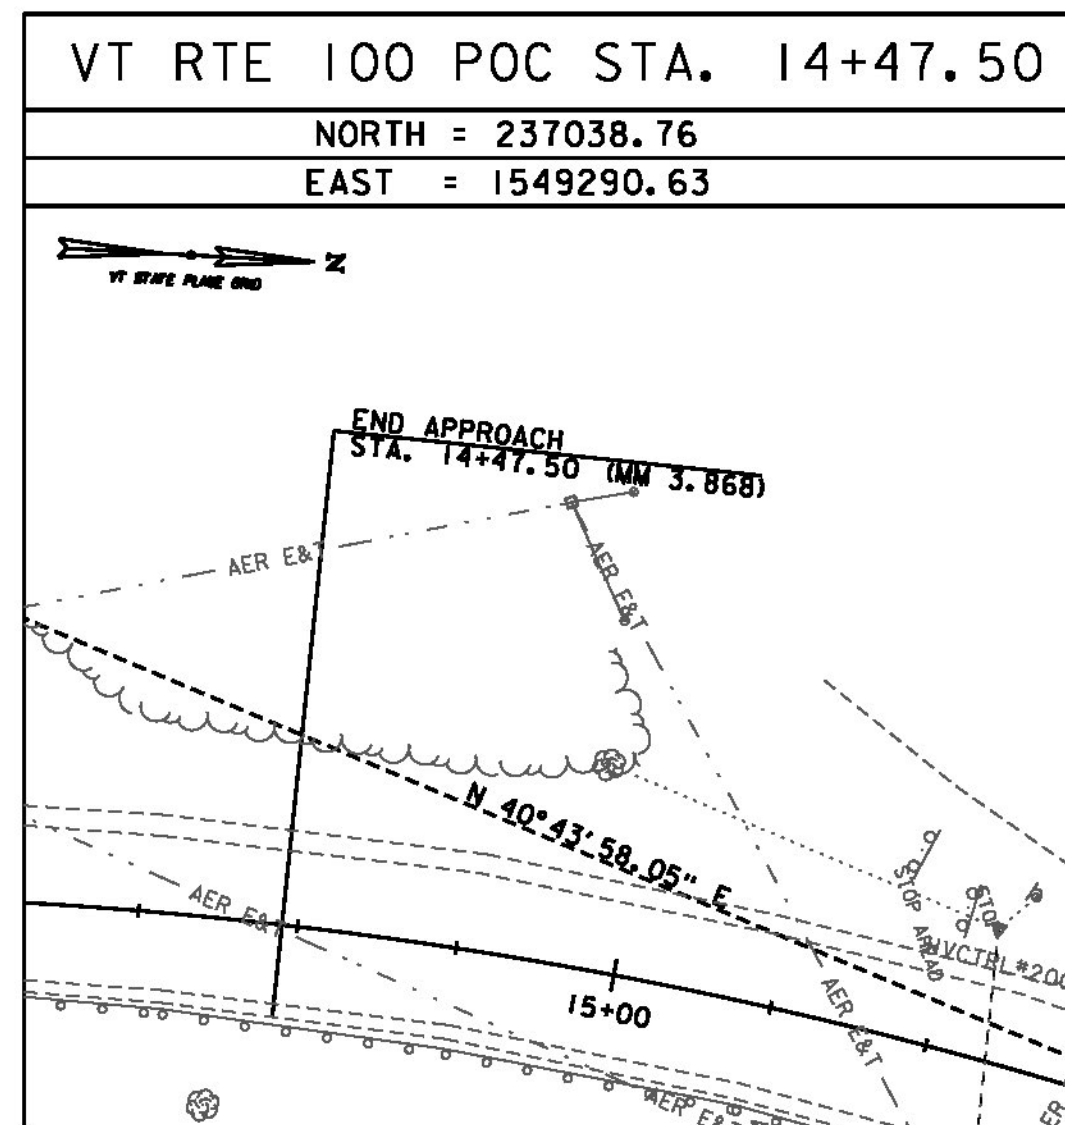
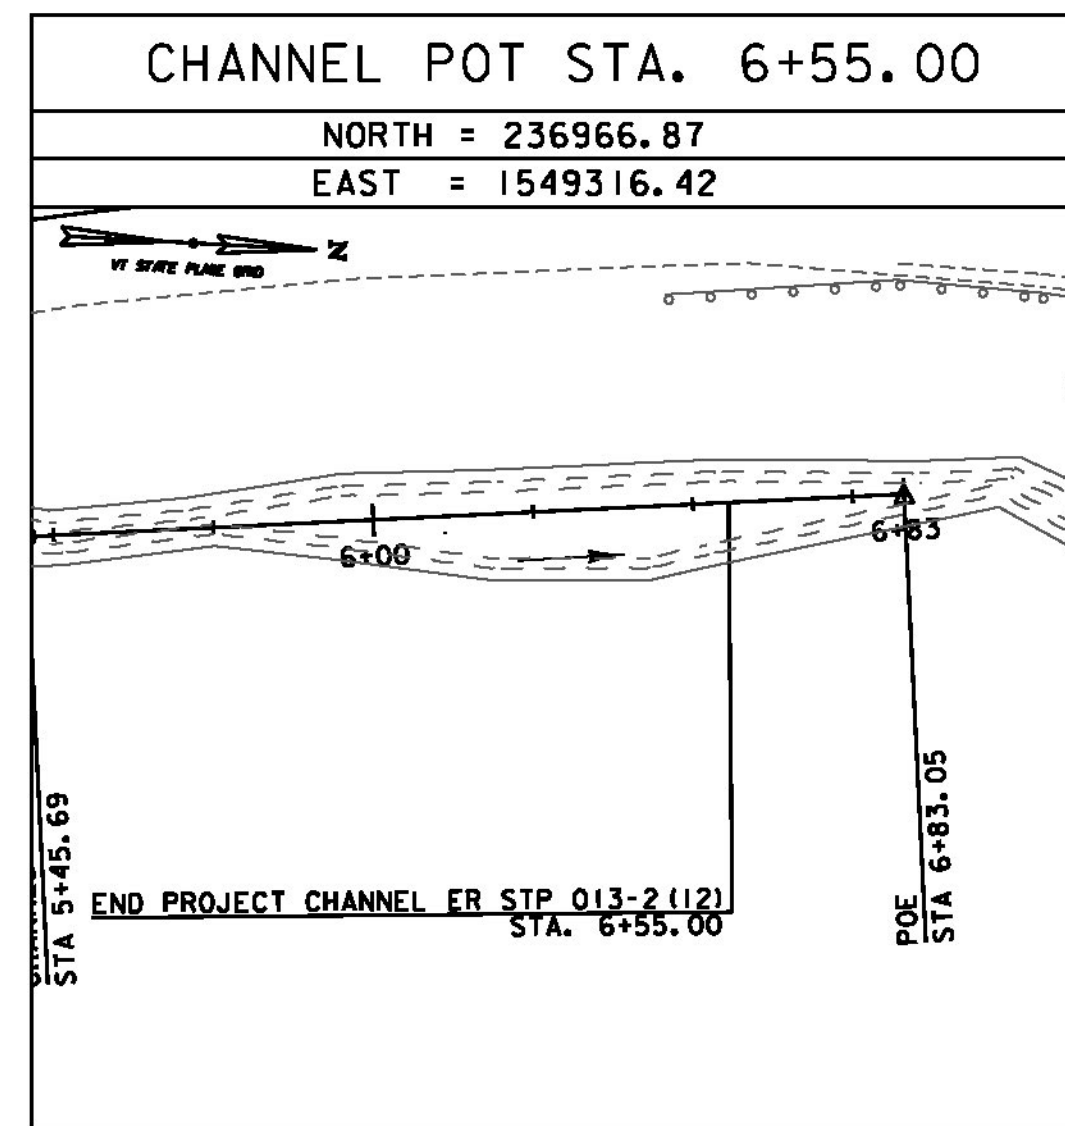
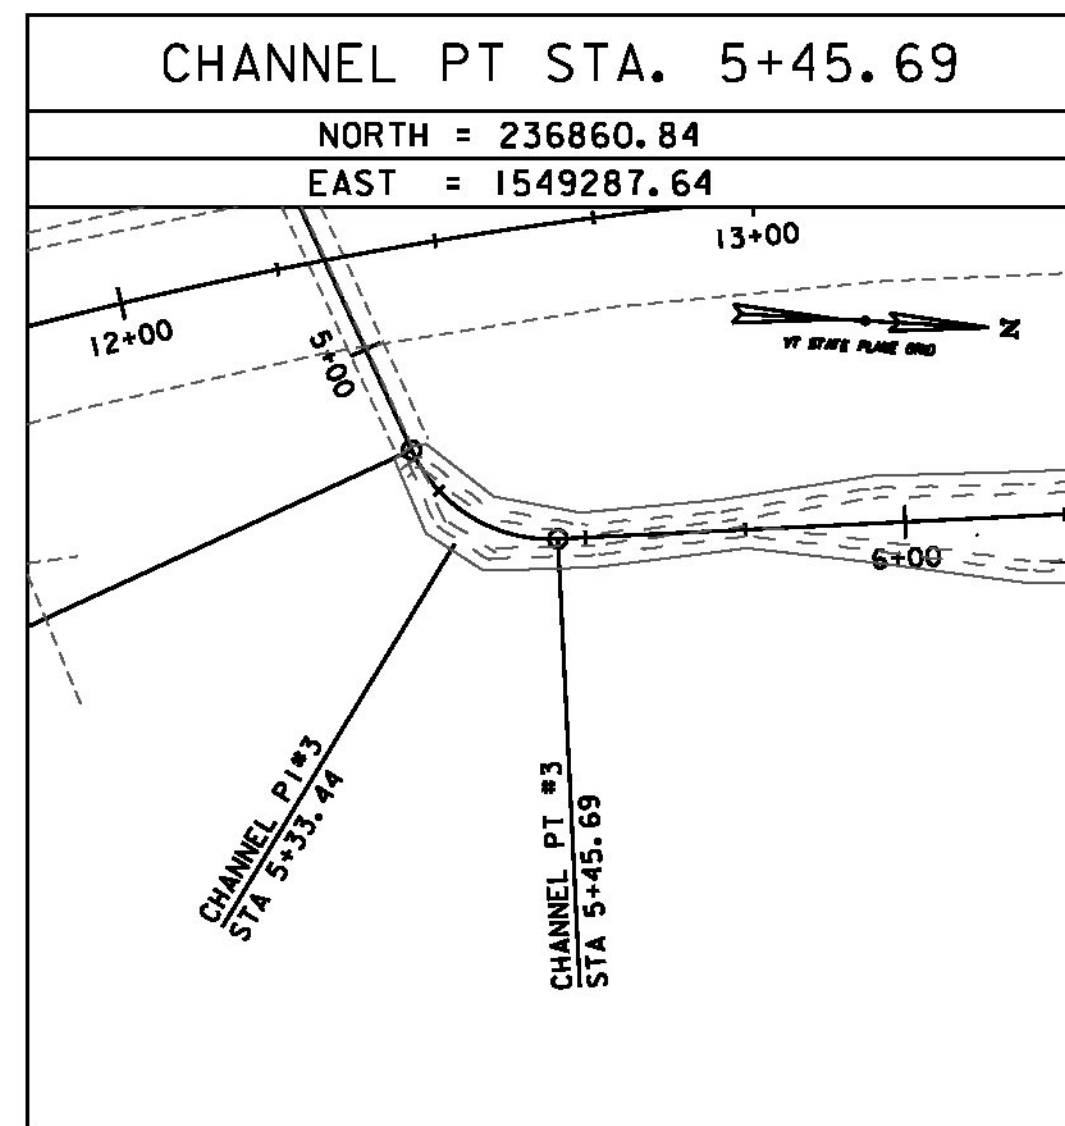







ALIGNMENT TIES

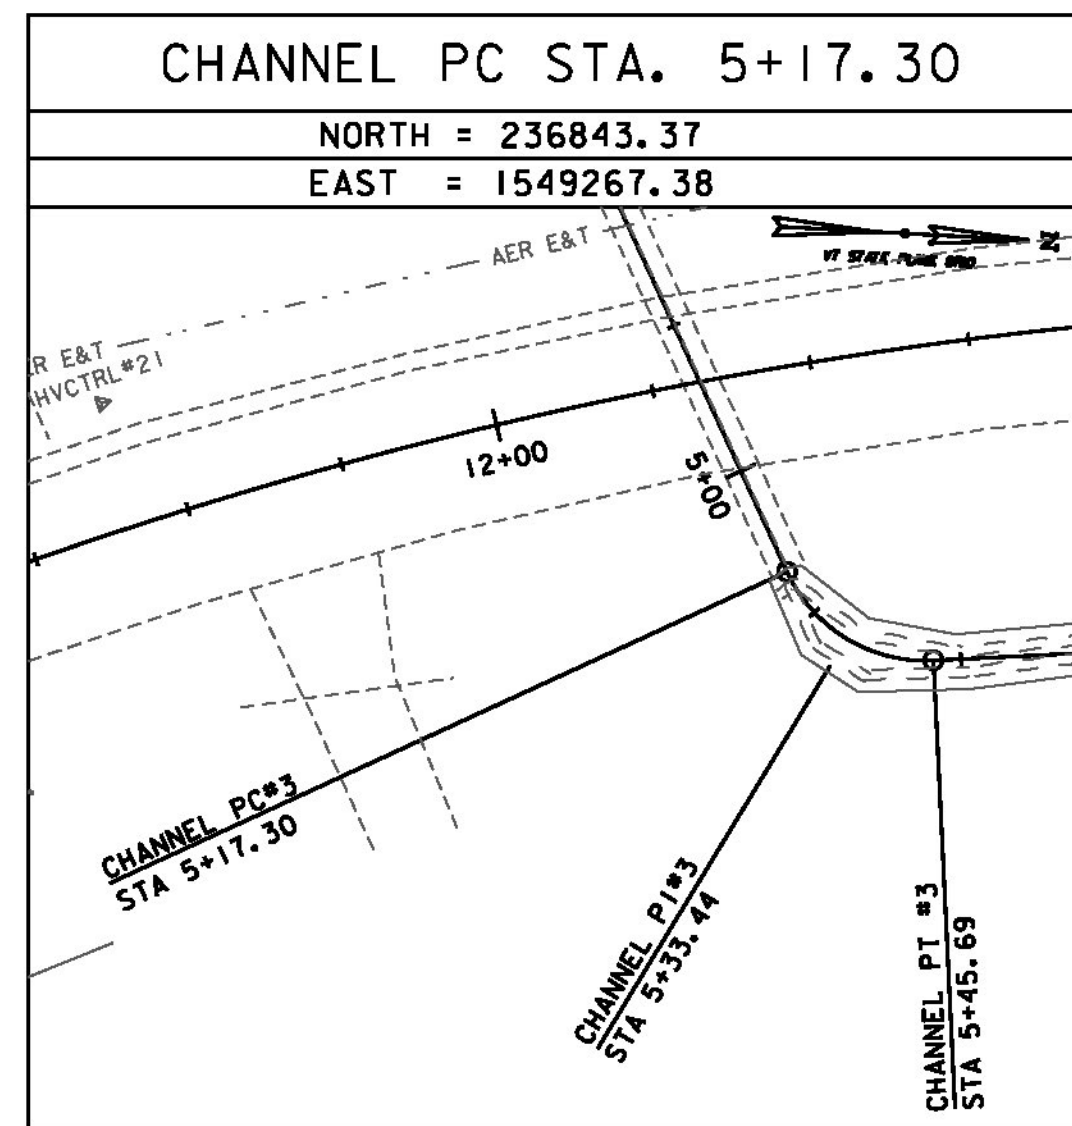


ALIGNMENT TIES

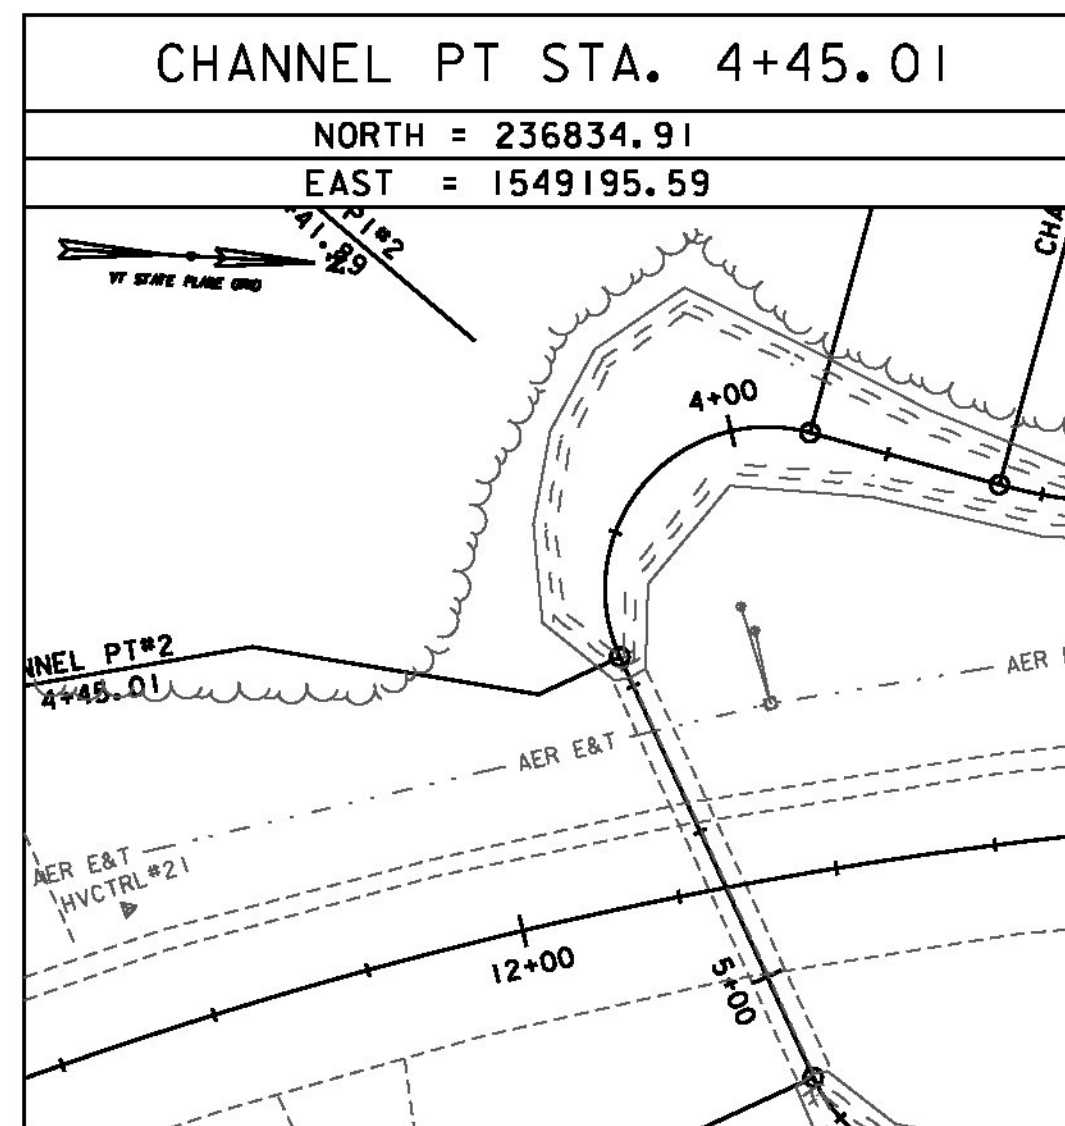

     ALIGNMENT TIES



DATUM
VERTICAL NAVD 88(GEOD12A) FT
HORIZONTAL NAD 83(2011) SFT
ADJUSTMENT NONE

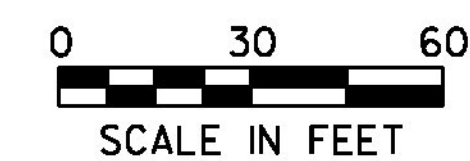

GREEN INTERNATIONAL AFFILIATES, INC.
CIVIL AND STRUCTURAL ENGINEERS

PROJECT NAME: JAMAICA
PROJECT NUMBER: ER STP 013-2(12)

FILE NAME: Z12b474t1.dgn
PROJECT LEADER: E. ATKINS
DESIGNED BY: C. MORIN
TIE SHEET 2

PLOT DATE: 02/27/2015
DRAWN BY: C. MORIN
CHECKED BY: E. ATKINS
SHEET 8 OF 48