


SEE CHANGE ORDER #1

SEE ATTACHED SHOP DRAWINGS
FOR WINGWALL DETAILS

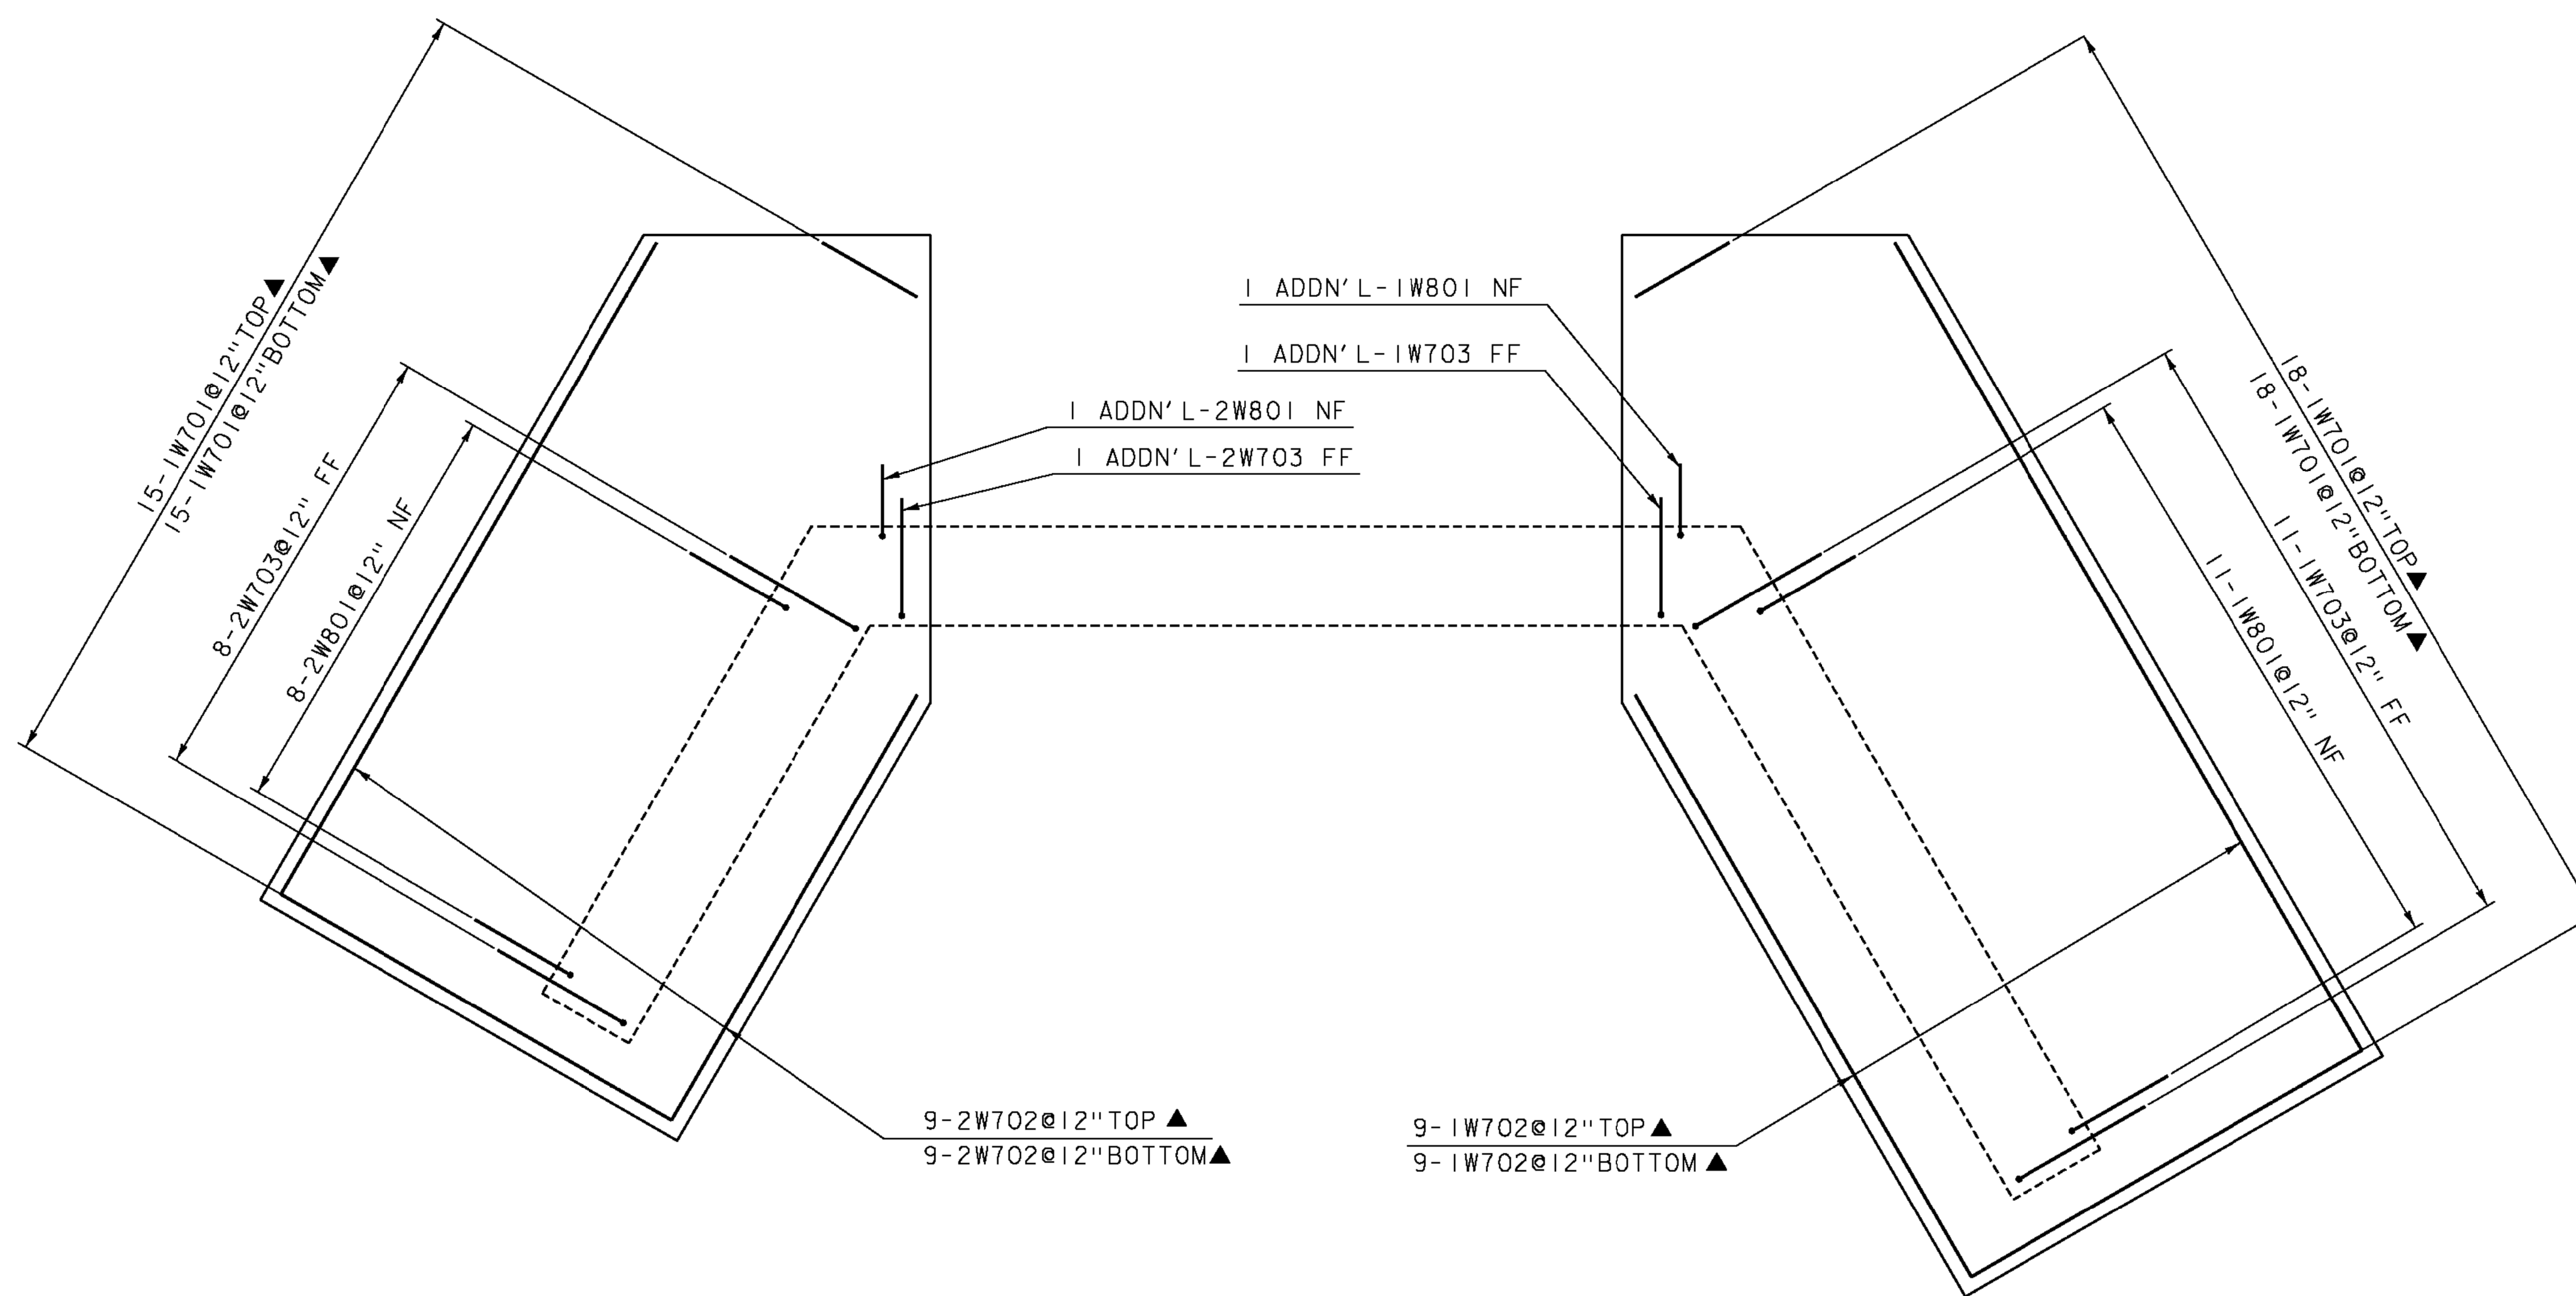

INLET FOOTING PLAN

SCALE 1/2" = 1'

NOTE:

NF = NEAR FACE
FF = FAR FACE
EF = EACH FACE
▲ = CUT TO FIT IN FIELD
3" CLEAR, UNLESS OTHERWISE
SPECIFIED ON THE PLANS.
2'-2" BAR LAP UNLESS OTHERWISE
SPECIFIED ON THE PLANS.



PROJECT NAME: JAMAICA	PLOT DATE: 02/27/2015
PROJECT NUMBER: ER STP 013-2(12)	DRAWN BY: S. SOLLA
FILE NAME: z12b474de+2.dgn	CHECKED BY: B. KHALIFA
PROJECT LEADER: E. ATKINS	FOOTING DETAILS SHEET 1(BR 82)
DESIGNED BY: B. KHALIFA	SHEET 34 OF 48