
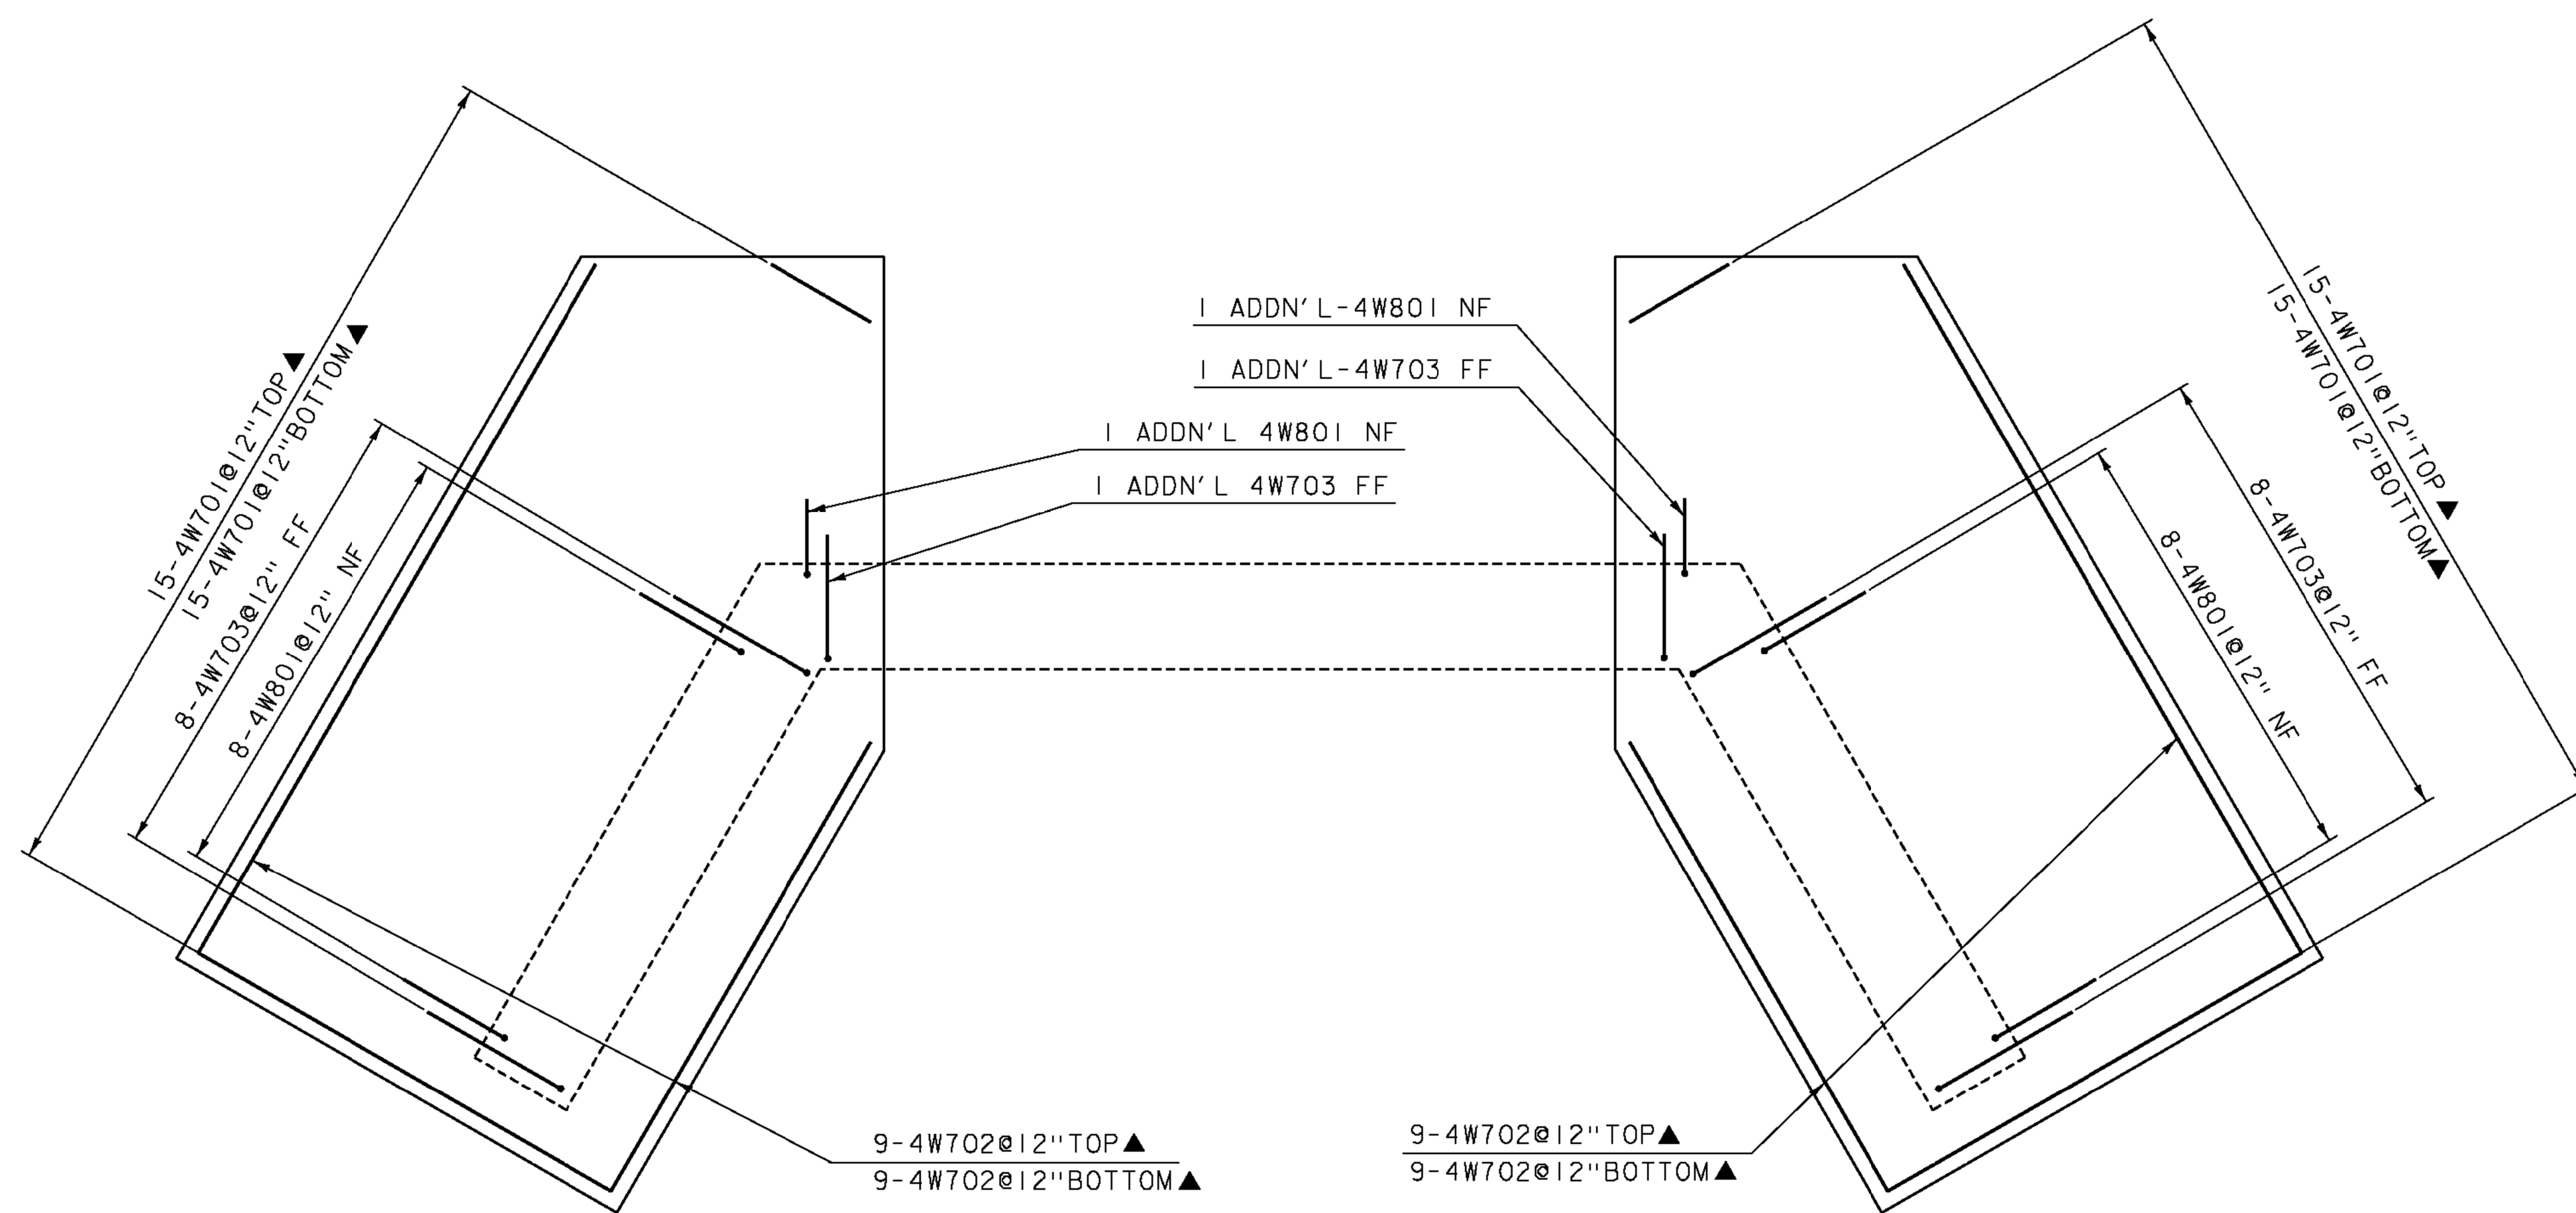


SEE CHANGE ORDER #1

SEE ATTACHED SHOP DRAWINGS
FOR WINGWALL DETAILS

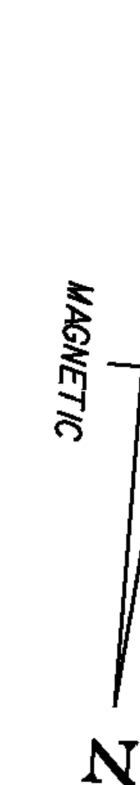

OUTLET FOOTING PLAN
SCALE 1/2" = 1'

NOTE:

- NF = NEAR FACE
- FF = FAR FACE
- EF = EACH FACE
- ▲ = CUT TO FIT IN FIELD
- 3" CLEAR, UNLESS OTHERWISE SPECIFIED ON THE PLANS.
- 2'-2" BAR LAP UNLESS OTHERWISE SPECIFIED ON THE PLANS.



PROJECT NAME: JAMAICA	PLOT DATE: 02/27/2015
PROJECT NUMBER: ER STP 013-2(12)	DRAWN BY: S. SOLLA
FILE NAME: z12b474de+2.dgn	CHECKED BY: B. KHALIFA
PROJECT LEADER: E. ATKINS	FOOTING DETAILS SHEET 2 (BR 82)
DESIGNED BY: B. KHALIFA	SHEET 35 OF 48