


SOIL INFORMATION:
BERKSHIRE AND MARLOW EXTREMELY STONY LOAMS
K-FACTOR = 0.25/0.29, 20%-50% SLOPES
ERODIBILITY: LOW TO MODERATE
HYDROLOGICAL SOIL GROUP: B/C

BEGIN PROJECT
STA. 3+25.00 (MM. 4.783)

BEGIN APPROACH
STA. 3+00.00 (MM. 4.778)
MATCH EXISTING

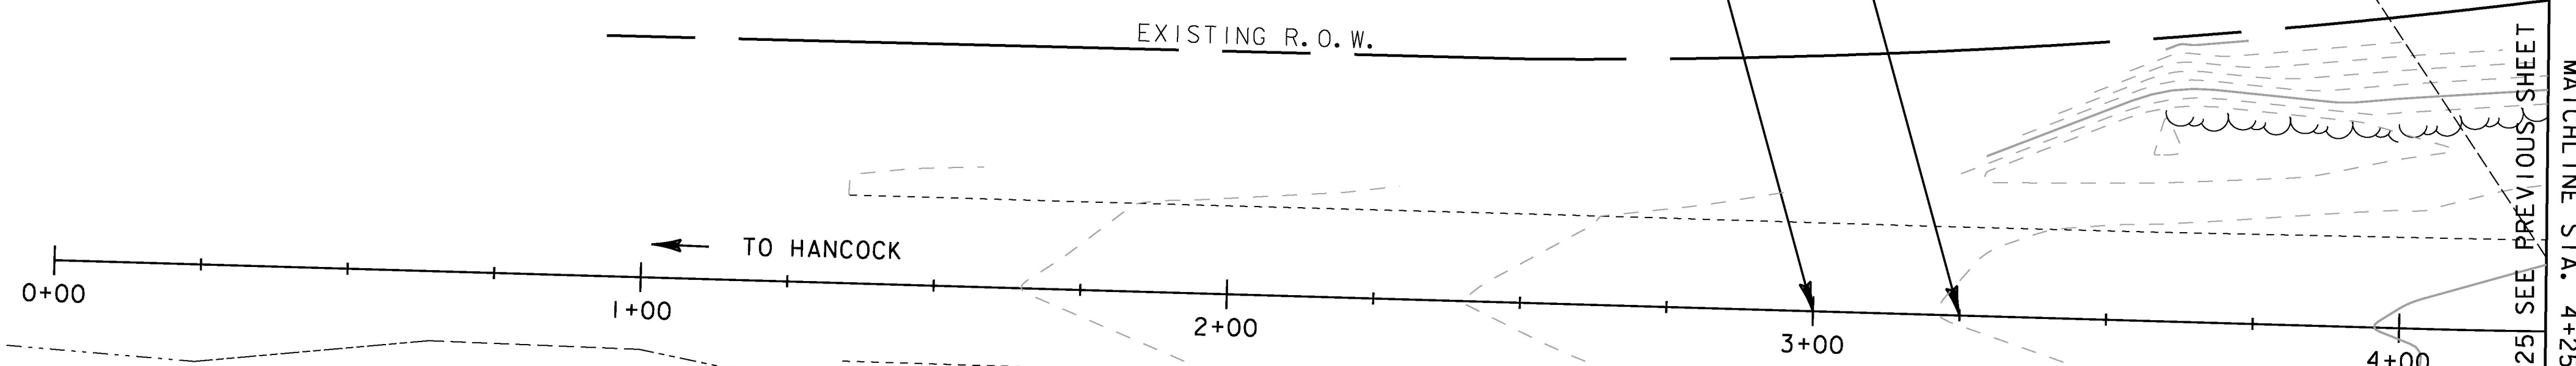

SOIL INFORMATION:
BERKSHIRE AND MARLOW EXTREMELY STONY LOAMS
K-FACTOR = 0.25/0.29, 20%-50% SLOPES
ERODIBILITY: LOW TO MODERATE
HYDROLOGICAL SOIL GROUP: B/C

SOIL INFORMATION:
LYMAN-BERKSHIRE VERY ROCKY COMPLEX
K-FACTOR = 0.27/0.31, 20%-50% SLOPES
ERODIBILITY: LOW TO MODERATE
HYDROLOGICAL SOIL GROUP: D/B



PROJECT NAME: GRANVILLE	PLOT DATE: 7/8/2015
PROJECT NUMBER: ER STP 013-4 (40)	DRAWN BY: B. BRESLEND
FILE NAME: z12b520EPSC_bdr.dgn	CHECKED BY: J. TUCKER
DESIGNED BY: B. BRESLEND	EPSC EXISTING CONDITIONS SHEET 1
SHEET 40 OF 141	