


SOIL INFORMATION:  
LYMAN-BERKSHIRE VERY ROCKY COMPLEX  
K-FACTOR = 0.27/0.31, 20%-50% SLOPES  
ERODIBILITY: LOW TO MODERATE  
HYDROLOGICAL SOIL GROUP: D/B

SOIL INFORMATION:  
BERKSHIRE AND MARLOW EXTREMELY STONY LOAMS  
K-FACTOR = 0.25/0.29, 20%-50% SLOPES  
ERODIBILITY: LOW TO MODERATE  
HYDROLOGICAL SOIL GROUP: B/C

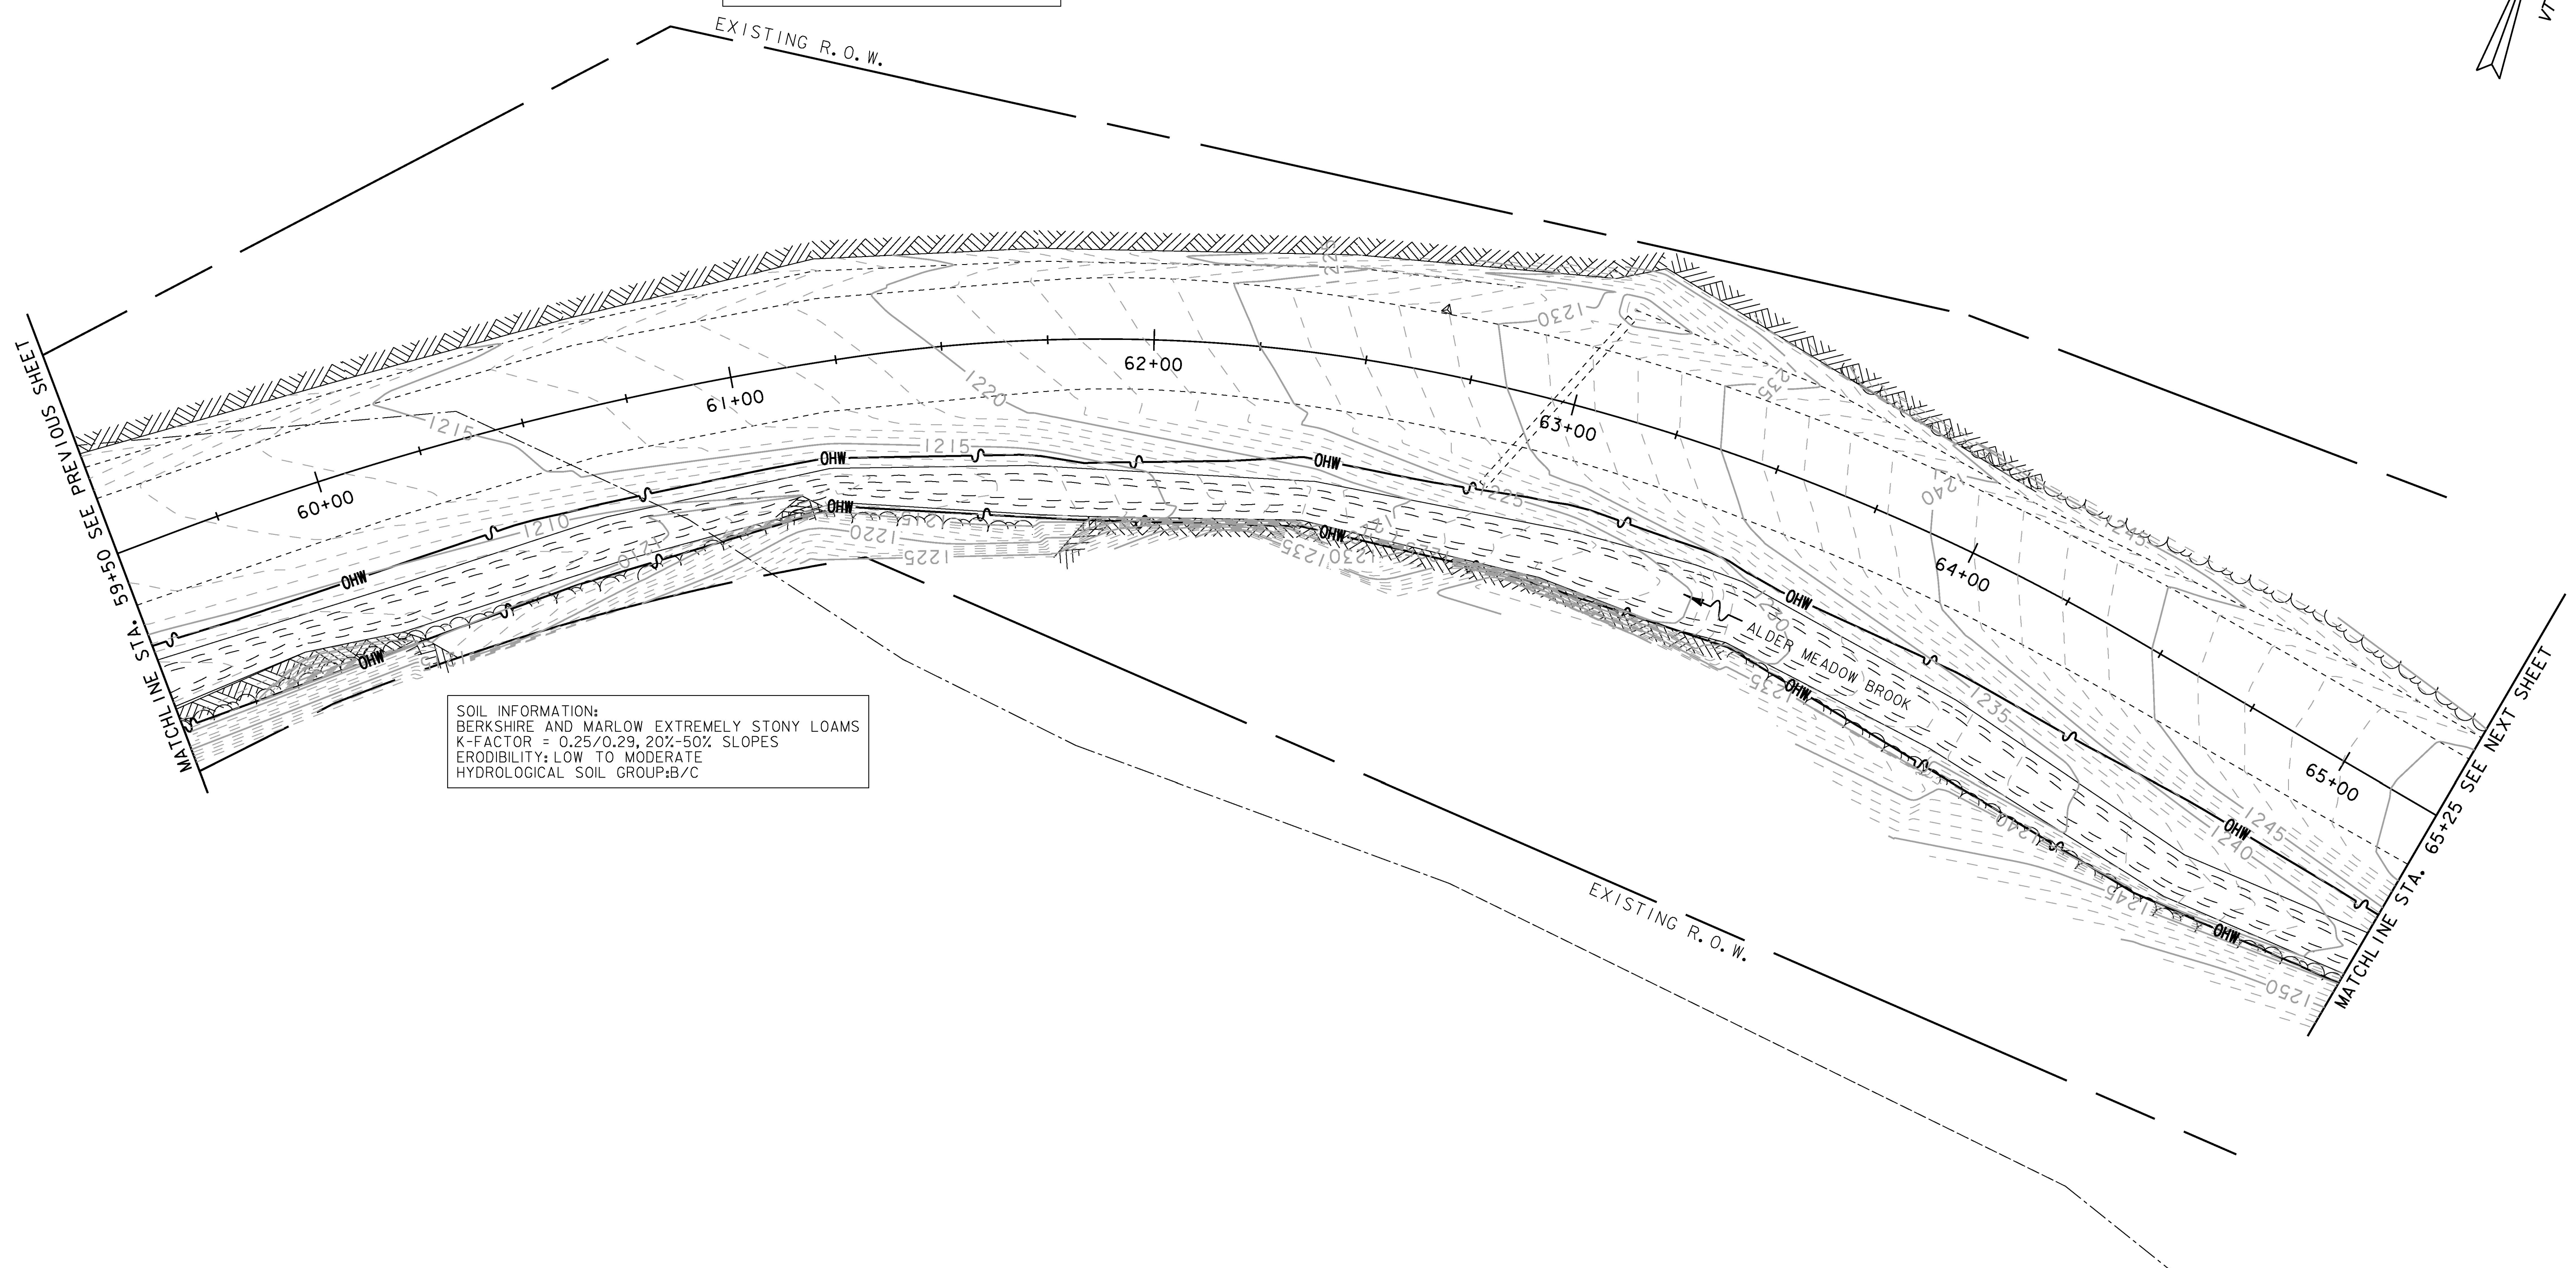

PROJECT NAME: GRANVILLE	PLOT DATE: 7/8/2015
PROJECT NUMBER: ER STP 013-4 (40)	DRAWN BY: B. BRESLEND
FILE NAME: z12b520EPSC_bdr.dgn	DESIGNED BY: B. BRESLEND
PROJECT LEADER: J. TUCKER	CHECKED BY: J. TUCKER
EPSC EXISTING CONDITIONS SHEET 12	SHEET 51 OF 141