

CUT PIPE FLUSH WITH
STONE TOE WALL
(CONSIDERED INCIDENTAL
TO CONTRACT)

BARRIER FENCE
 STA. 23+49.00 - STA. 23+81.00 LT
 STA. 25+52.00 - STA. 25+84.00 LT


INLET PROTECTION DEVICE, TYPE I
 STA. 23+64.76 LT
 STA. 25+68.18 LT

SEED
 STA. 20+25.00 - STA. 25+75.00 RT
 STA. 23+58.78 - STA. 23+70.78 LT
 STA. 25+62.28 - STA. 25+74.07 LT

FERTILIZER
 STA. 20+25.00 - STA. 25+75.00 RT
 STA. 23+58.78 - STA. 23+70.78 LT
 STA. 25+62.28 - STA. 25+74.07 LT

AGRICULTURAL LIMESTONE
 STA. 20+25.00 - STA. 25+75.00 RT
 STA. 23+58.78 - STA. 23+70.78 LT
 STA. 25+62.28 - STA. 25+74.07 LT

TEMPORARY EROSION MATTING
 STA. 20+25.00 - STA. 25+75.00 RT
 STA. 23+58.78 - STA. 23+70.78 LT
 STA. 25+62.28 - STA. 25+74.07 LT

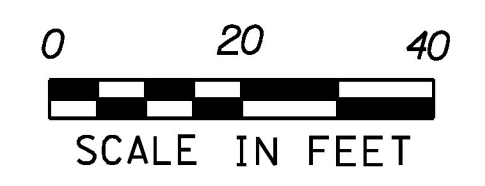

PROJECT NAME: GRANVILLE	PLOT DATE: 7/8/2015
PROJECT NUMBER: ER STP 013-4 (40)	DRAWN BY: B. BRESLEND
FILE NAME: z12b520EPSC_bdr.dgn	CHECKED BY: J. TUCKER
DESIGNED BY: B. BRESLEND	EPSC CONSTRUCTION COND. SHEET 5
	SHEET 57 OF 141