


- SEED
STA. 59+50.00 - STA. 65+25.00 RT
- FERTILIZER
STA. 59+50.00 - STA. 65+25.00 RT
- AGRICULTURAL LIMESTONE
STA. 59+50.00 - STA. 65+25.00 RT
- TEMPORARY EROSION MATTING
STA. 59+50.00 - STA. 65+25.00 RT

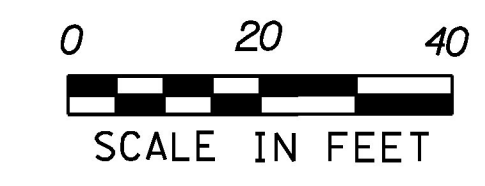

PROJECT NAME: GRANVILLE	PLOT DATE: 7/8/2015
PROJECT NUMBER: ER STP 013-4 (40)	DRAWN BY: B. BRESLEND
FILE NAME: z12b520EPSC_bdr.dgn	CHECKED BY: J. TUCKER
DESIGNED BY: B. BRESLEND	SHEET 64 OF 141
EPSC CONSTRUCTION COND. SHEET 12	