


END APPROACH  
STA. 71+00.00 (MM. 6.066)  
MATCH EXISTING

END PROJECT  
STA. 70+75.00 (MM. 6.061)

MATCH LINE STA. 65+25 SEE PREVIOUS SHEET

EXISTING R.O.W.

TO WARREN

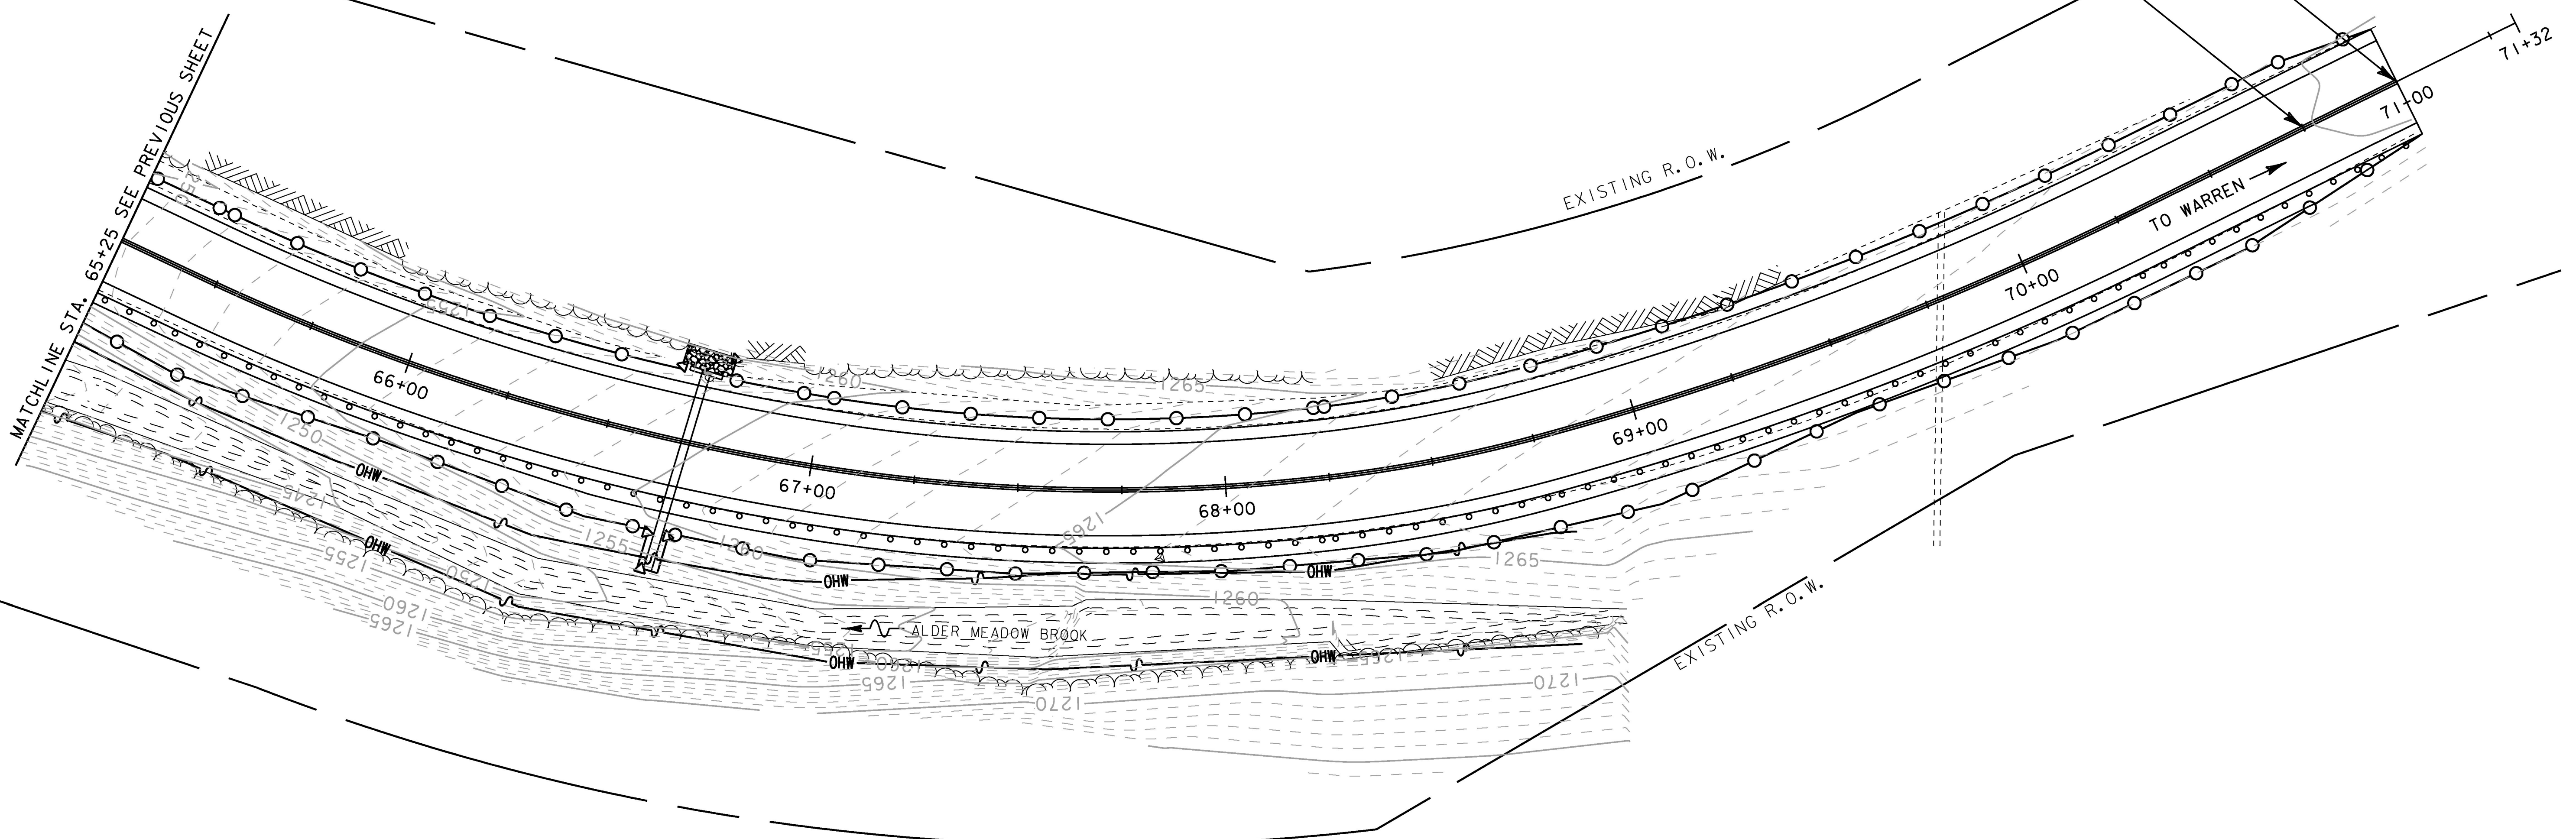

PROJECT NAME: GRANVILLE	PLOT DATE: 7/8/2015
PROJECT NUMBER: ER STP 013-4 (40)	DRAWN BY: B. BRESLEND
FILE NAME: z12b520EPSC_bdr.dgn	CHECKED BY: J. TUCKER
DESIGNED BY: B. BRESLEND	SHEET 78 OF 141
EPSC FINAL CONDITIONS SHEET 13	