



3+50


STA. 3+25.00
BEGIN PROJECT

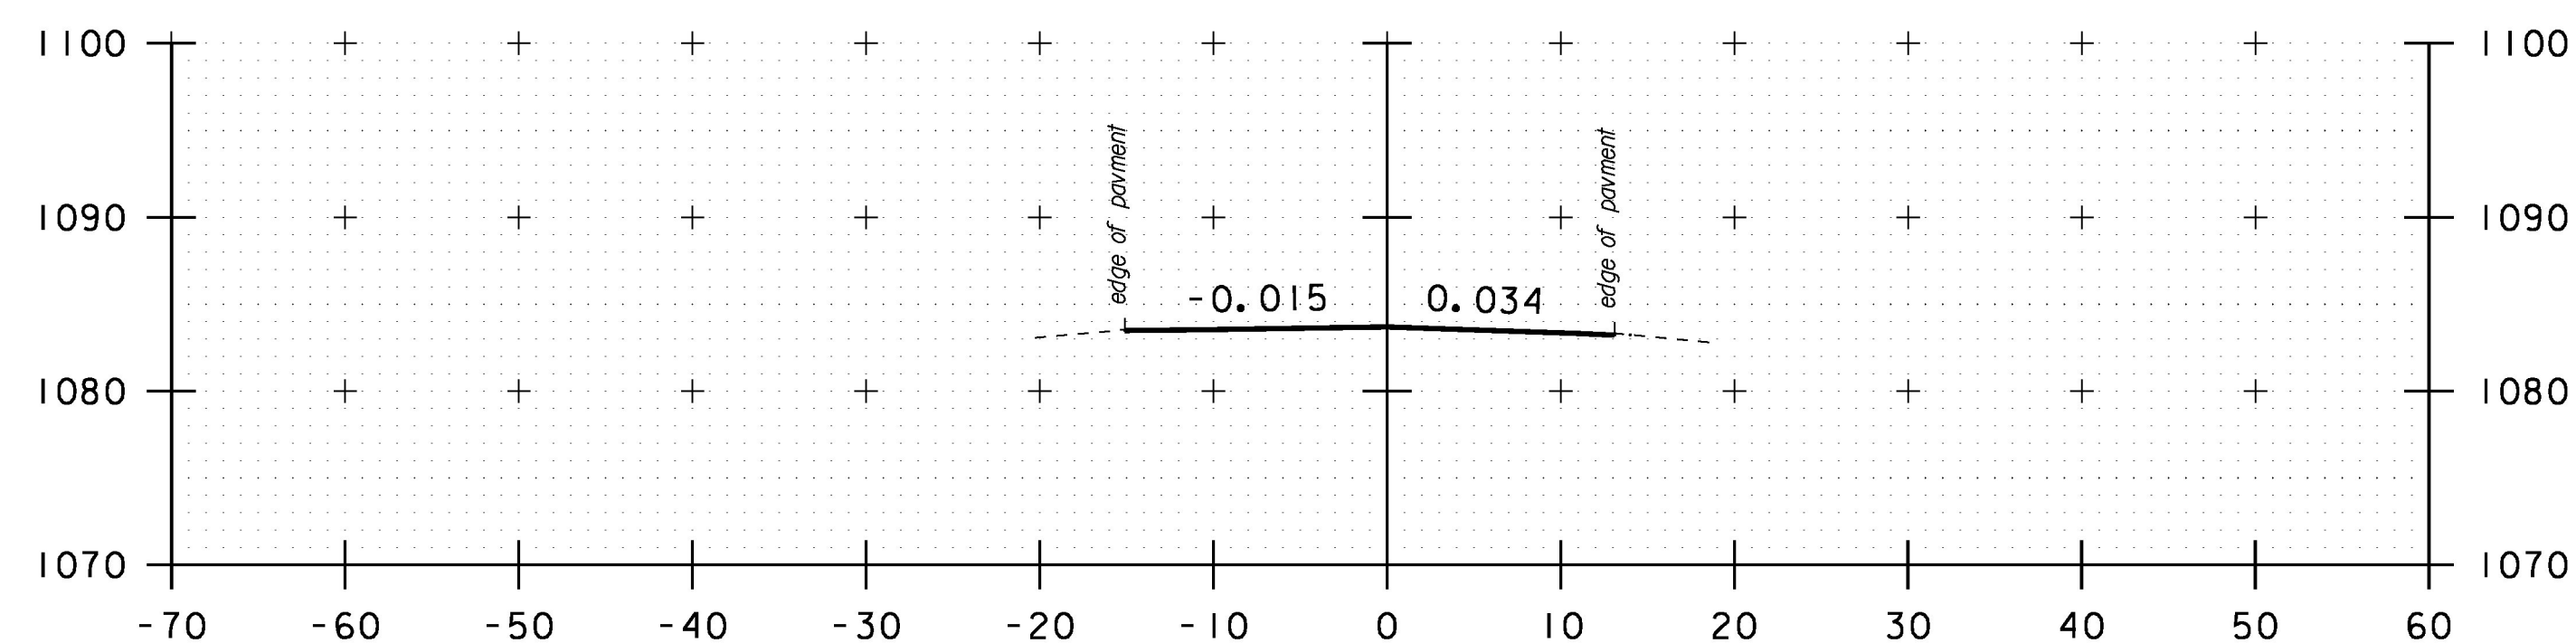


BEGIN APPROACH
MATCH EXISTING
3+00

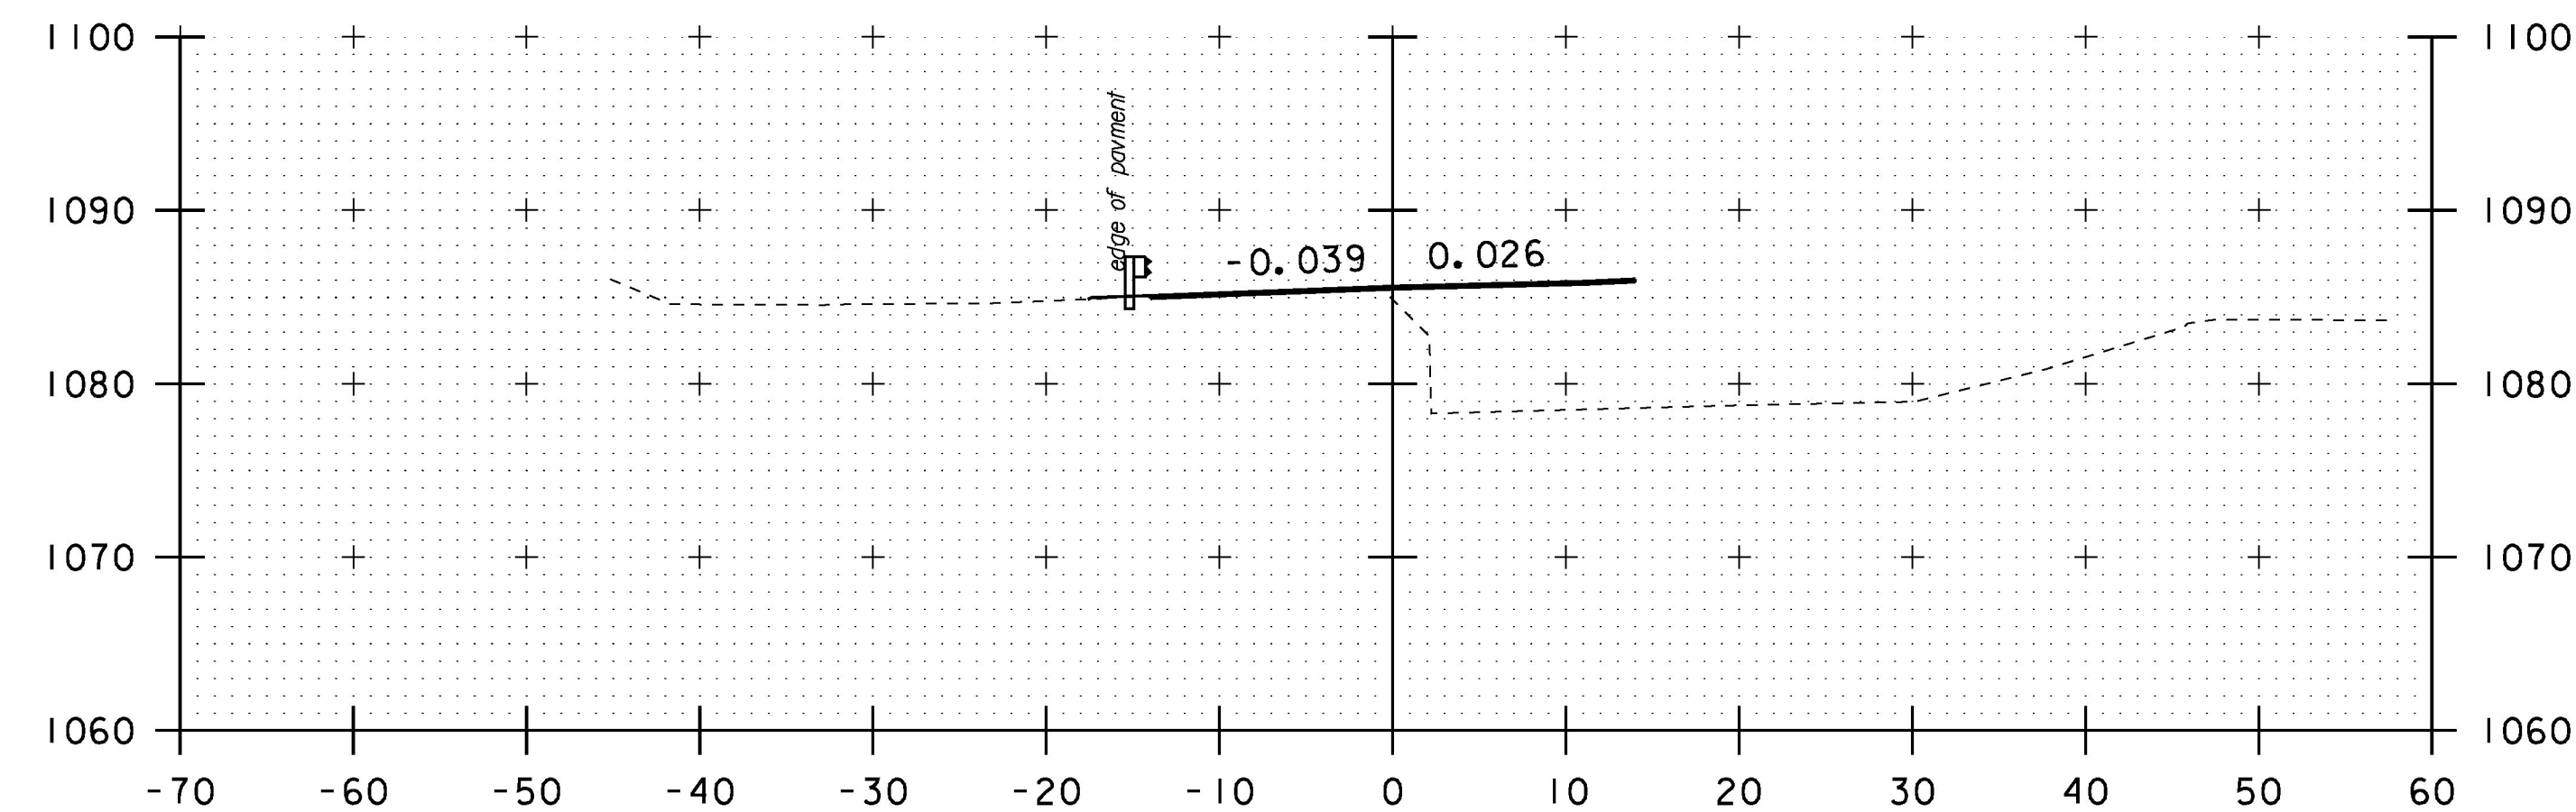

4+50

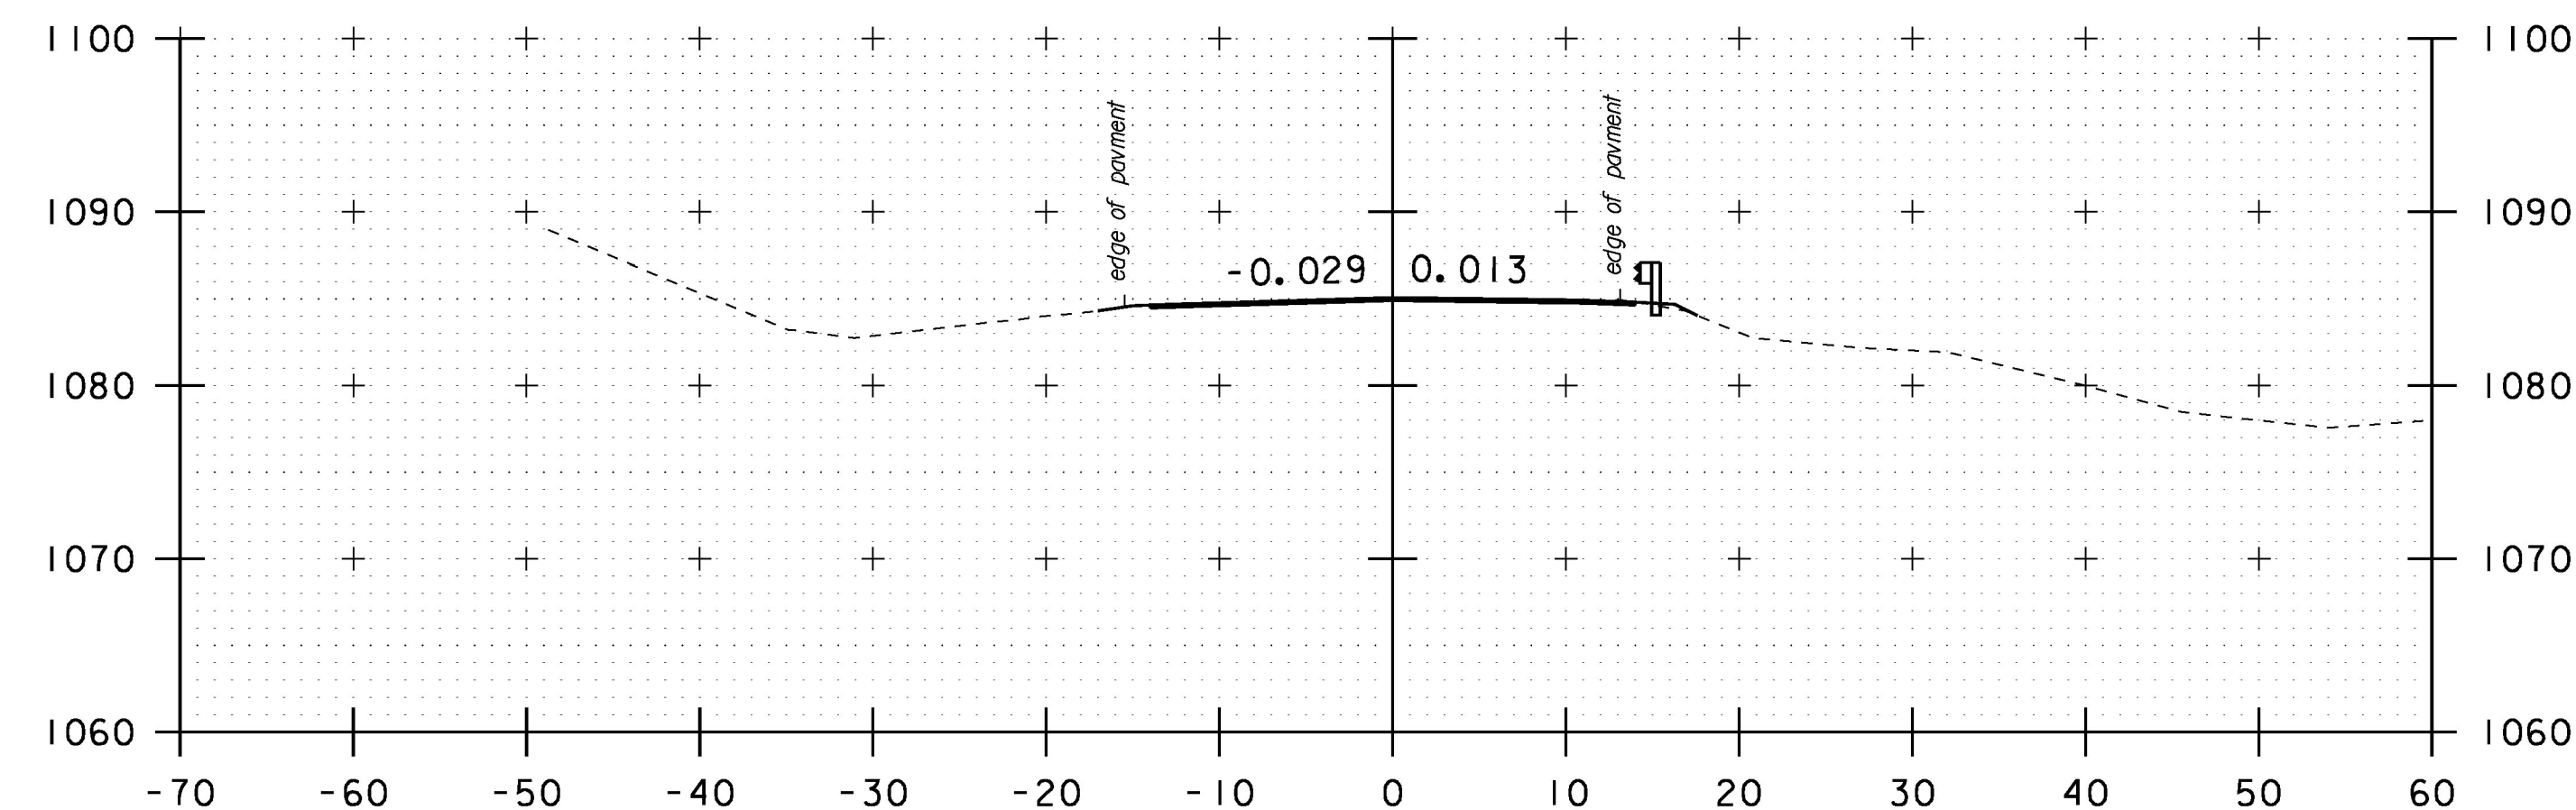

4+00

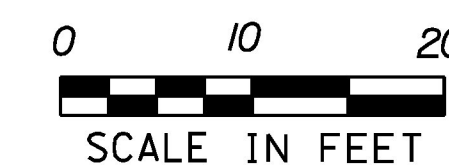

STA. 3+00 TO STA. 4+50

PROJECT NAME: GRANVILLE
PROJECT NUMBER: ER STP 013-4 (40)

FILE NAME: z12b520xs.dgn PLOT DATE: 7/8/2015
PROJECT LEADER: J. TUCKER DRAWN BY: B. BRESLEND
DESIGNED BY: B. BRESLEND CHECKED BY: A. SANZ
VT 100 CROSS SECTION SHEET 1 SHEET 88 OF 141