




7+50

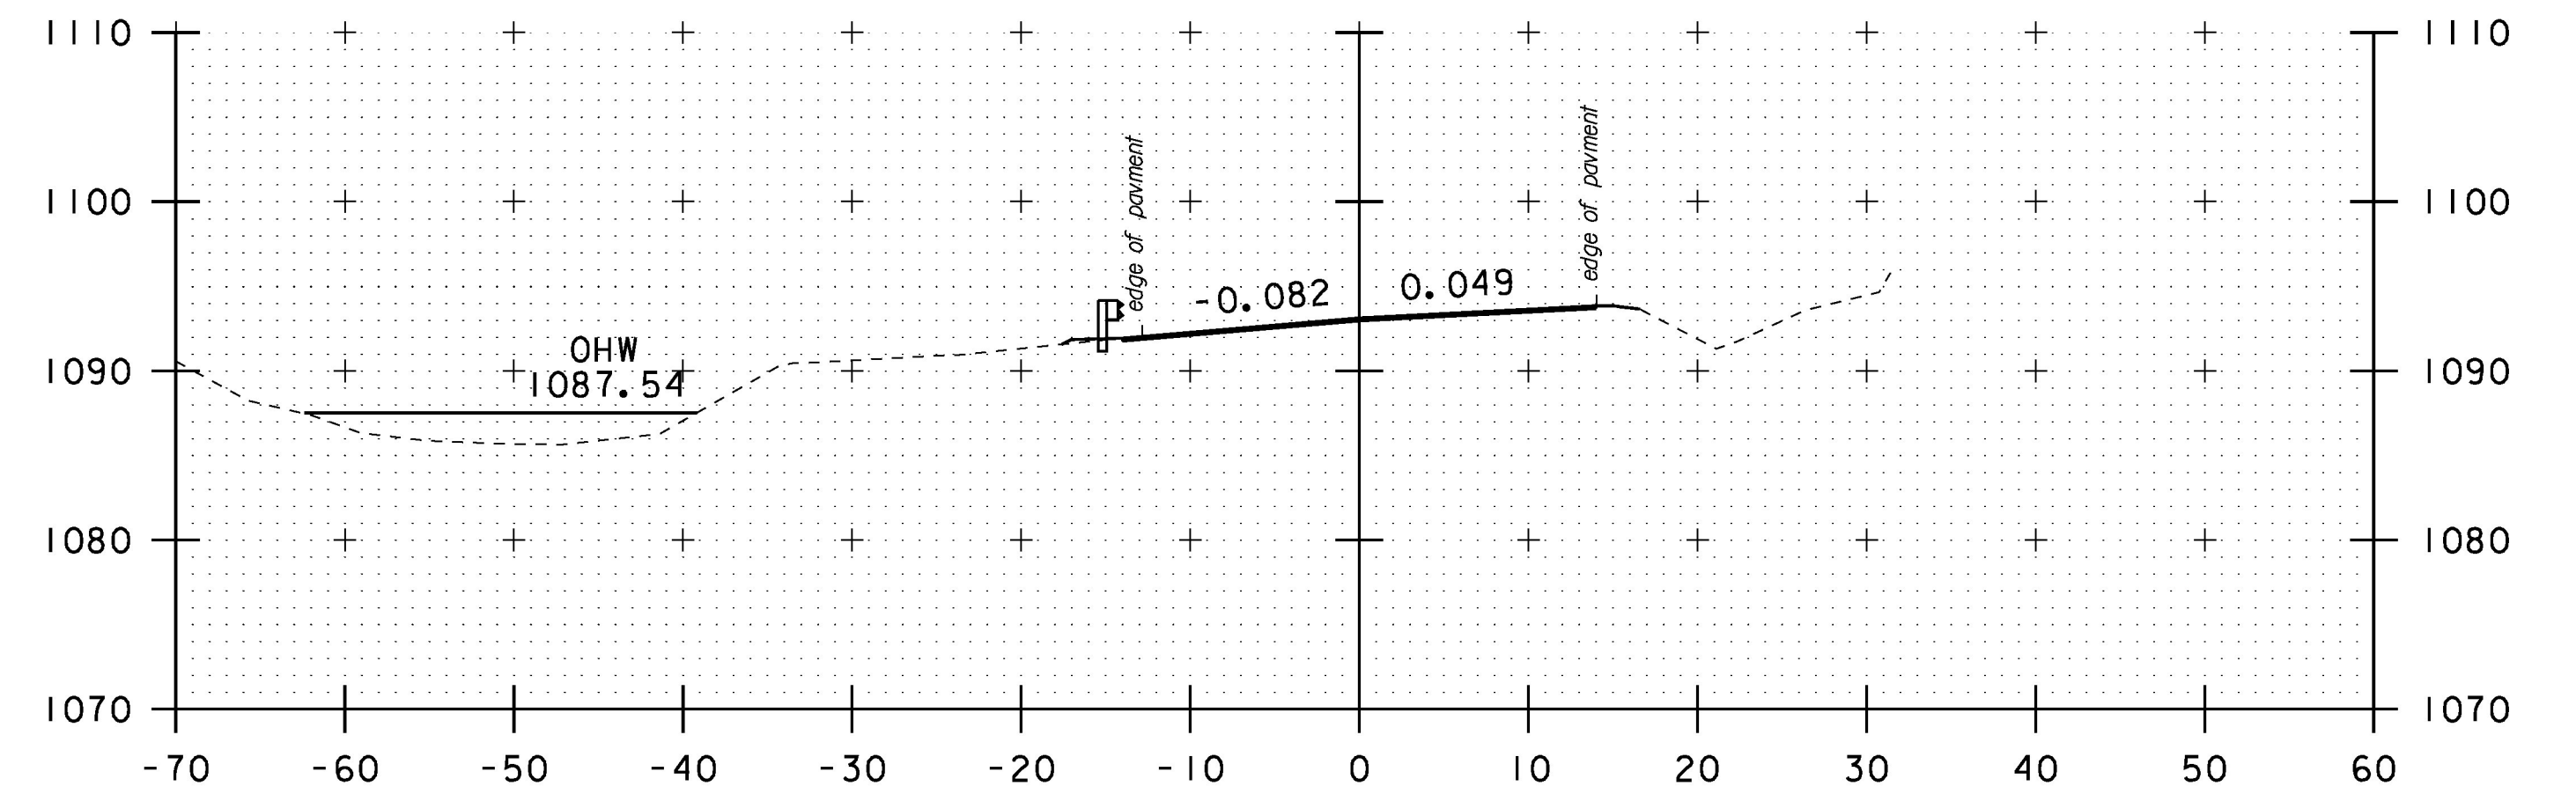


8+50

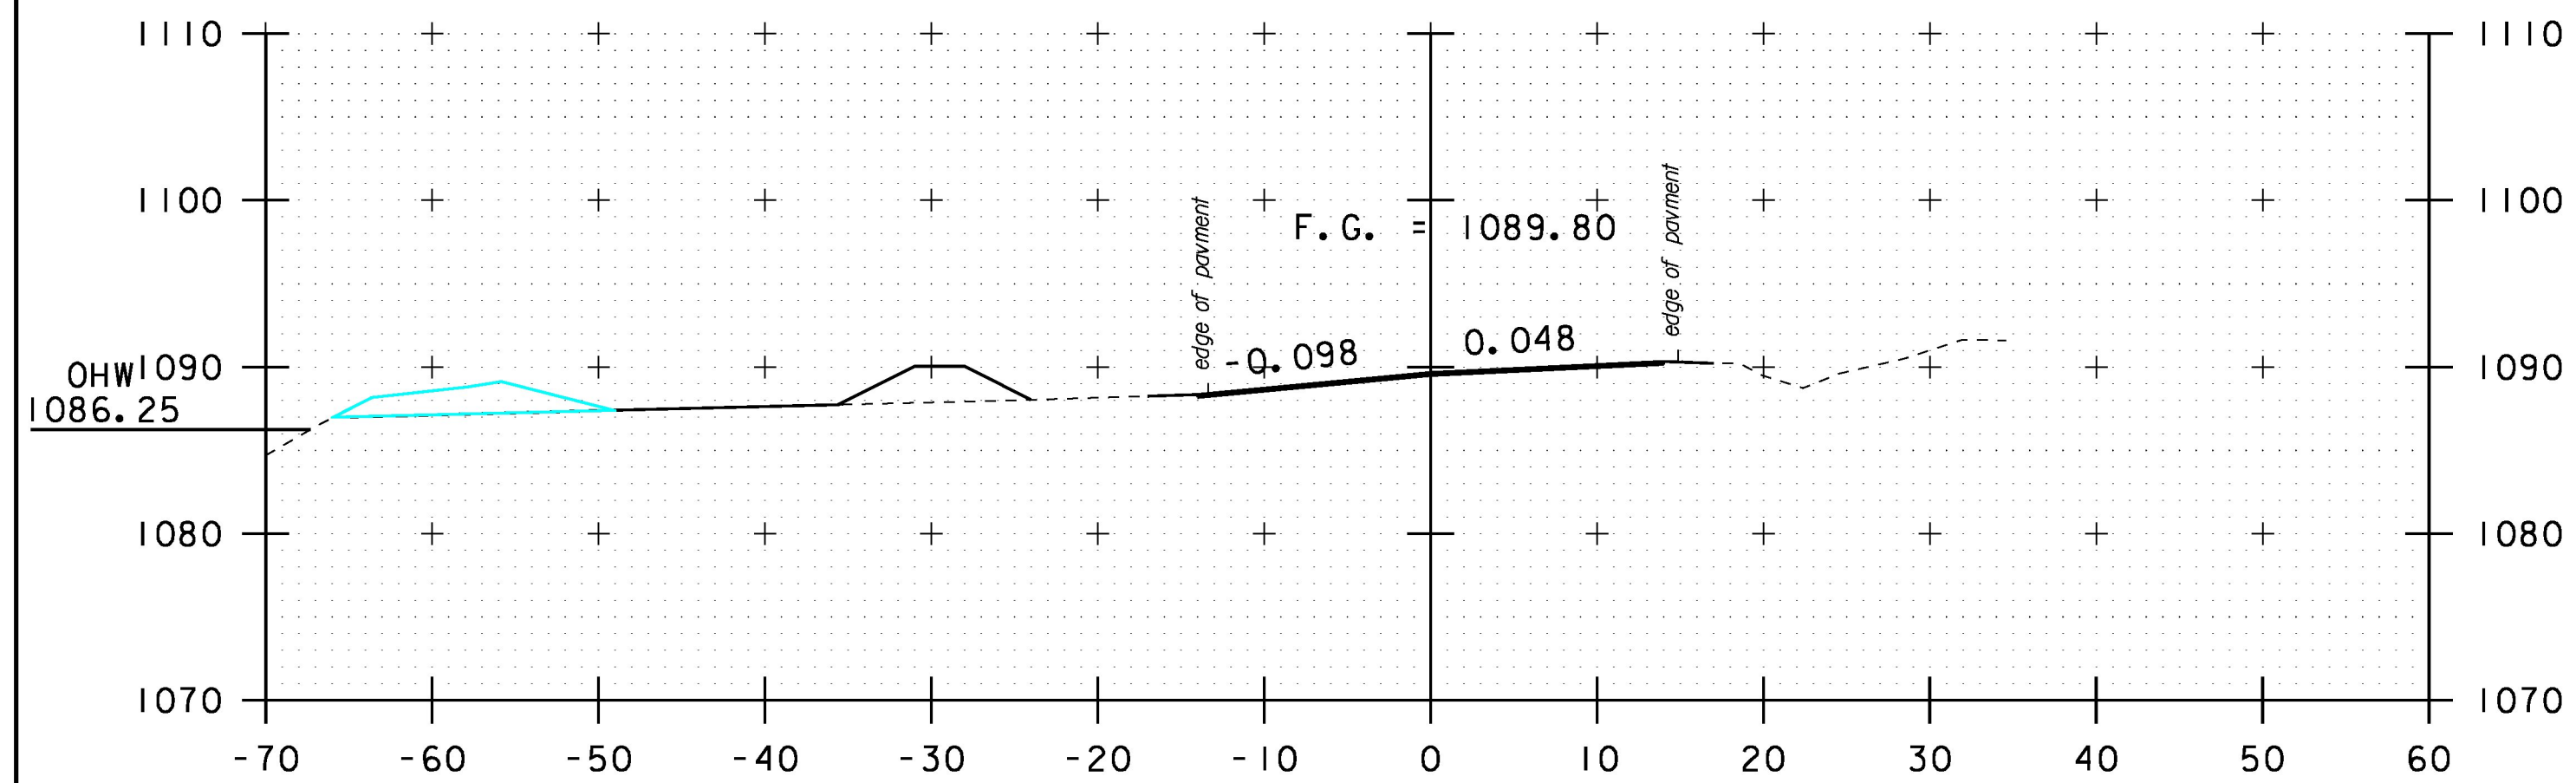

7+00

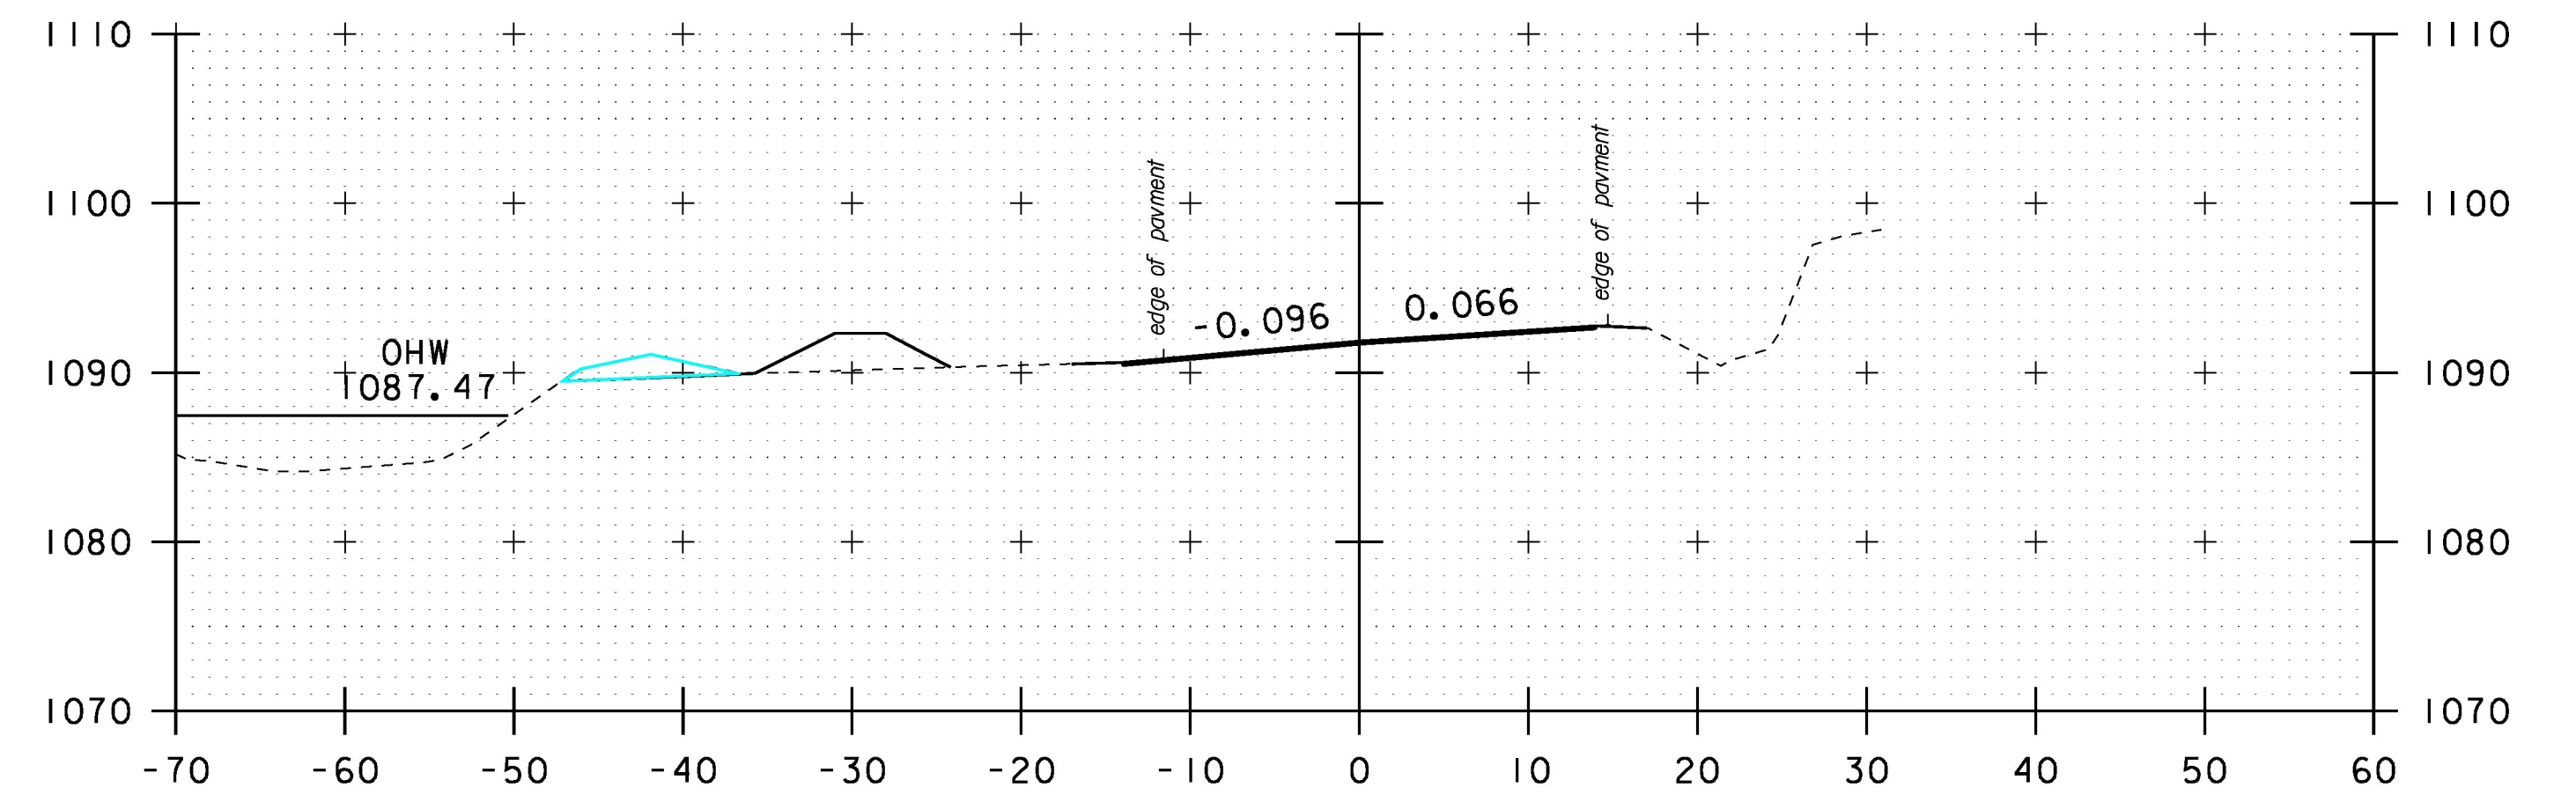

8+00

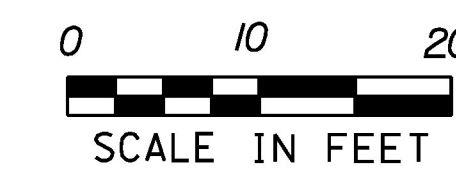

STA. 7+00 TO STA. 8+50

PROJECT NAME: GRANVILLE
PROJECT NUMBER: ER STP 013-4 (40)

FILE NAME: z12b520xs.dgn	PLOT DATE: 7/8/2015
PROJECT LEADER: J. TUCKER	DRAWN BY: B. BRESLEND
DESIGNED BY: B. BRESLEND	CHECKED BY: A. SANZ
VT 100 CROSS SECTION SHEET 3	SHEET 90 OF 141