




9+50

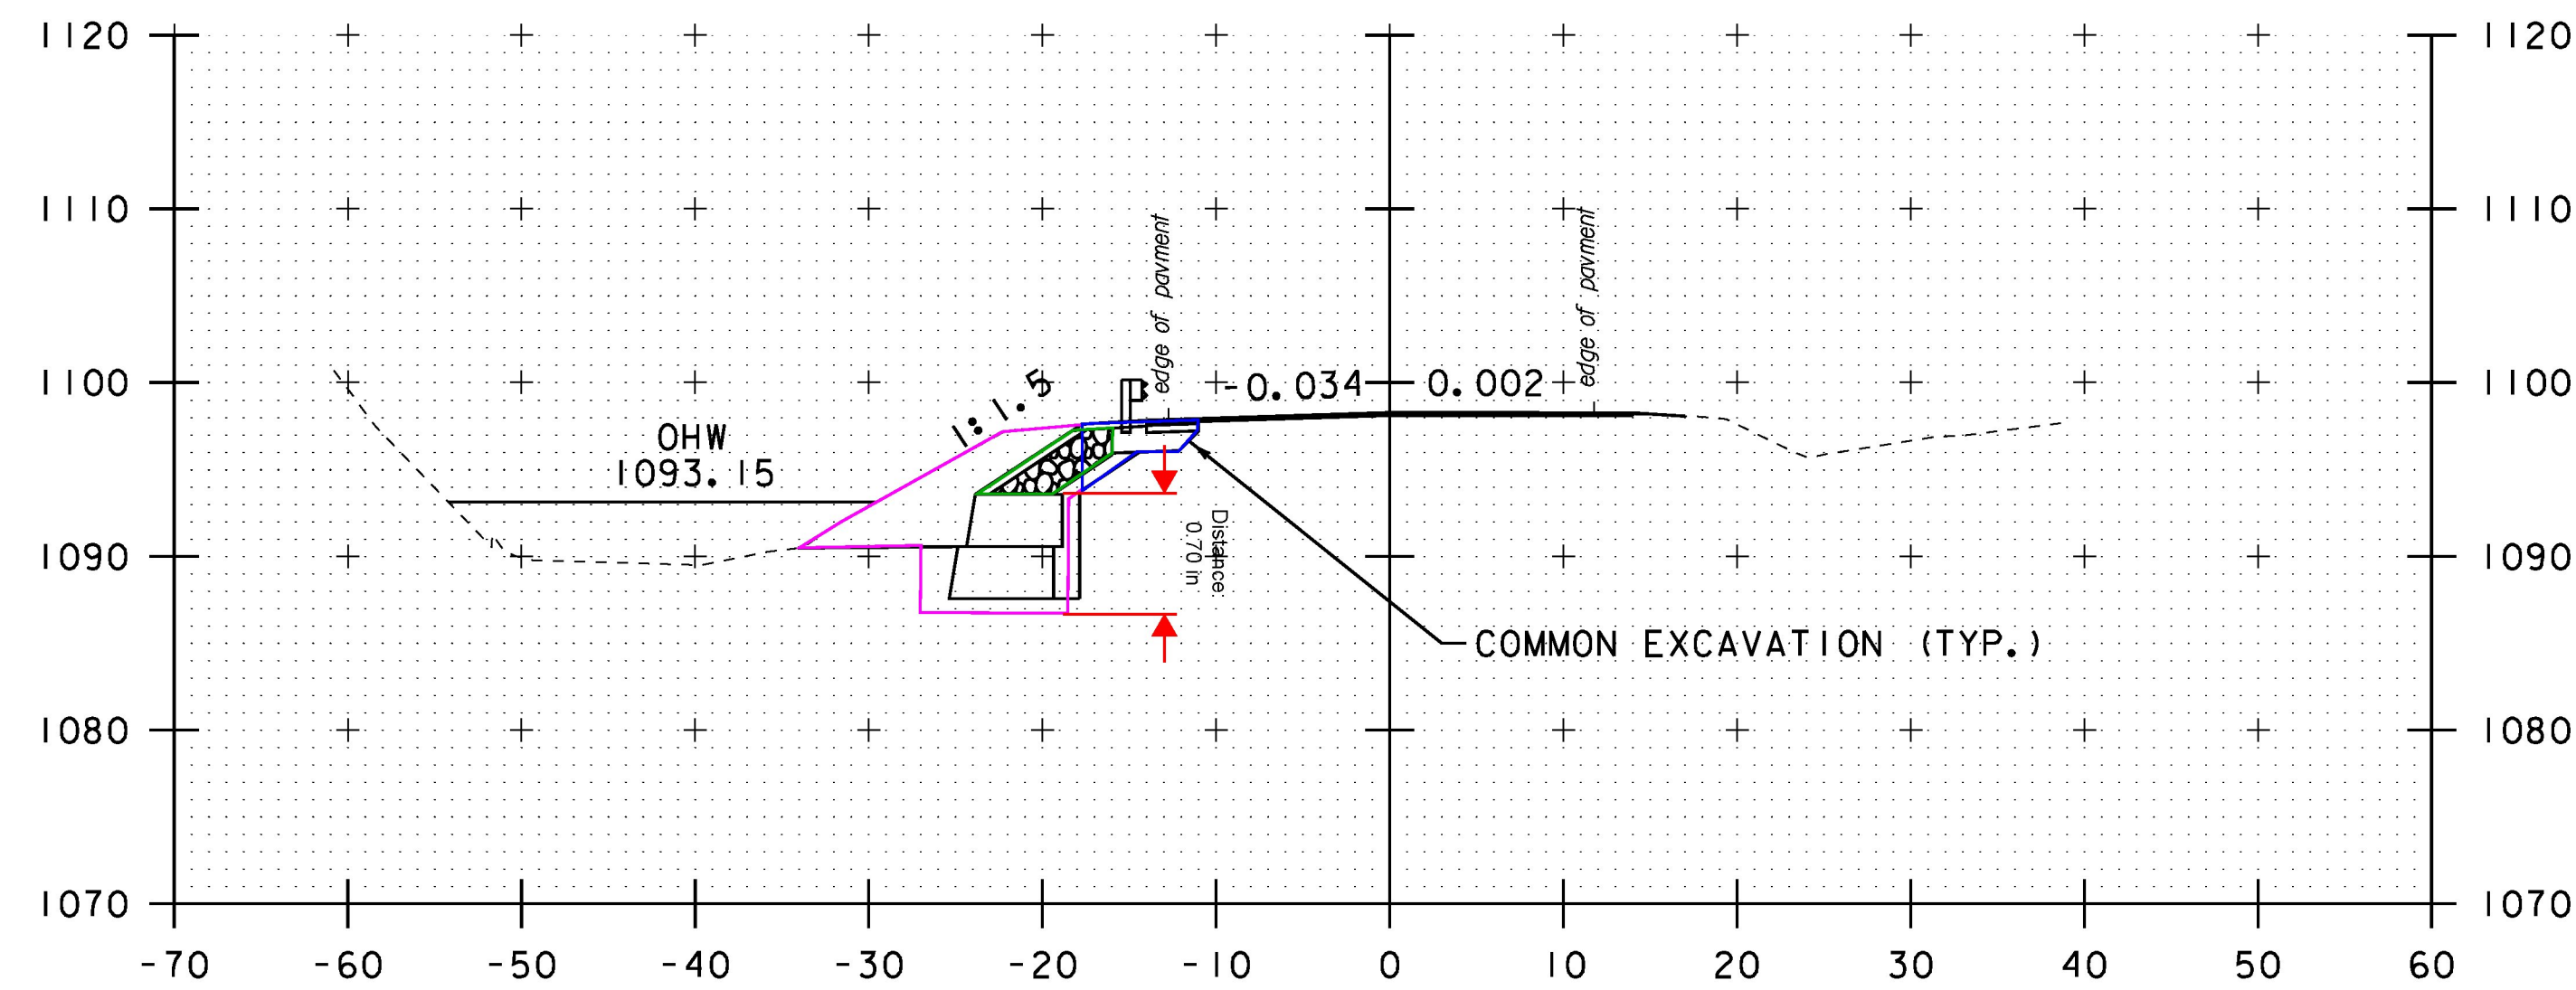

10+50

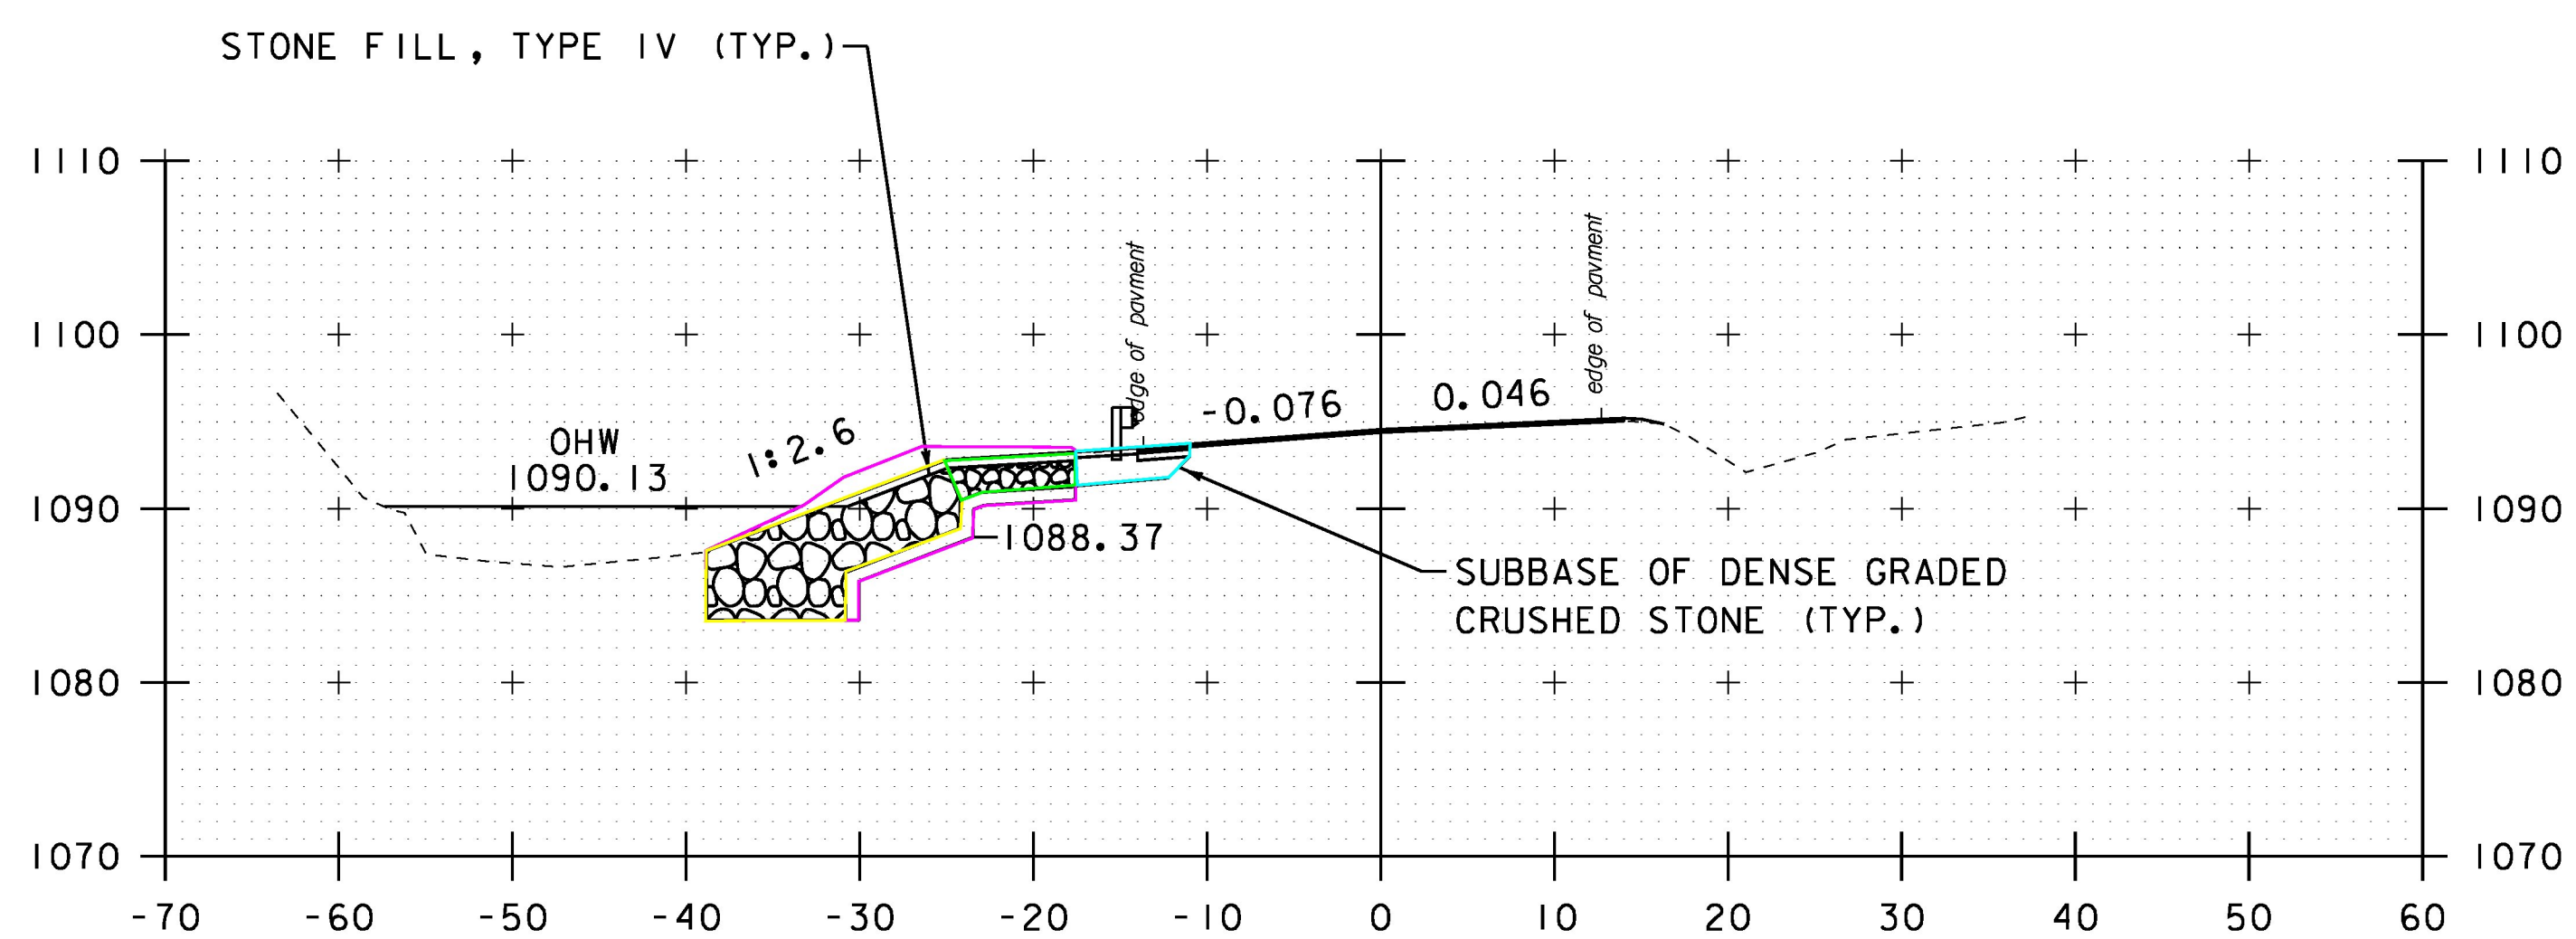


9+00

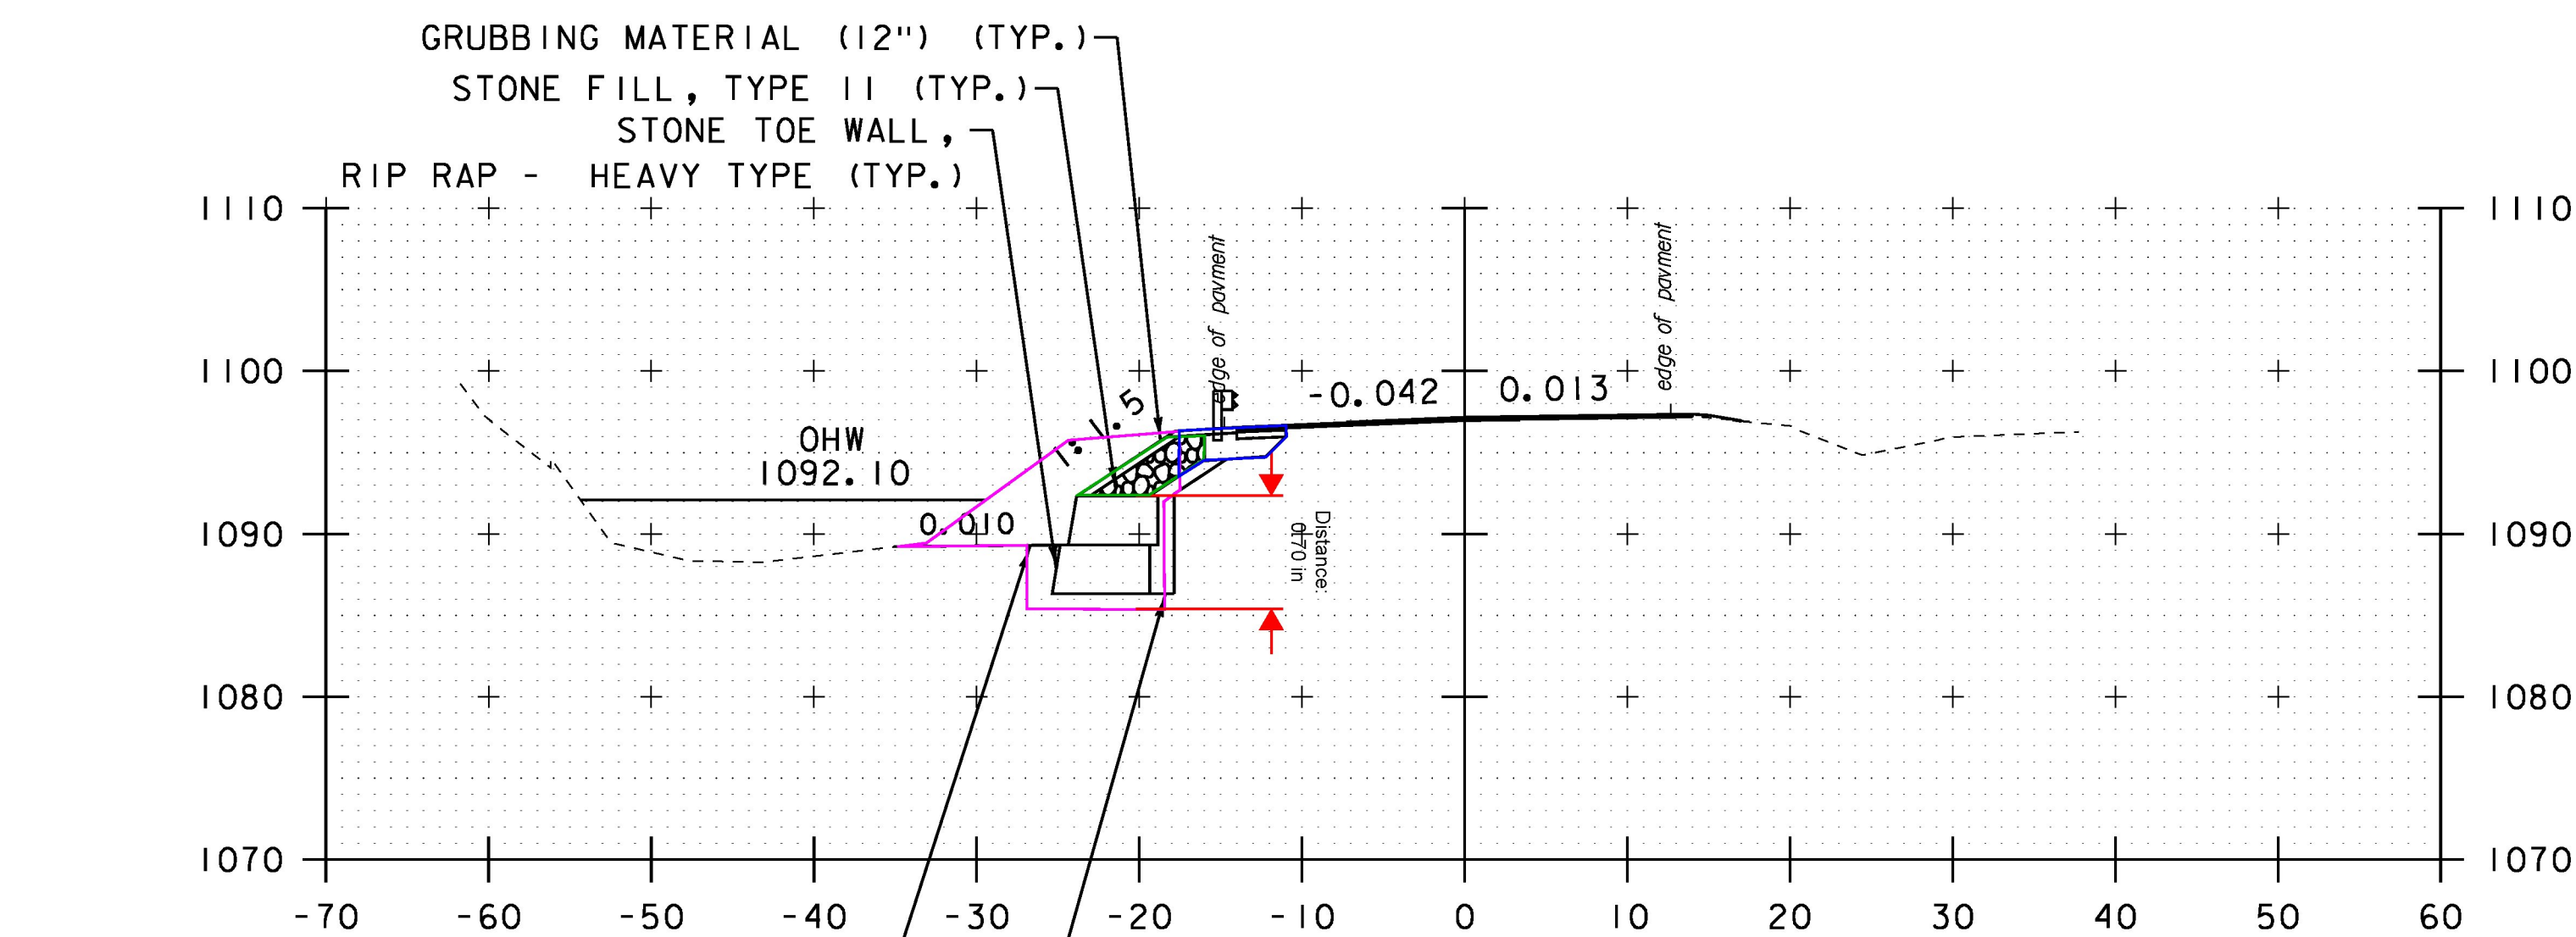

10+00

STA. 9+80.00 LT
BEGIN STONE TOE WALL

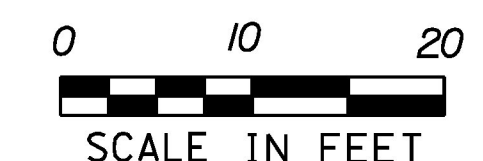

STA. 9+00 TO STA. 10+50	
PROJECT NAME:	GRANVILLE
PROJECT NUMBER:	ER STP 013-4 (40)
FILE NAME:	z12b520xs.dgn
PROJECT LEADER:	J. TUCKER
DESIGNED BY:	B. BRESLEND
VT 100 CROSS SECTION SHEET 4	PLOT DATE: 7/8/2015
	DRAWN BY: B. BRESLEND
	CHECKED BY: A. SANZ
	SHEET 91 OF 141