




19+50

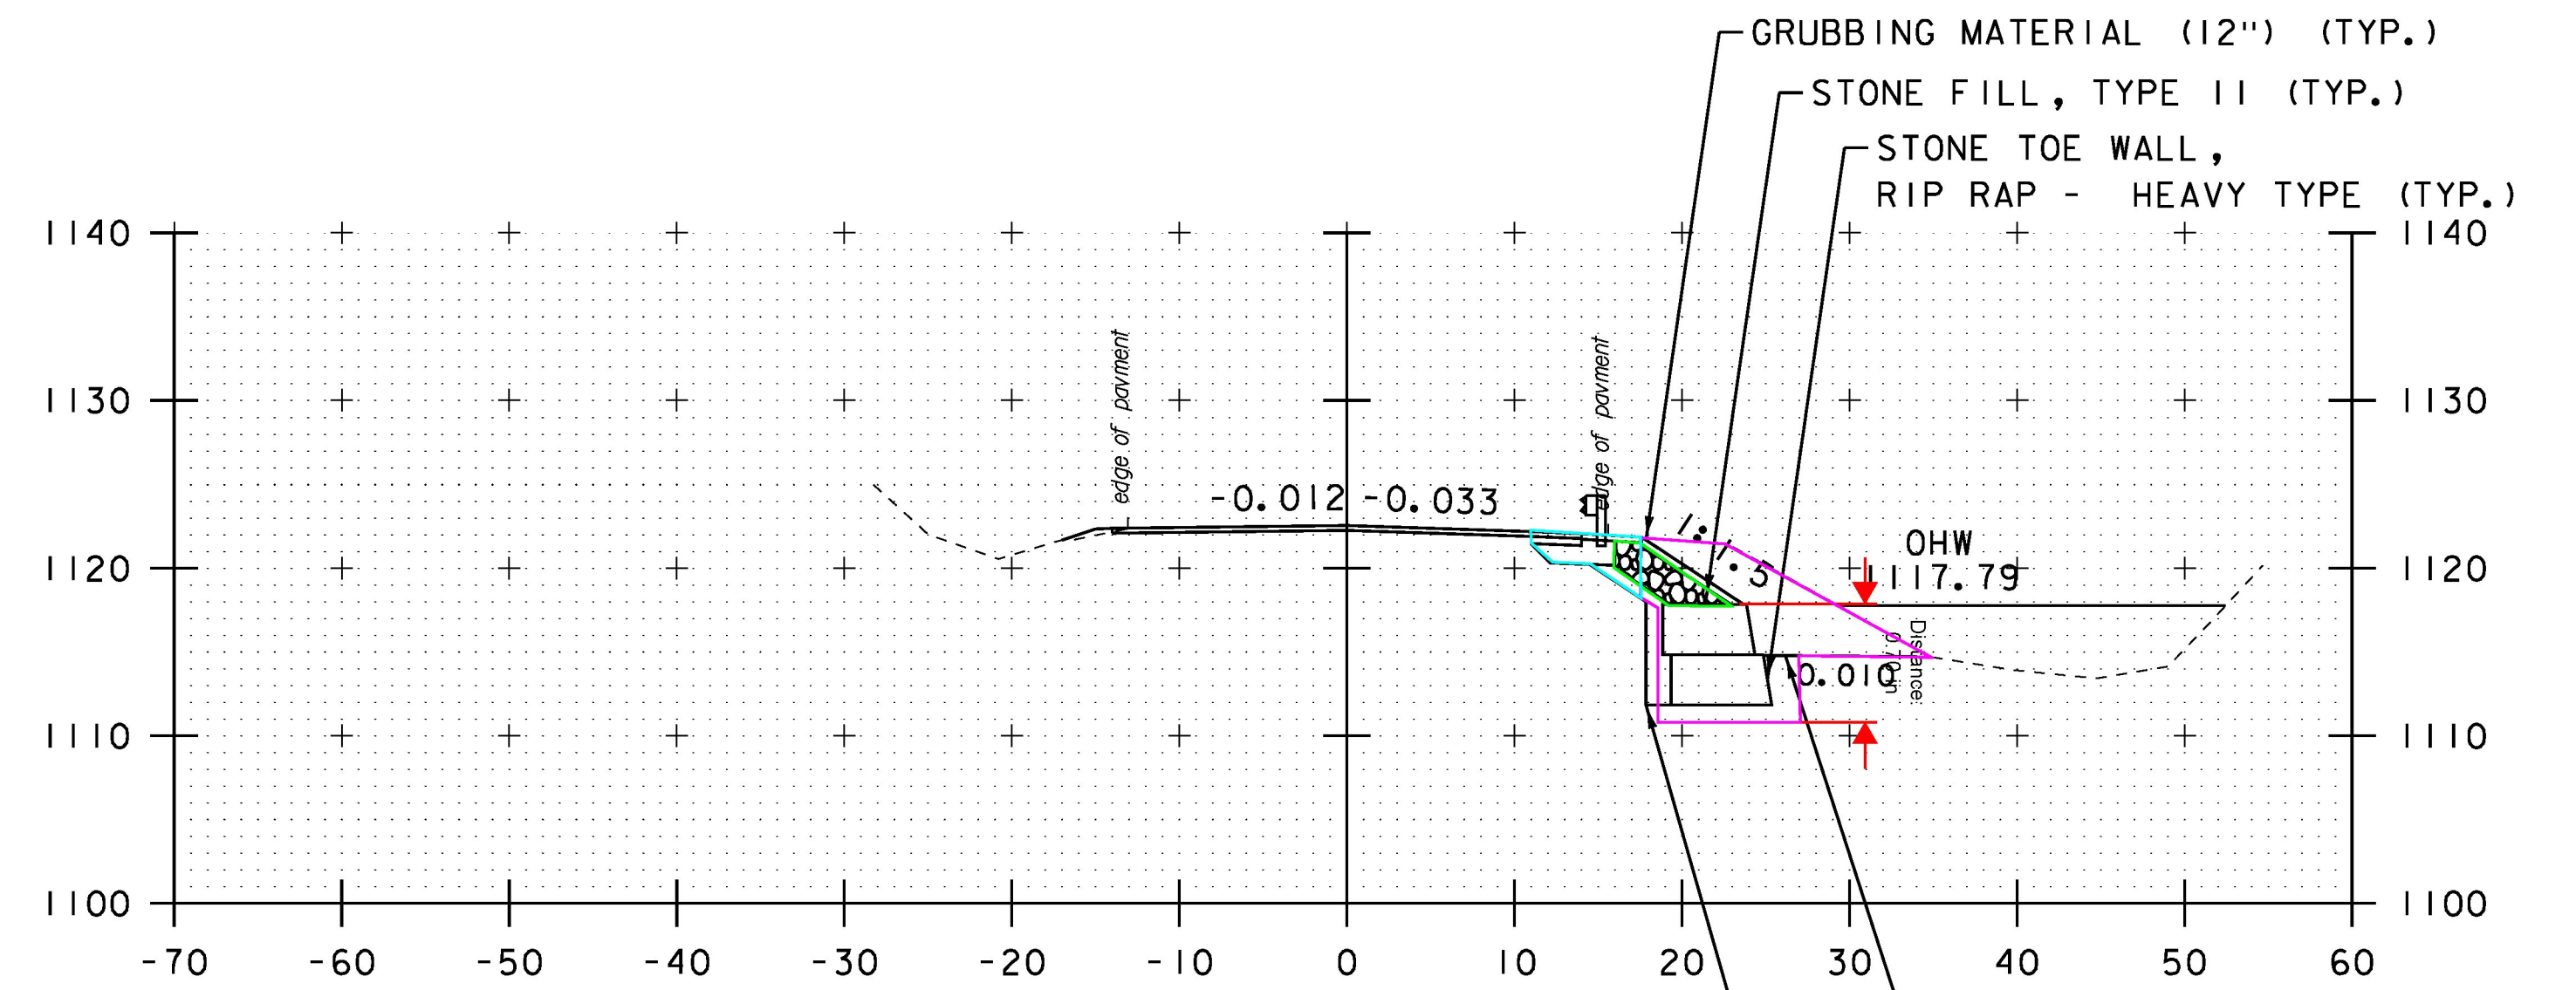


20+50

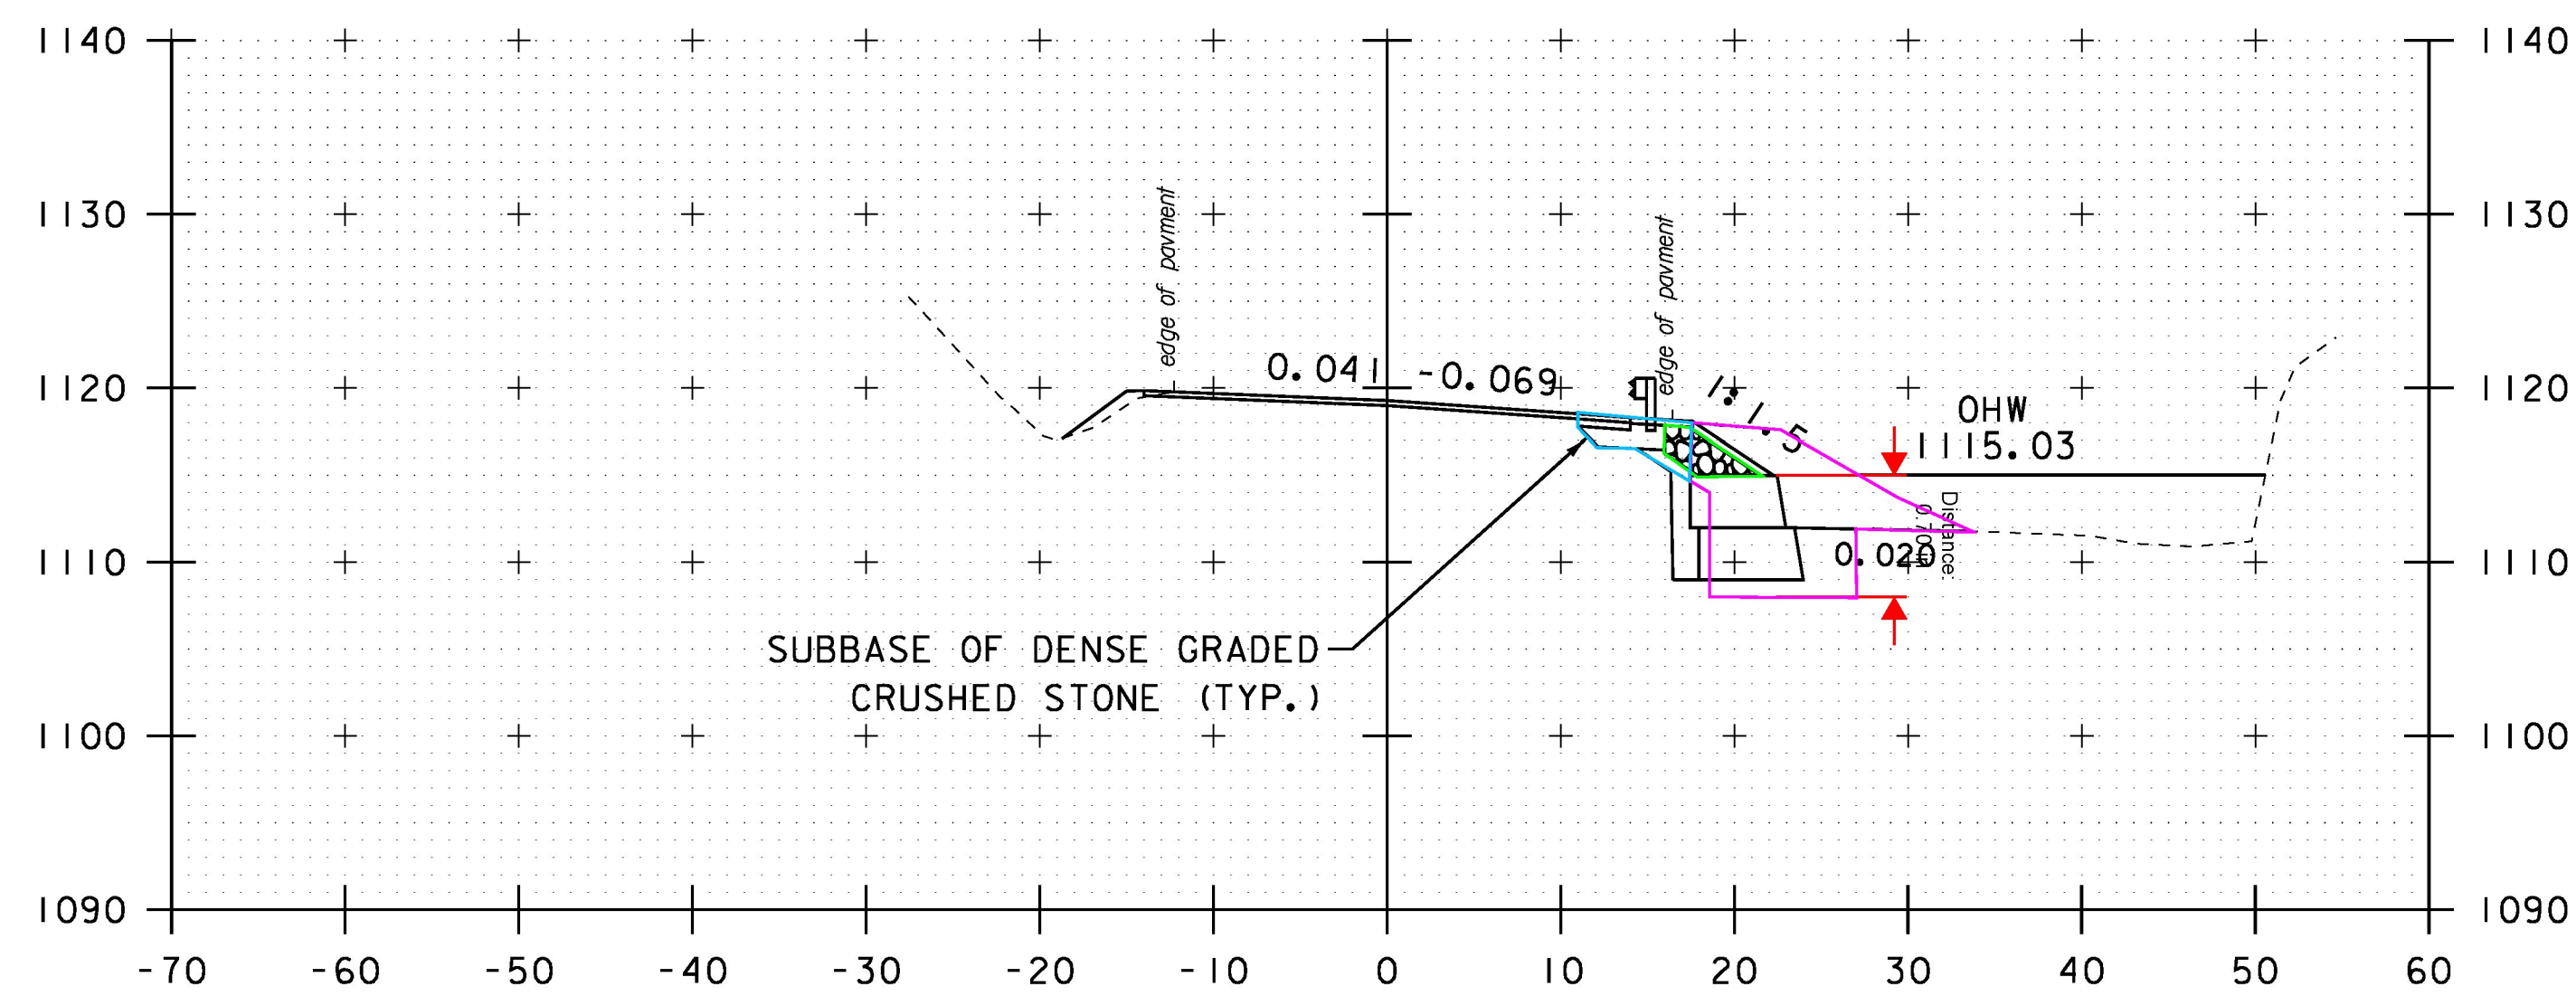

19+00

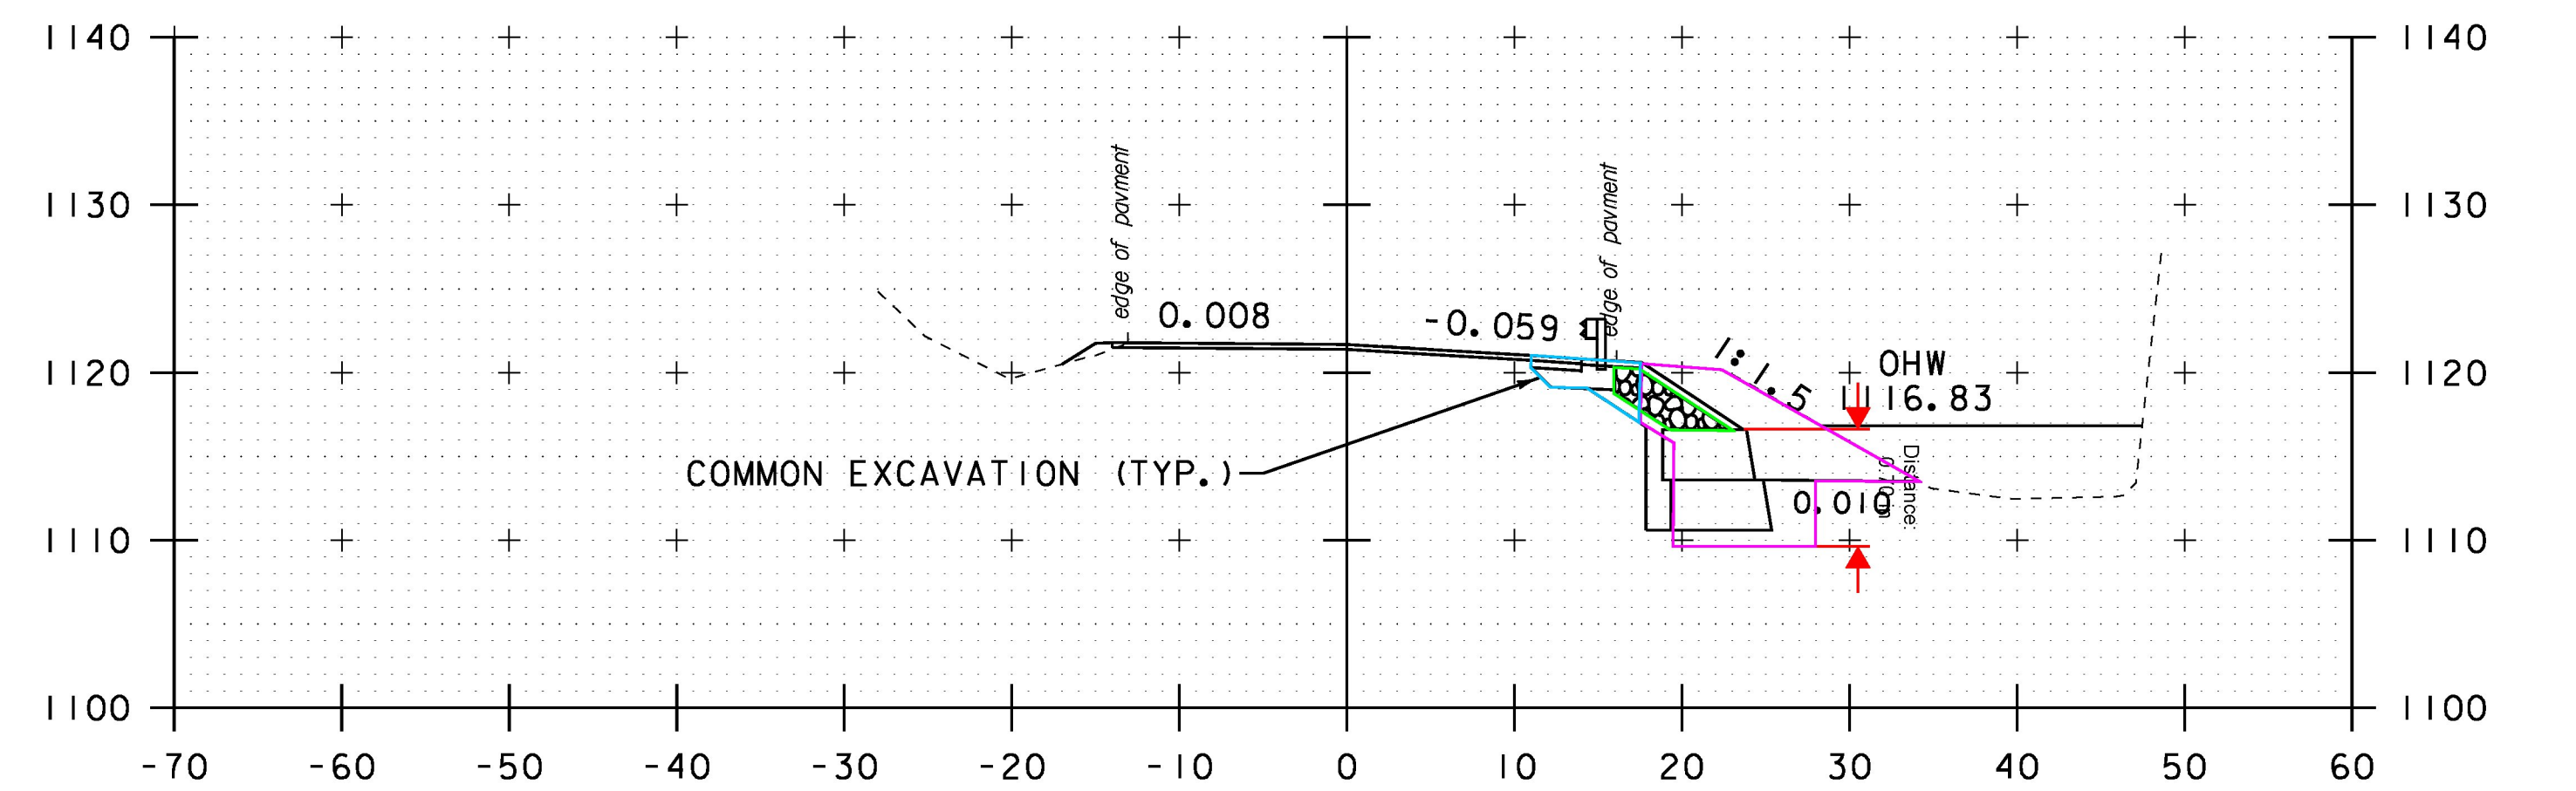

20+00

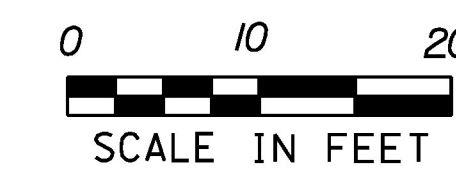

STA. 19+00 TO STA. 20+50

PROJECT NAME: GRANVILLE  
PROJECT NUMBER: ER STP 013-4 (40)

FILE NAME: z12b520xs.dgn PLOT DATE: 7/8/2015  
PROJECT LEADER: J. TUCKER DRAWN BY: B. BRESLEND  
DESIGNED BY: B. BRESLEND CHECKED BY: A. SANZ  
VT 100 CROSS SECTION SHEET 9 SHEET 96 OF 141