




31+50

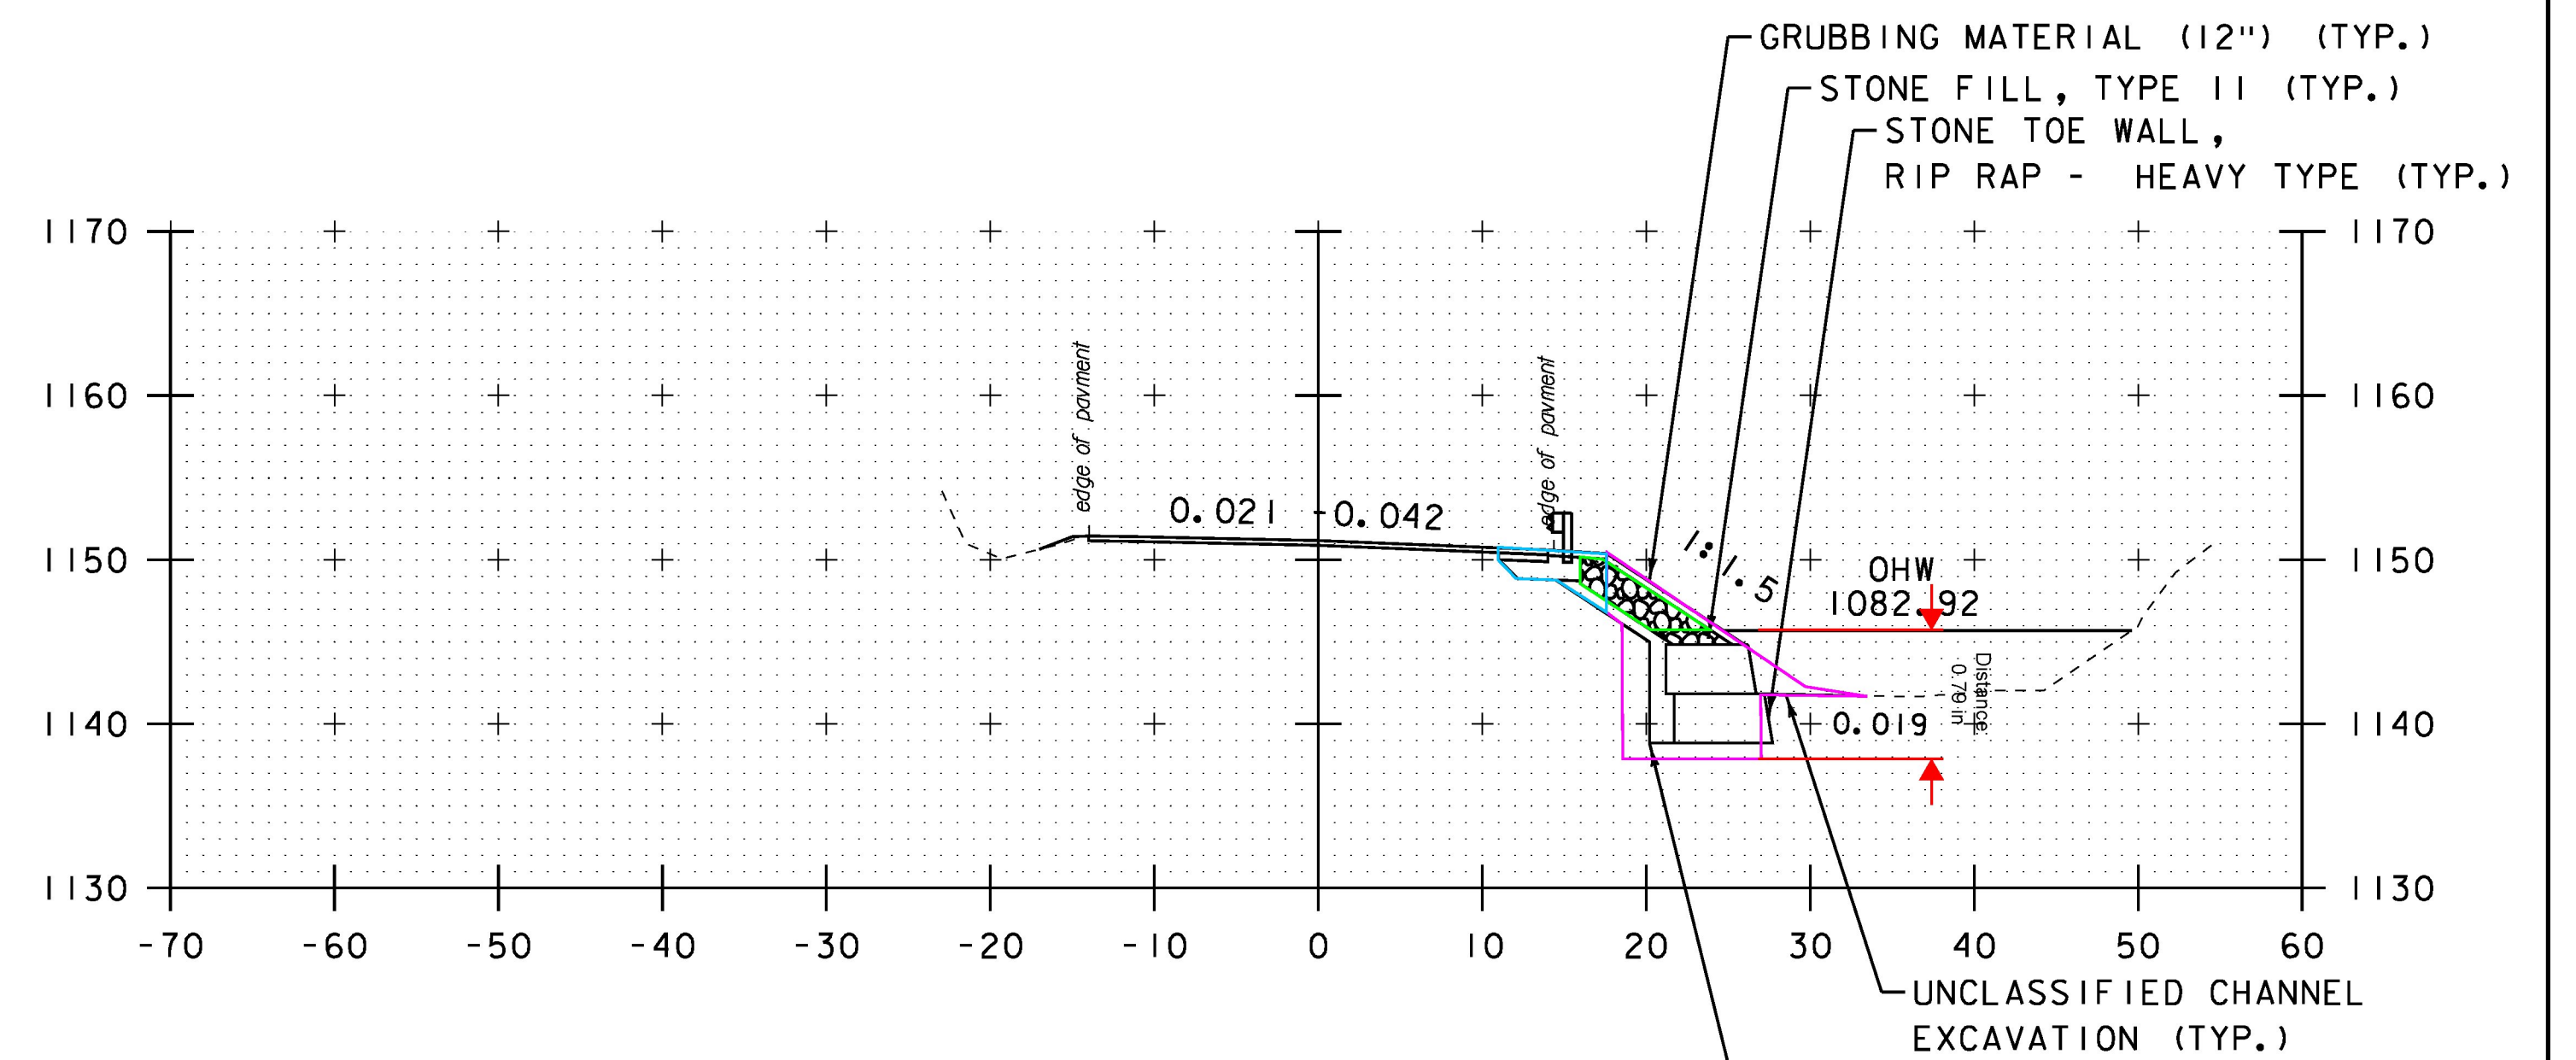


32+50

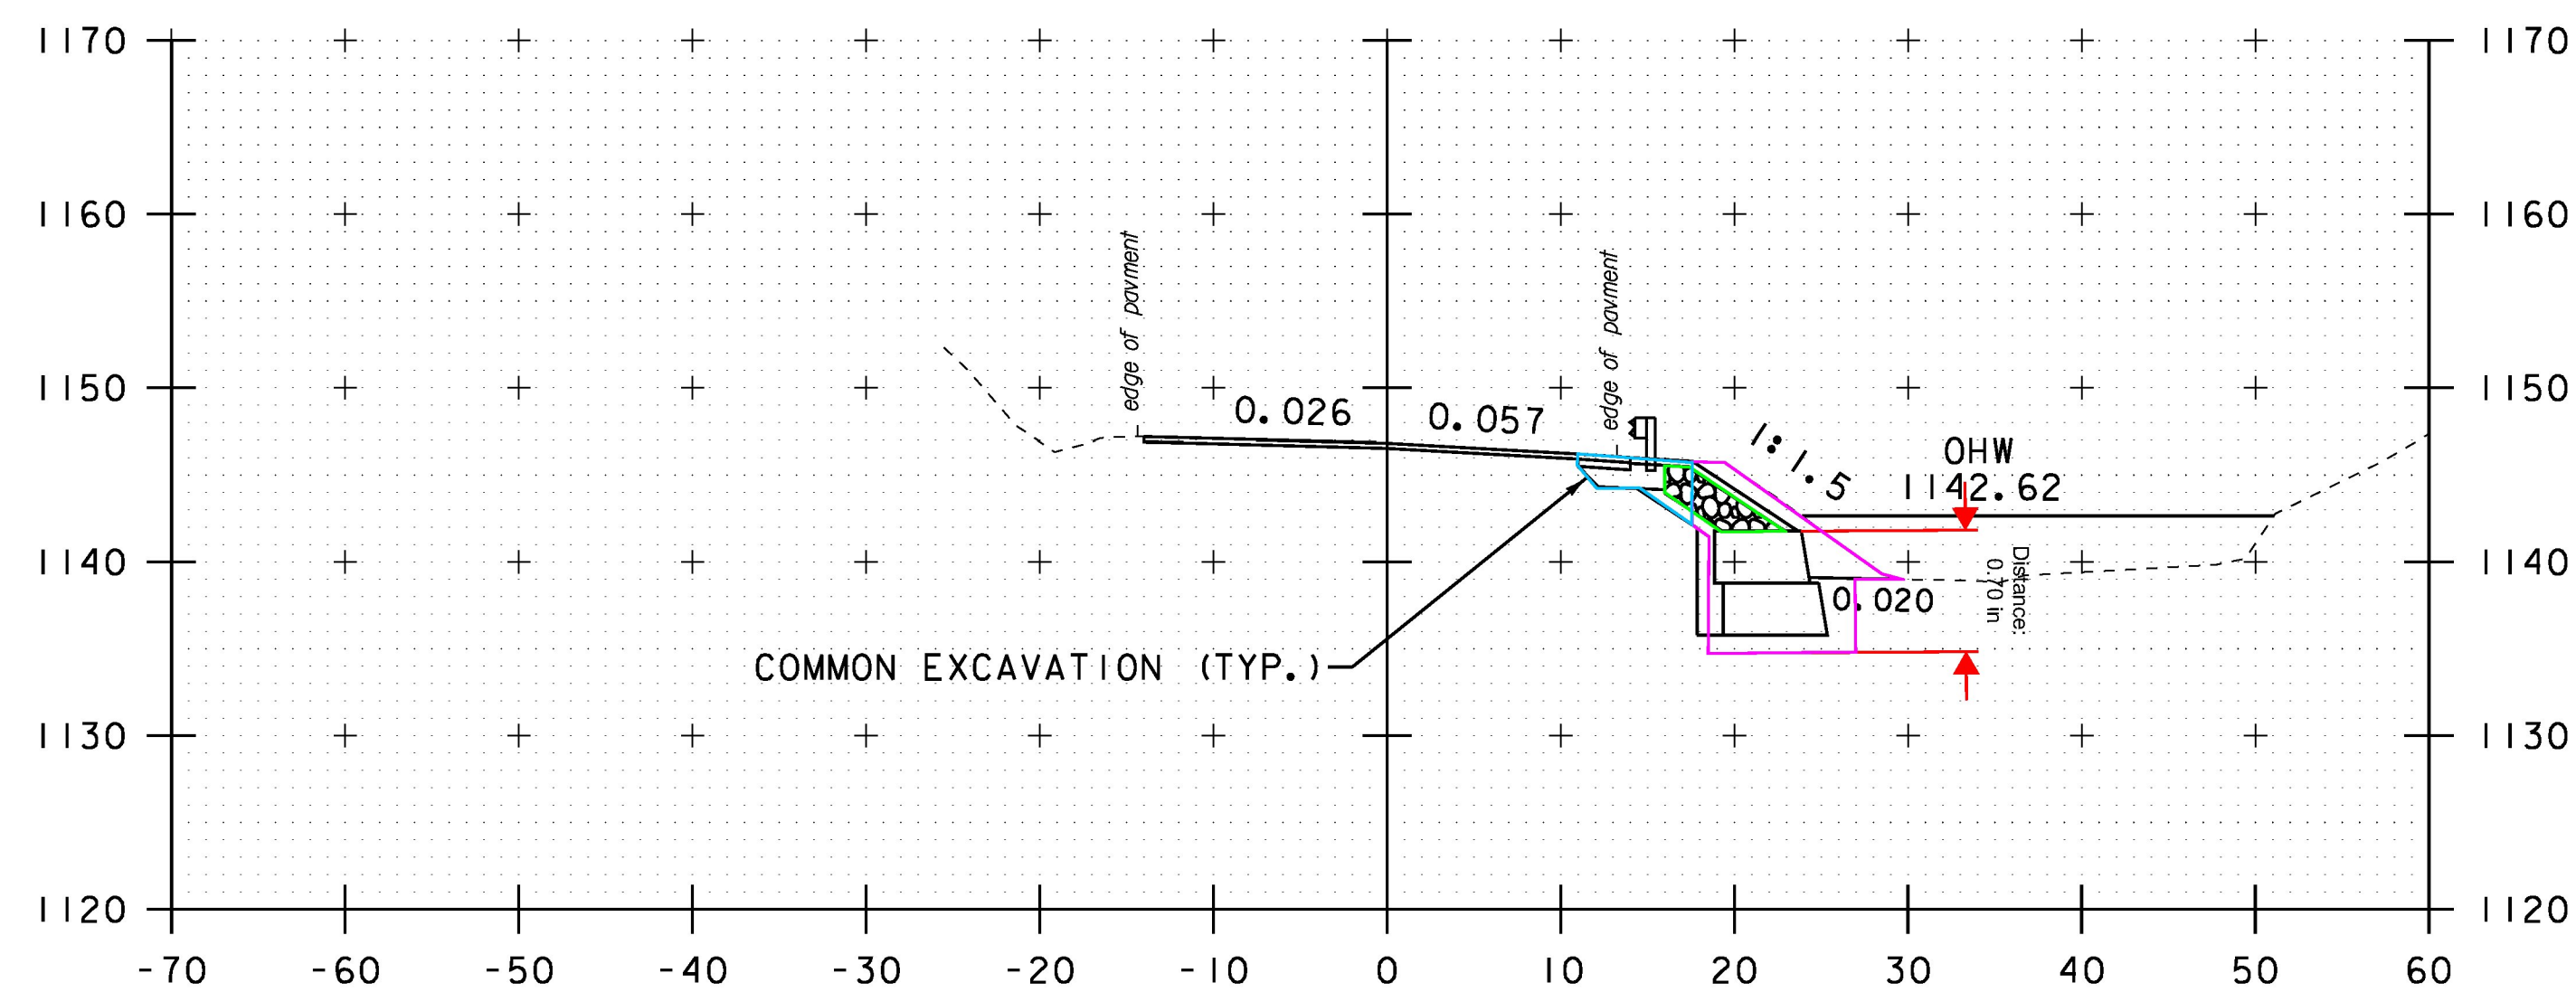

31+00

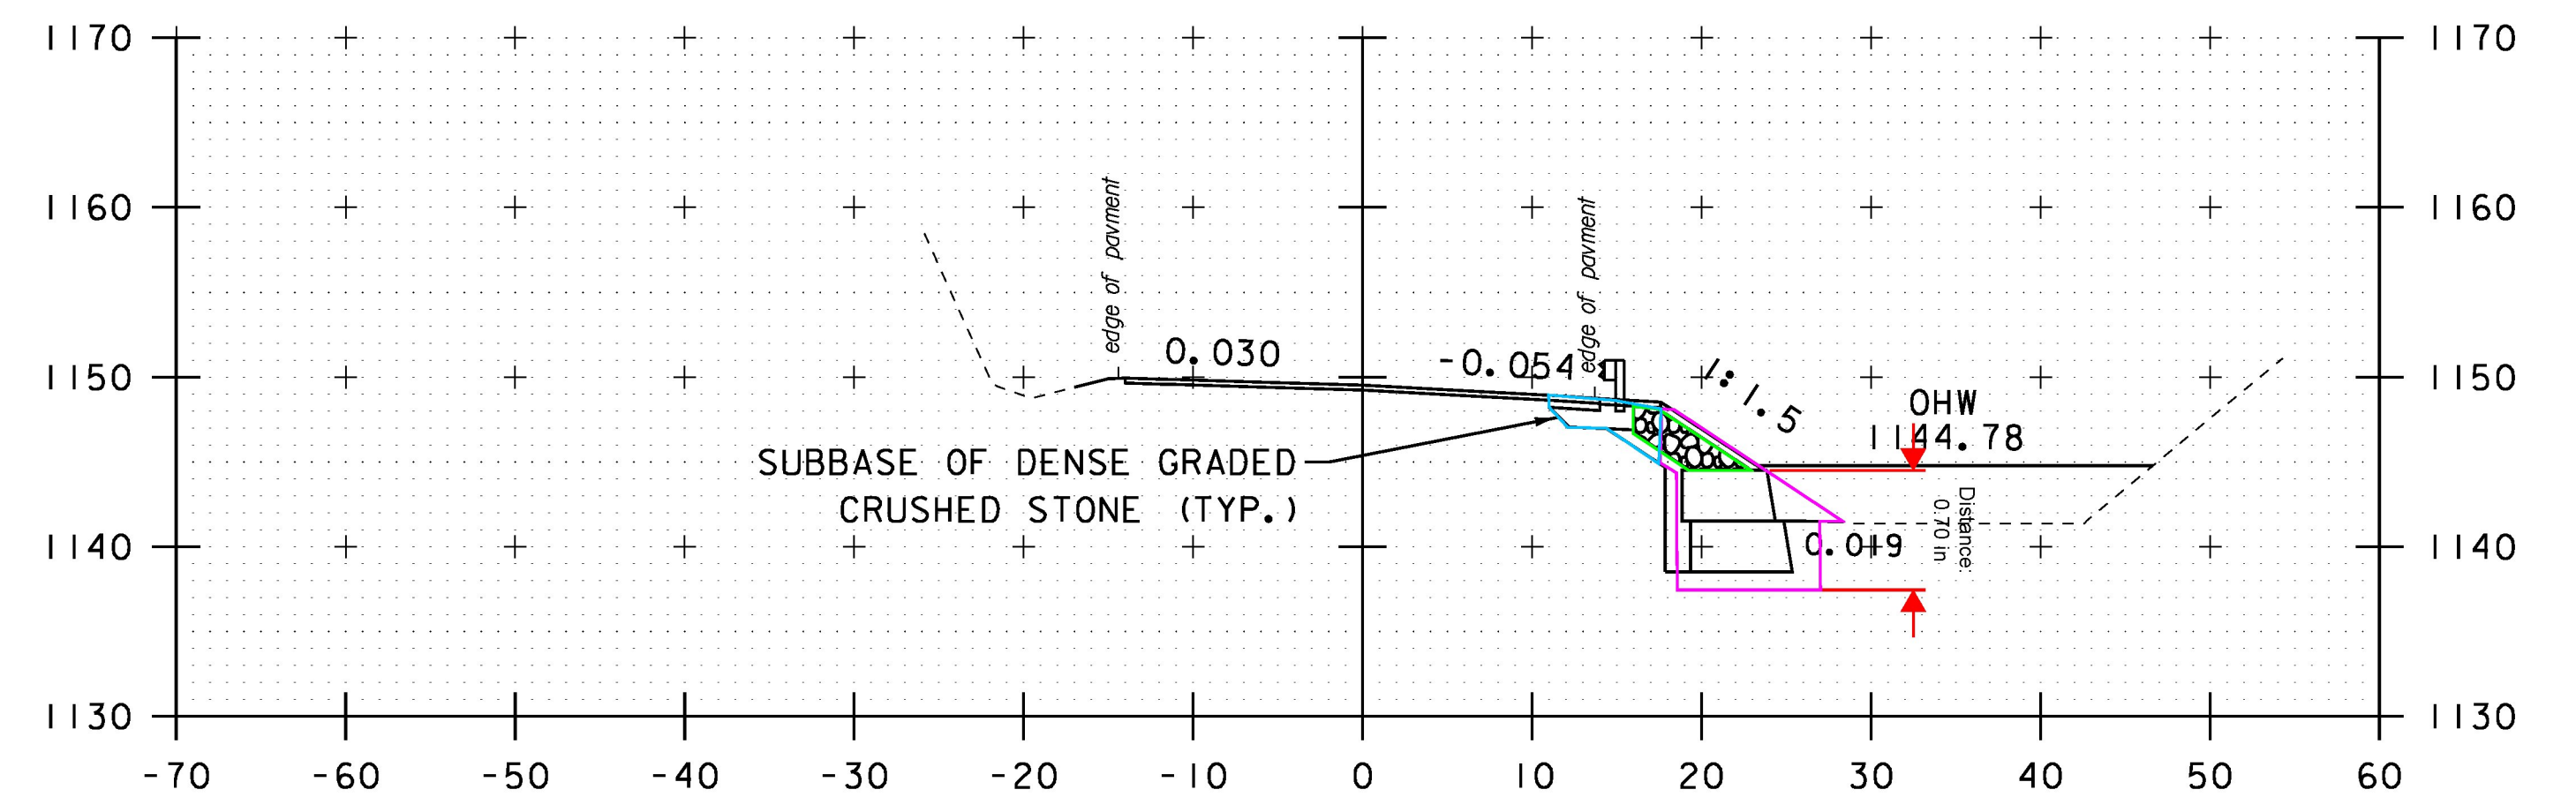

32+00

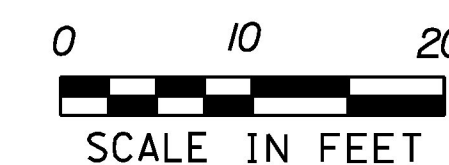

STA. 31+00 TO STA. 32+50

PROJECT NAME: GRANVILLE
PROJECT NUMBER: ER STP 013-4 (40)

FILE NAME: z12b520xs.dgn
PROJECT LEADER: J. TUCKER
DESIGNED BY: B. BRESLEND
VT 100 CROSS SECTION SHEET 15

PLOT DATE: 7/8/2015
DRAWN BY: B. BRESLEND
CHECKED BY: A. SANZ
SHEET 102 OF 141