



35+50

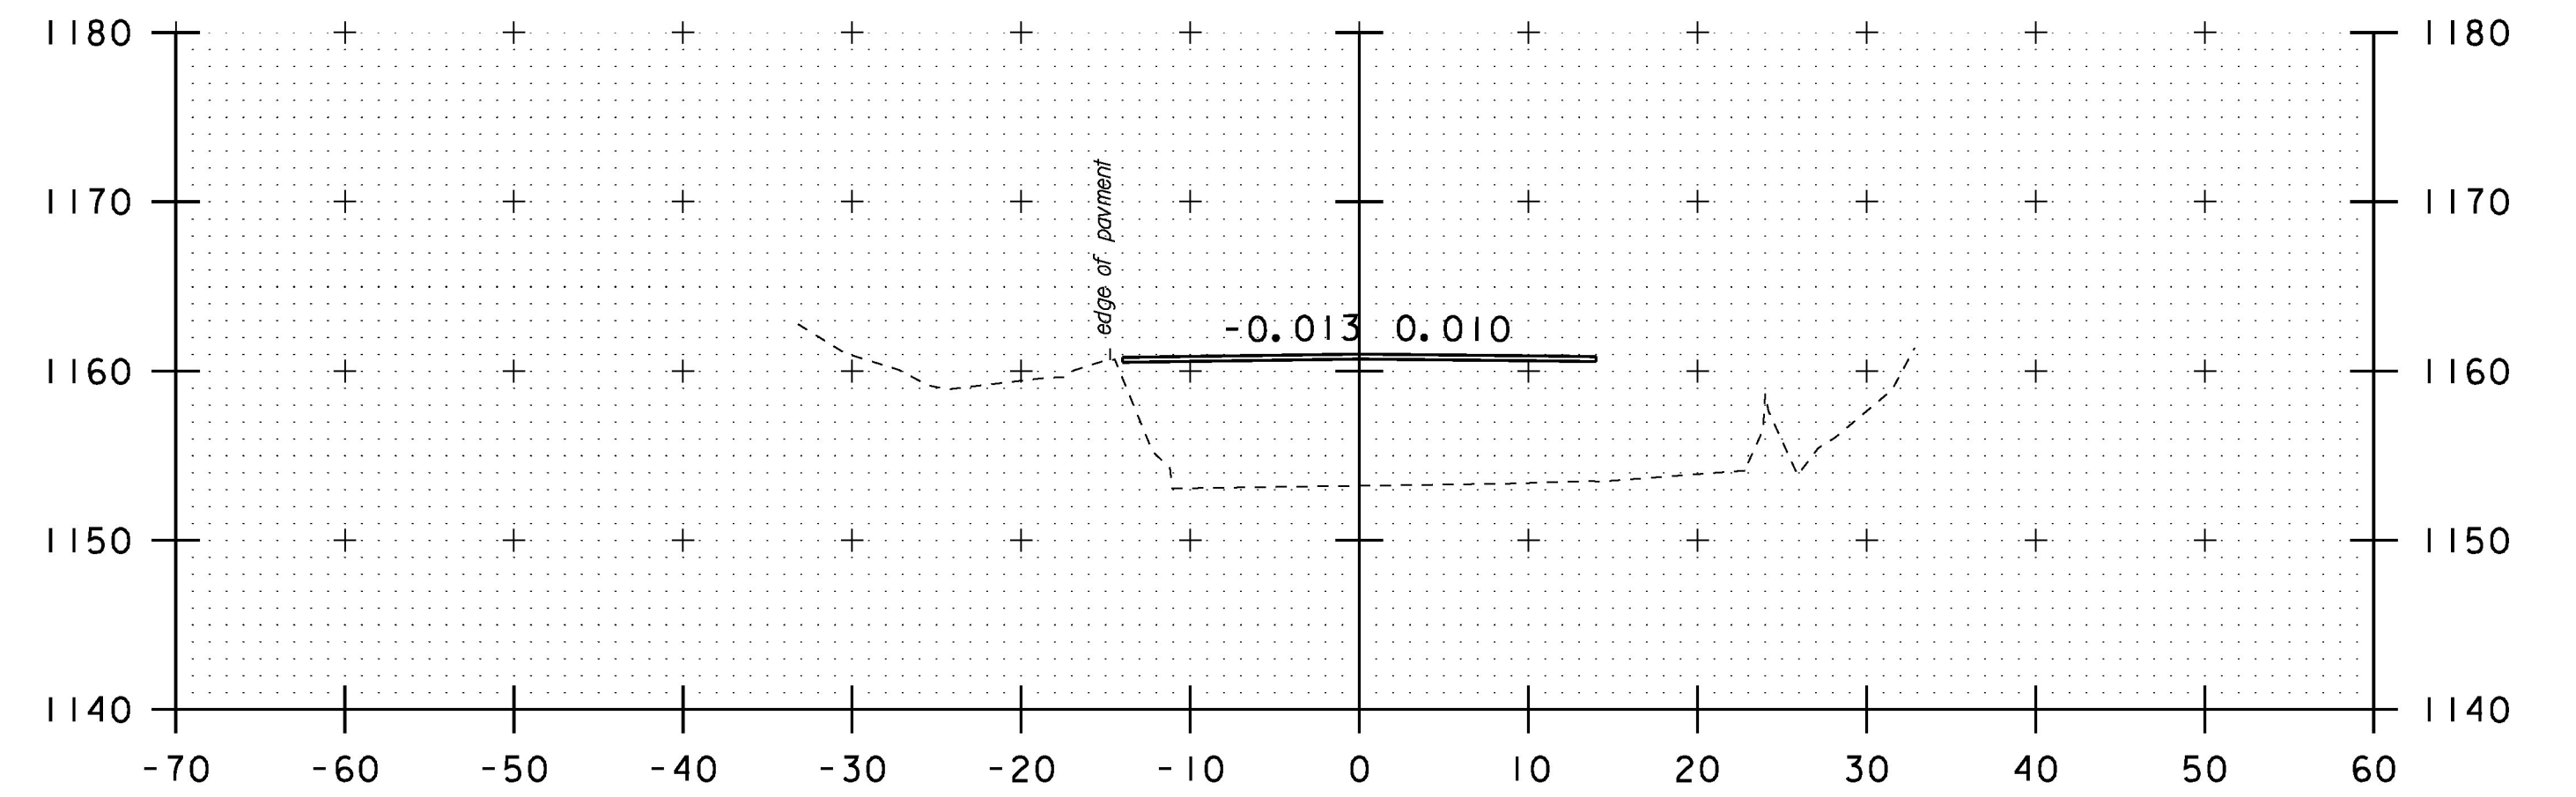


BRIDGE SECTION  
36+50


STA. 36+15.00 RT  
STOP STONE TOE WALL

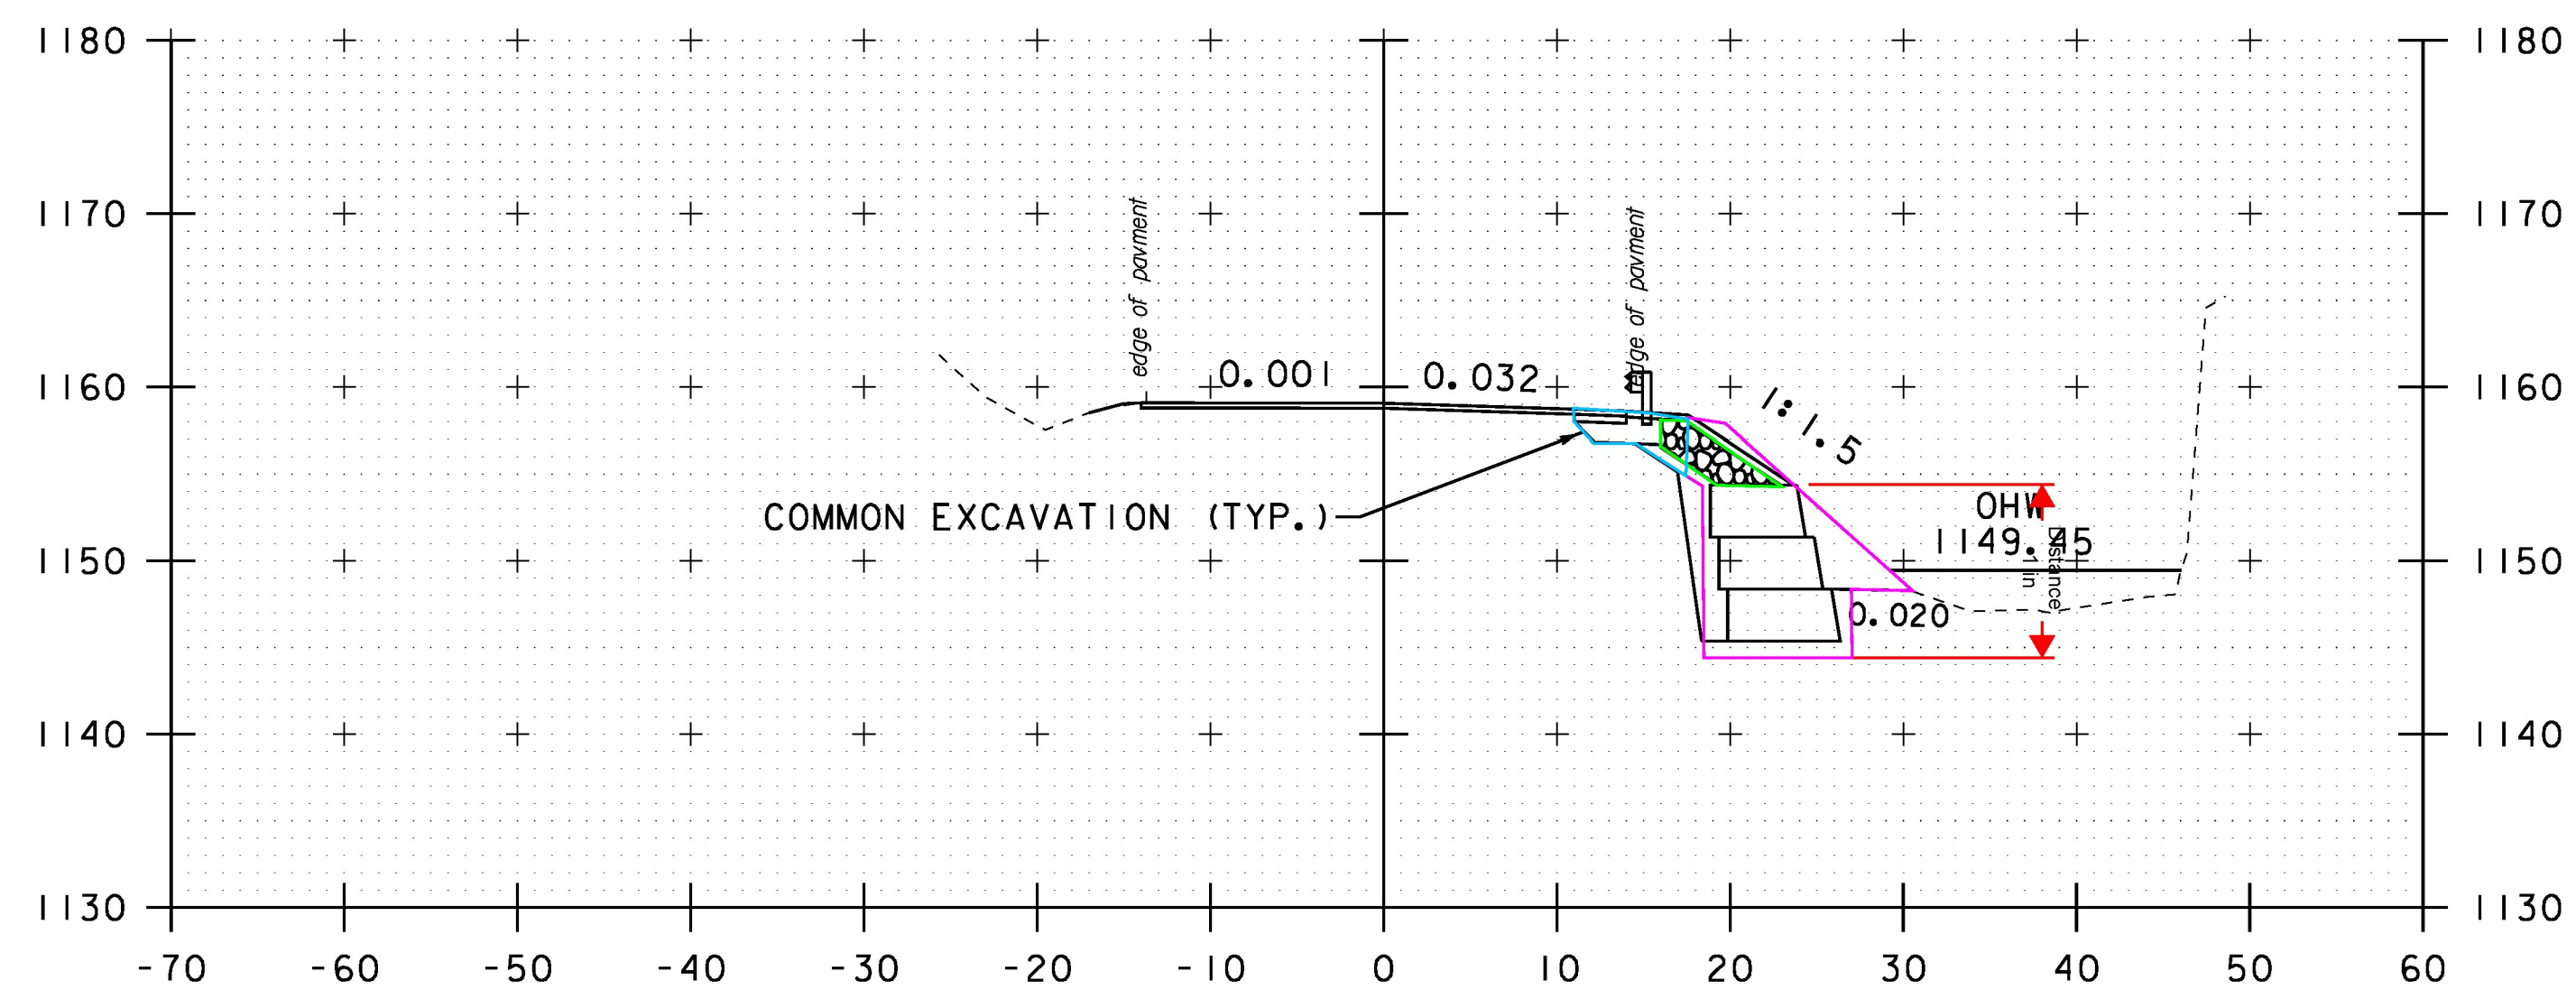

35+00

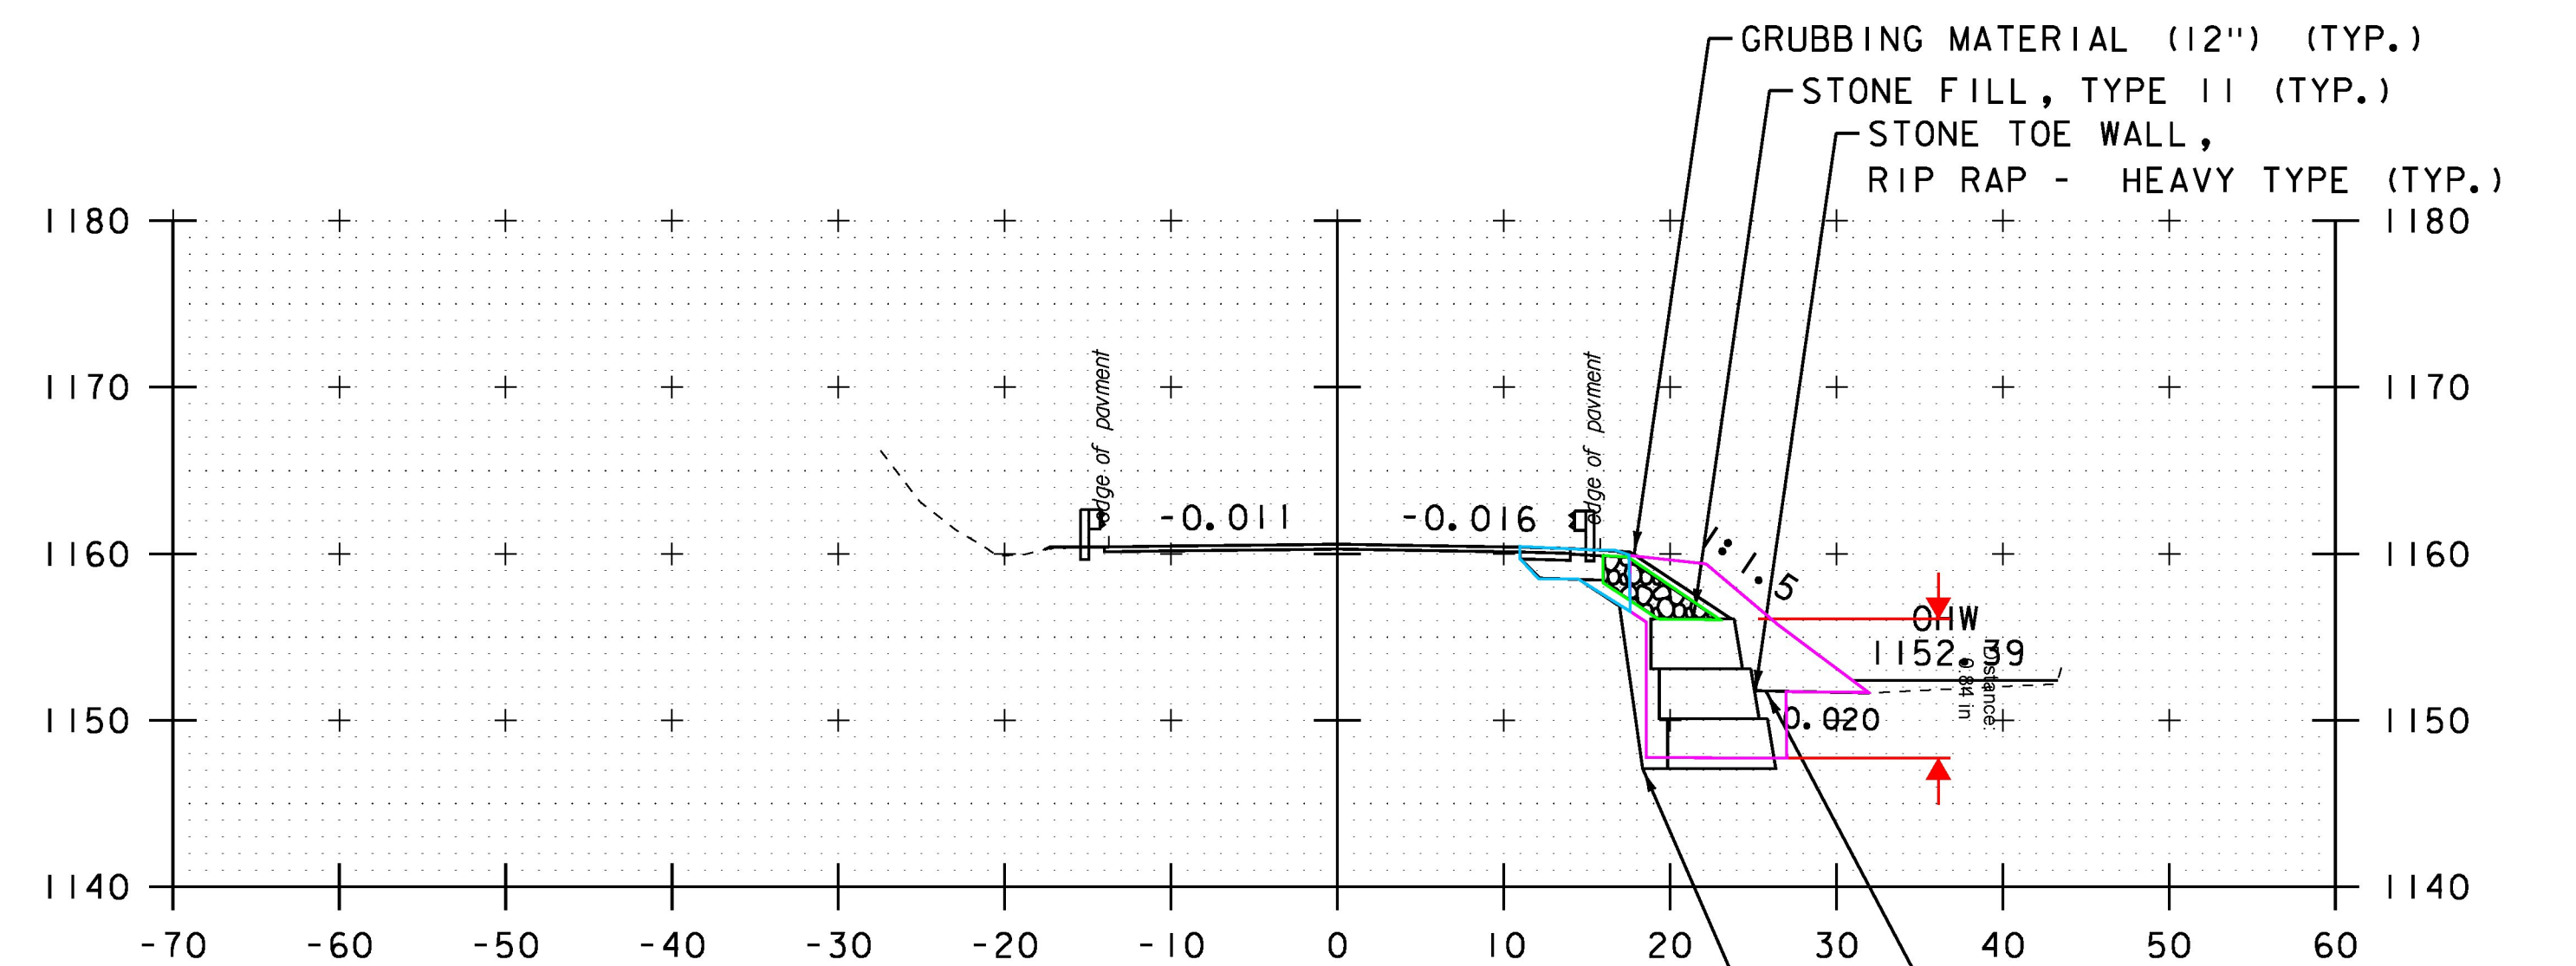

36+00

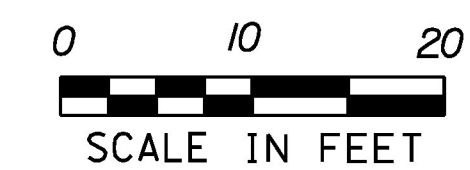

STA. 35+00 TO STA. 36+50

PROJECT NAME: GRANVILLE  
PROJECT NUMBER: ER STP 013-4 (40)

FILE NAME: z12b520xs.dgn	PLOT DATE: 7/8/2015
PROJECT LEADER: J. TUCKER	DRAWN BY: B. BRESLEND
DESIGNED BY: B. BRESLEND	CHECKED BY: A. SANZ
VT 100 CROSS SECTION SHEET 17	SHEET 104 OF 141