



43+50

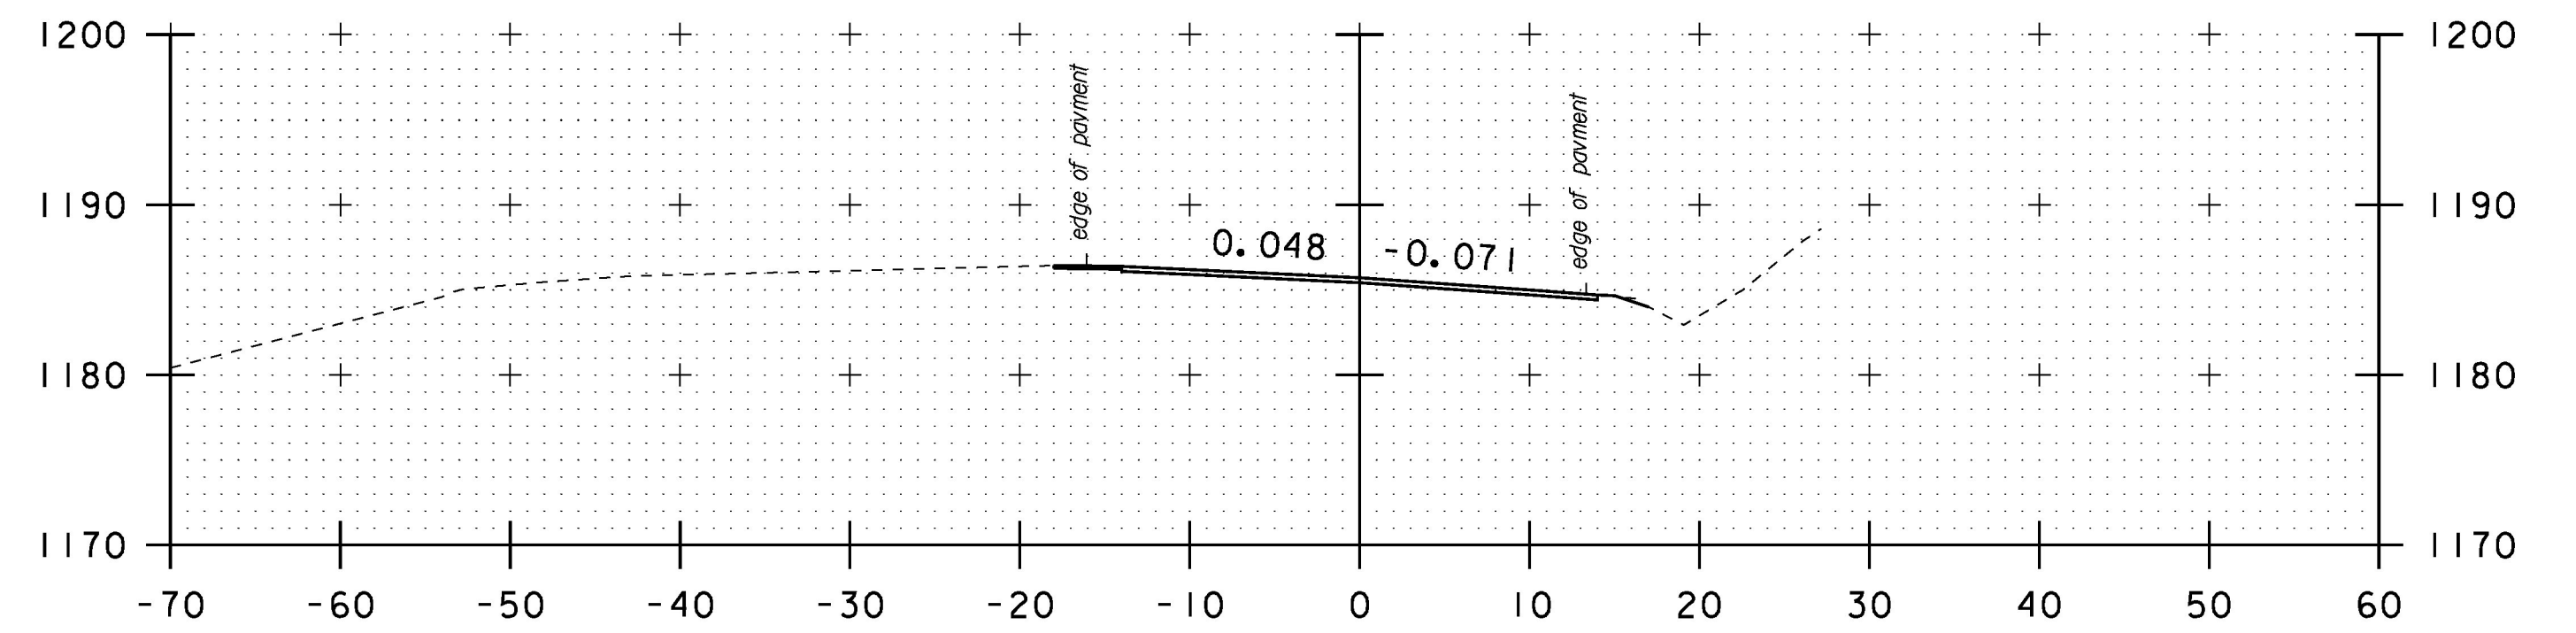


44+50

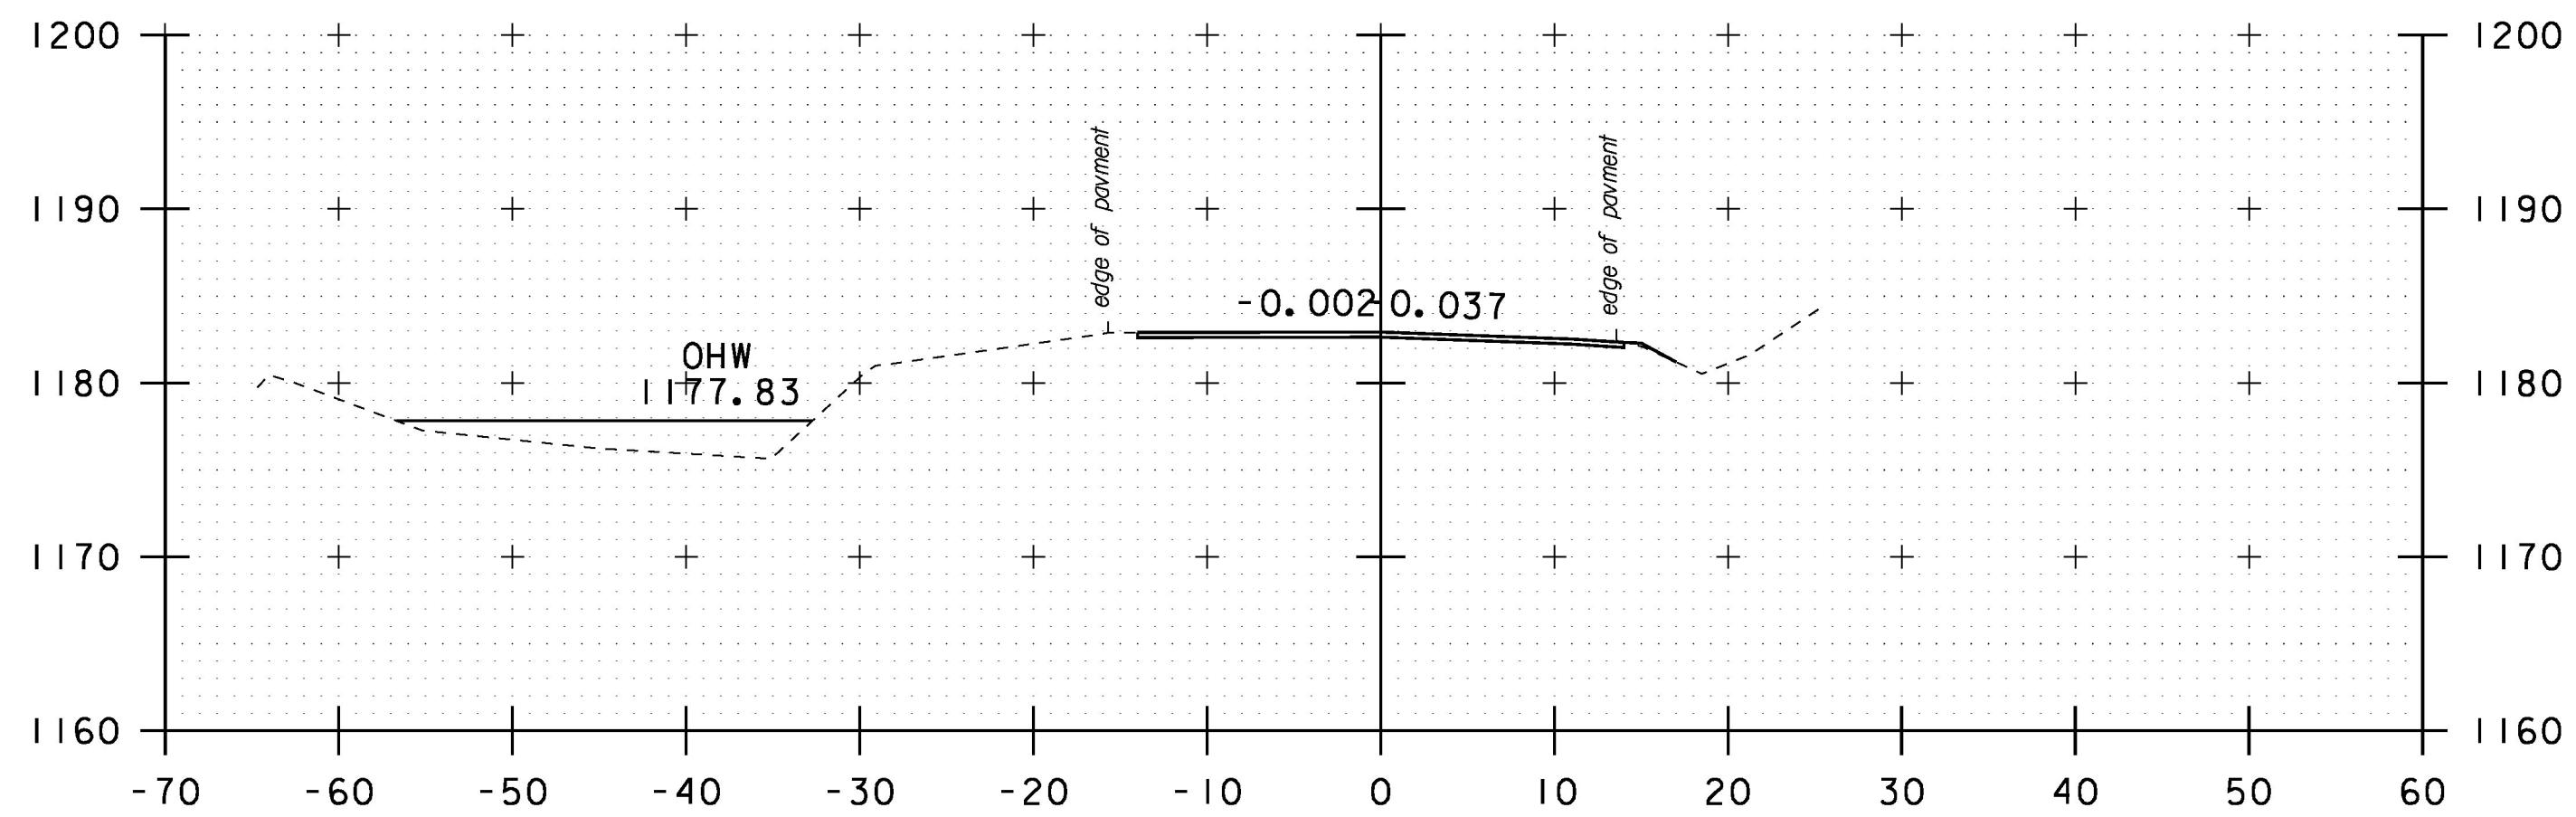


STA. 42+75.00 LT
END STONE TOE WALL

43+00

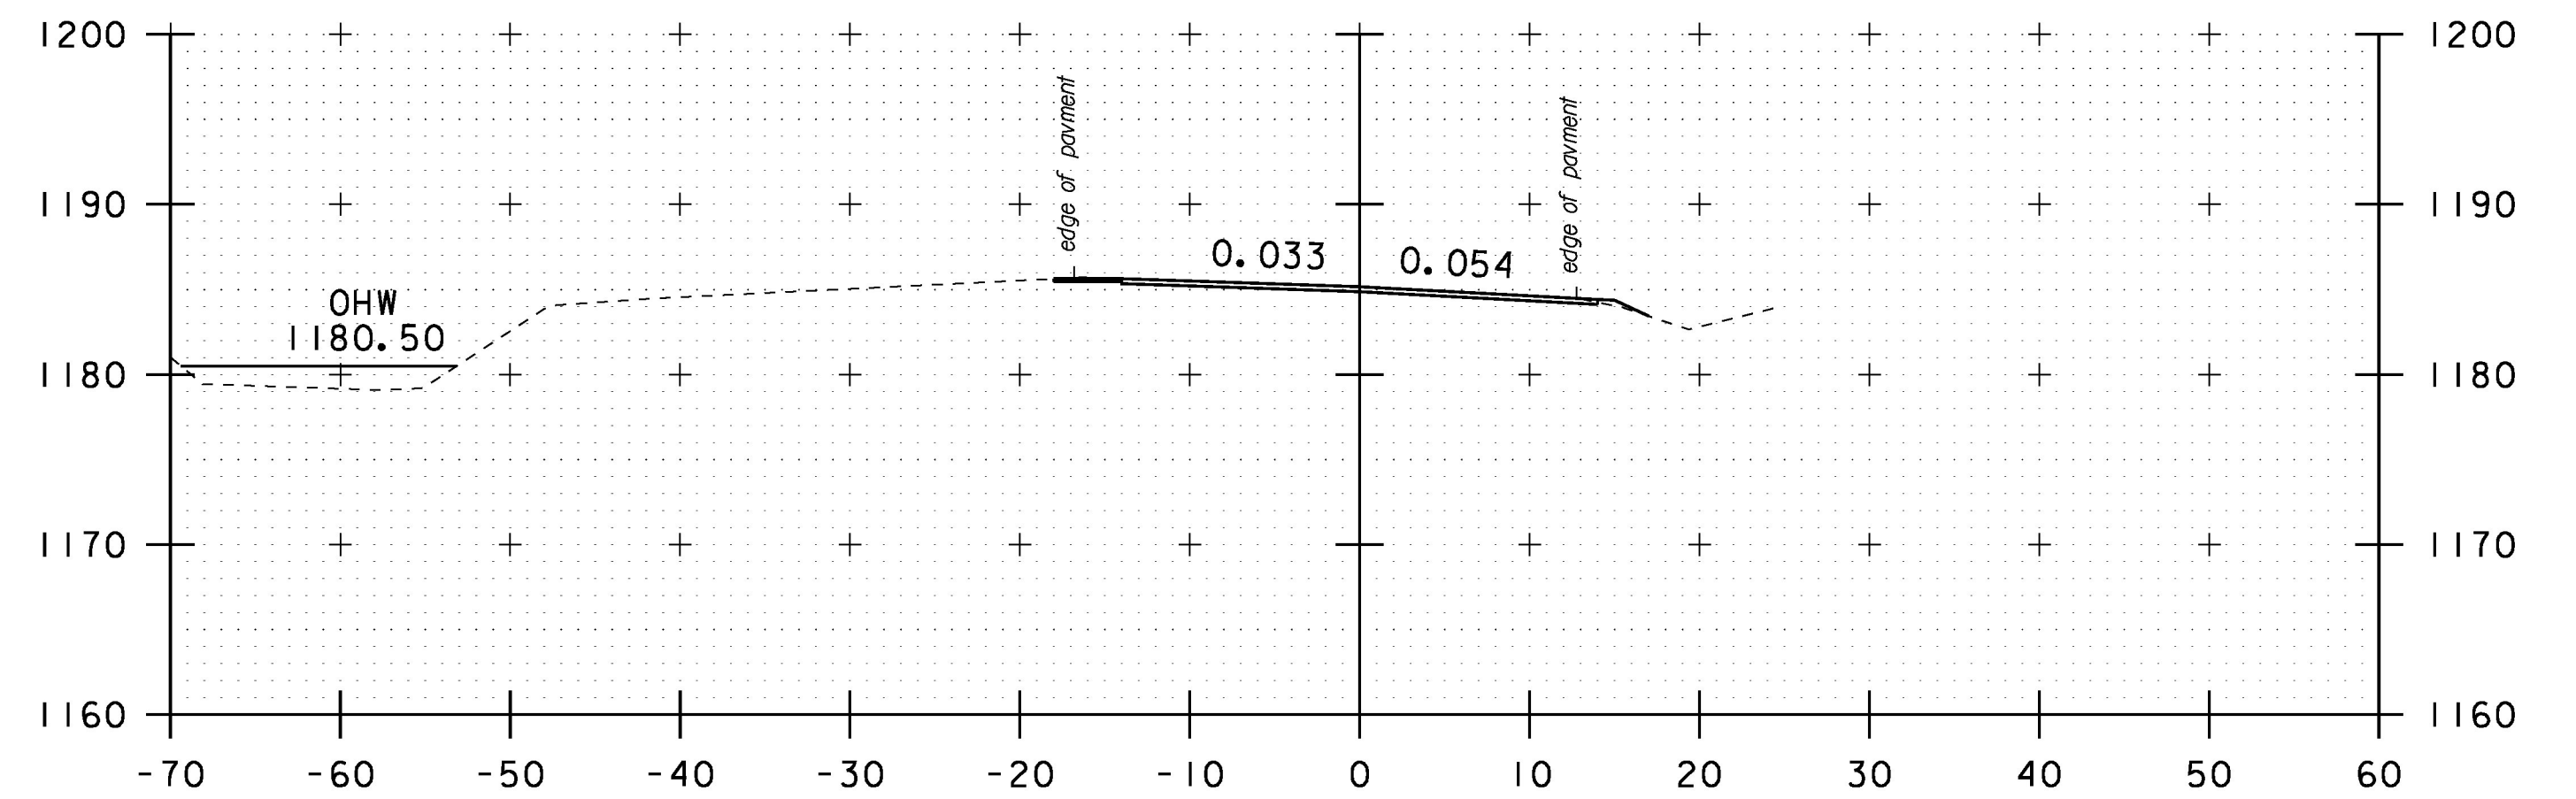

44+00

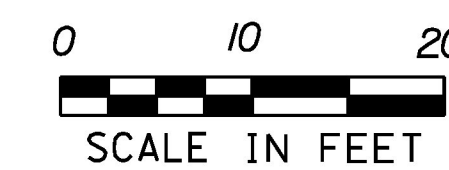

STA. 43+00 TO STA. 44+50

PROJECT NAME: GRANVILLE
PROJECT NUMBER: ER STP 013-4 (40)

FILE NAME: z12b520xs.dgn	PLOT DATE: 7/8/2015
PROJECT LEADER: J. TUCKER	DRAWN BY: B. BRESLEND
DESIGNED BY: B. BRESLEND	CHECKED BY: A. SANZ
VT 100 CROSS SECTION SHEET 21	SHEET 108 OF 141