




45+50

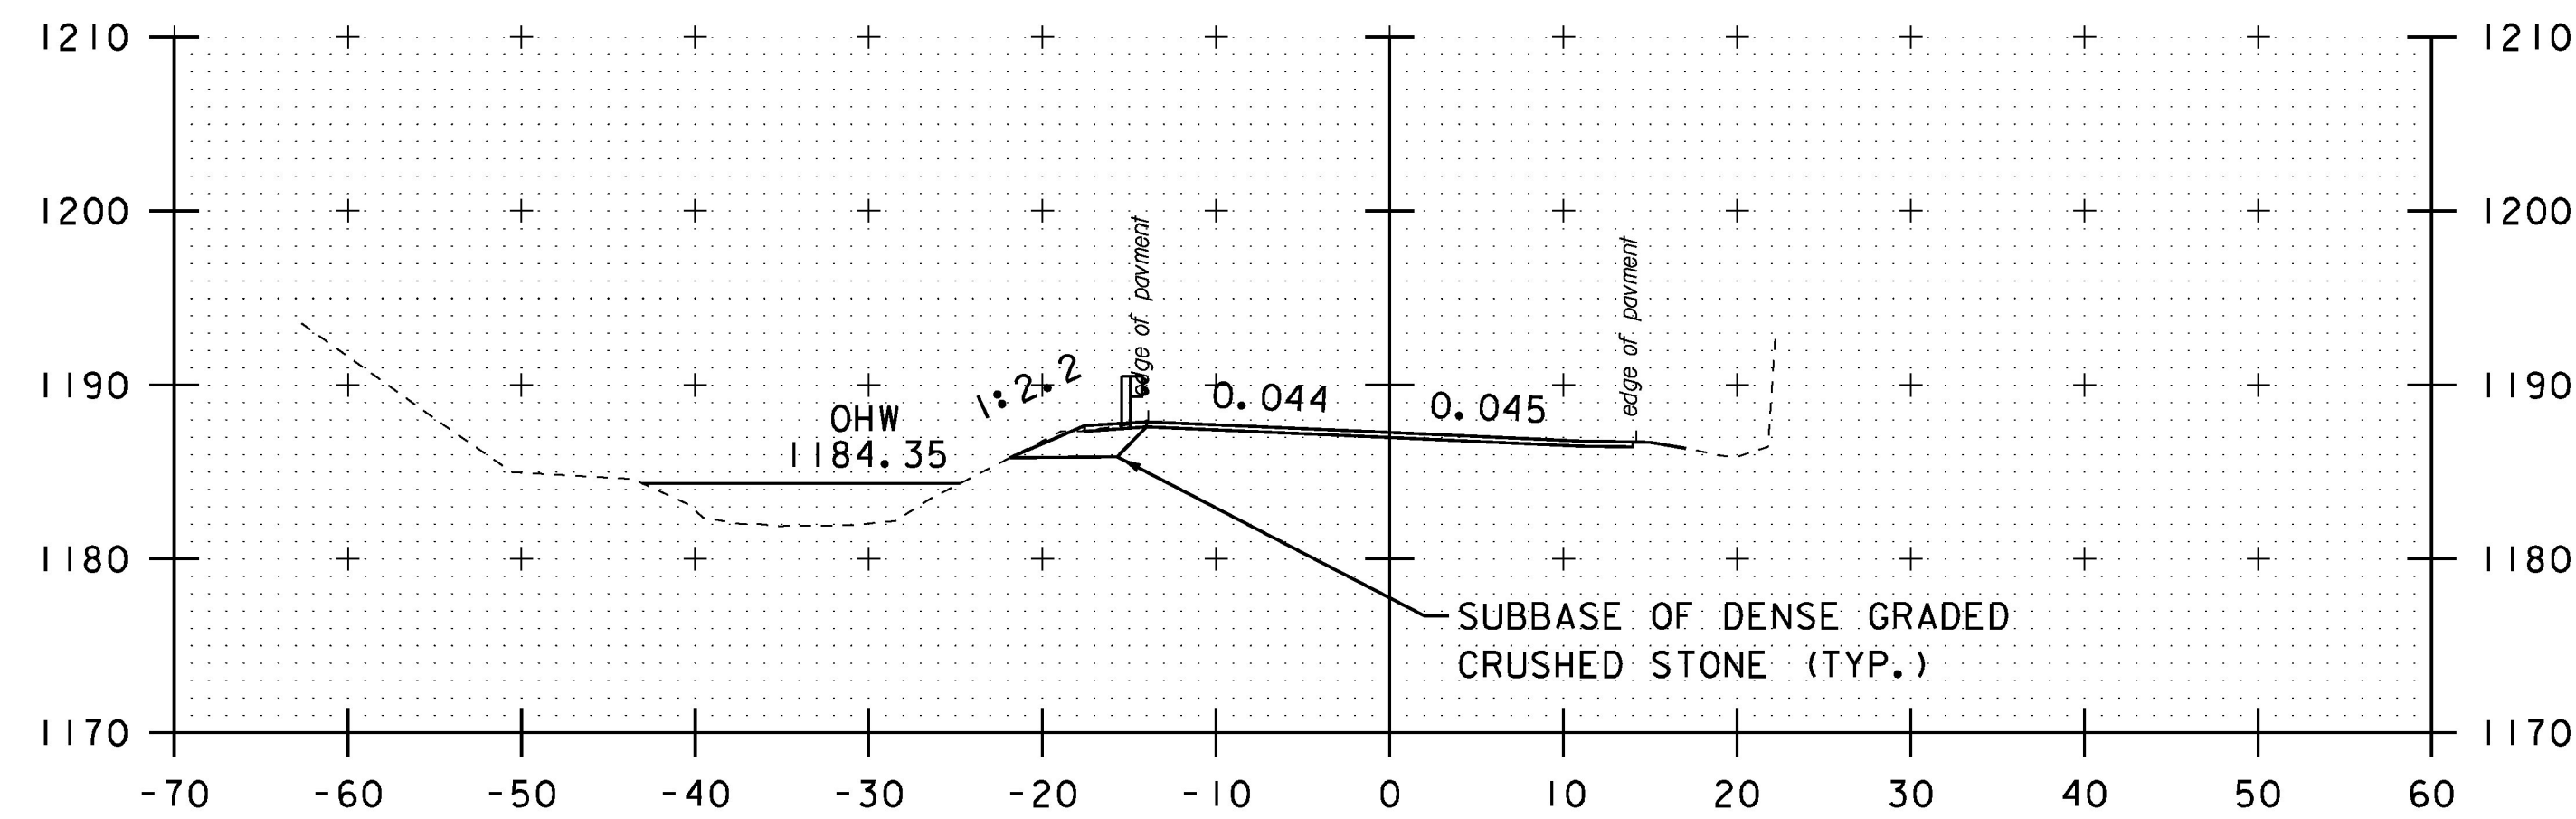


46+50

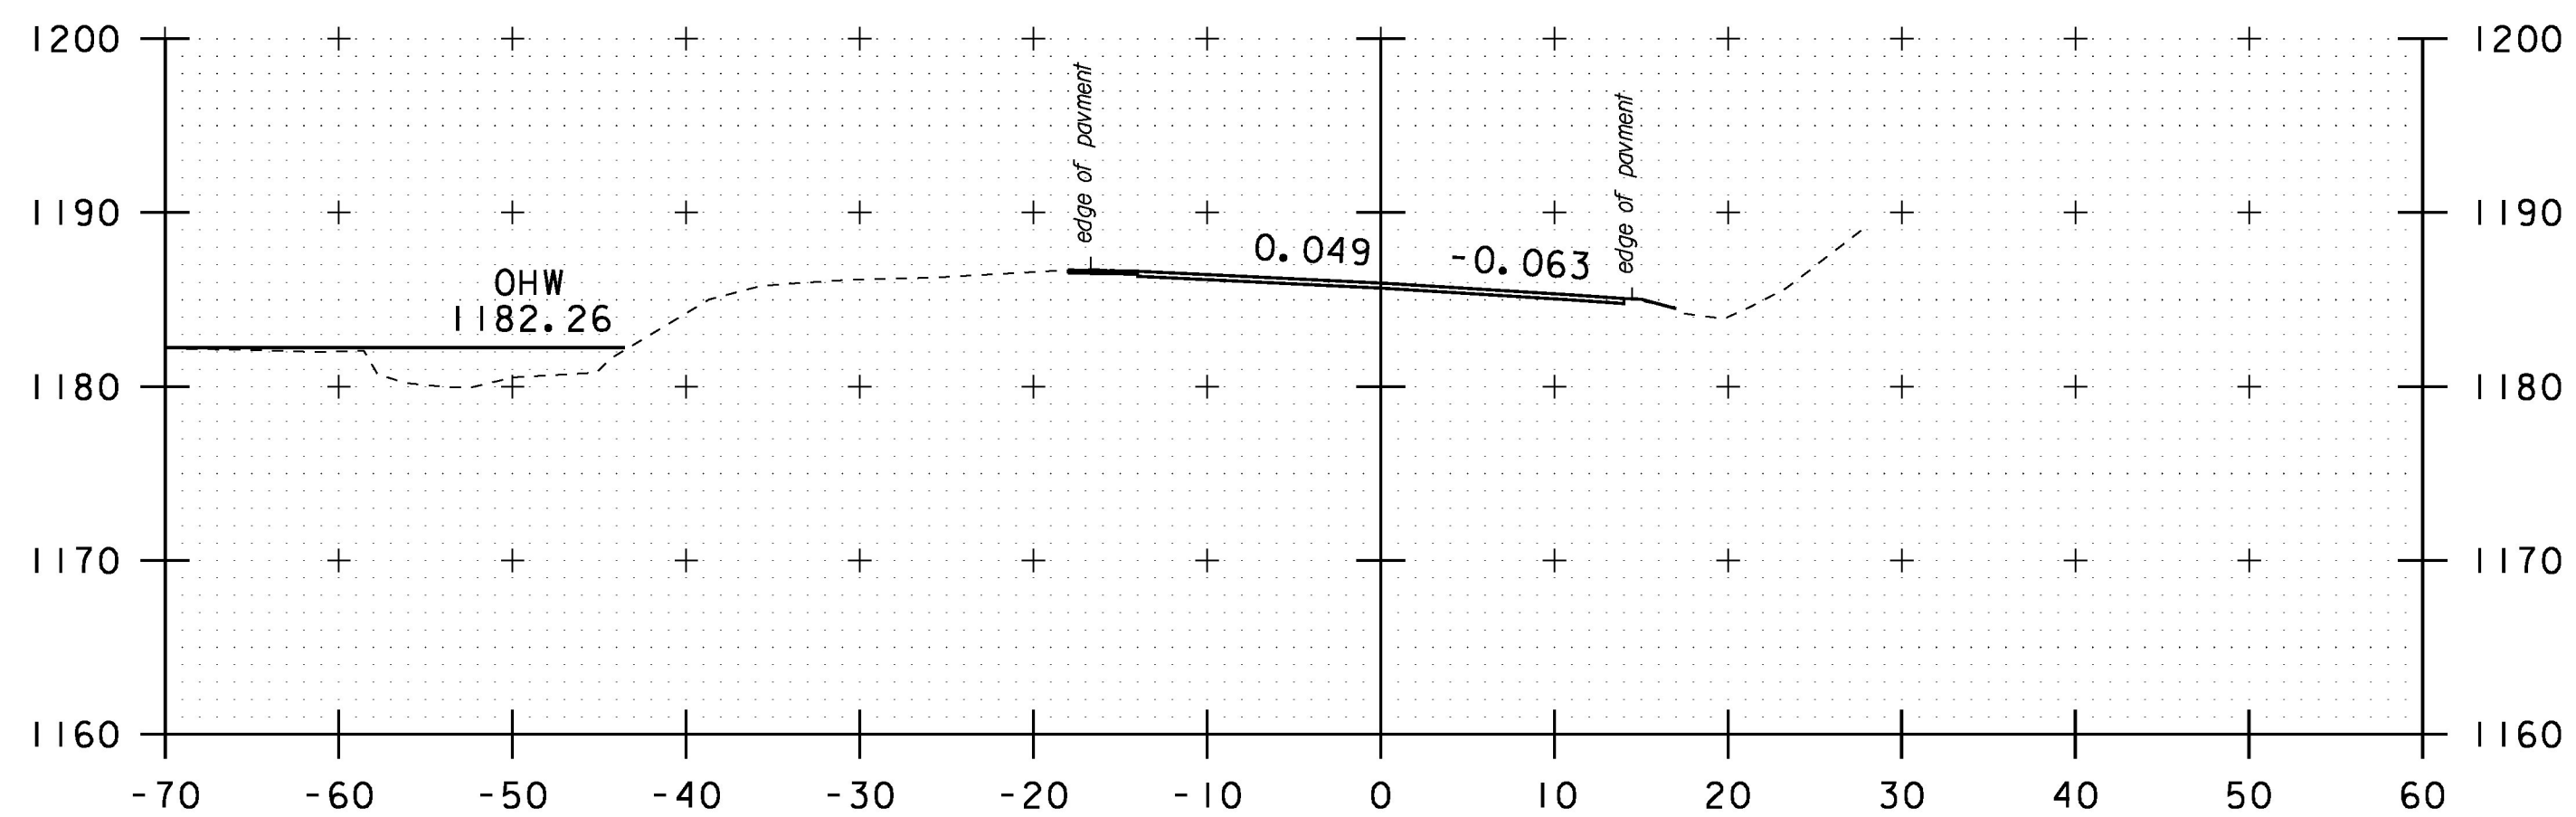

45+00

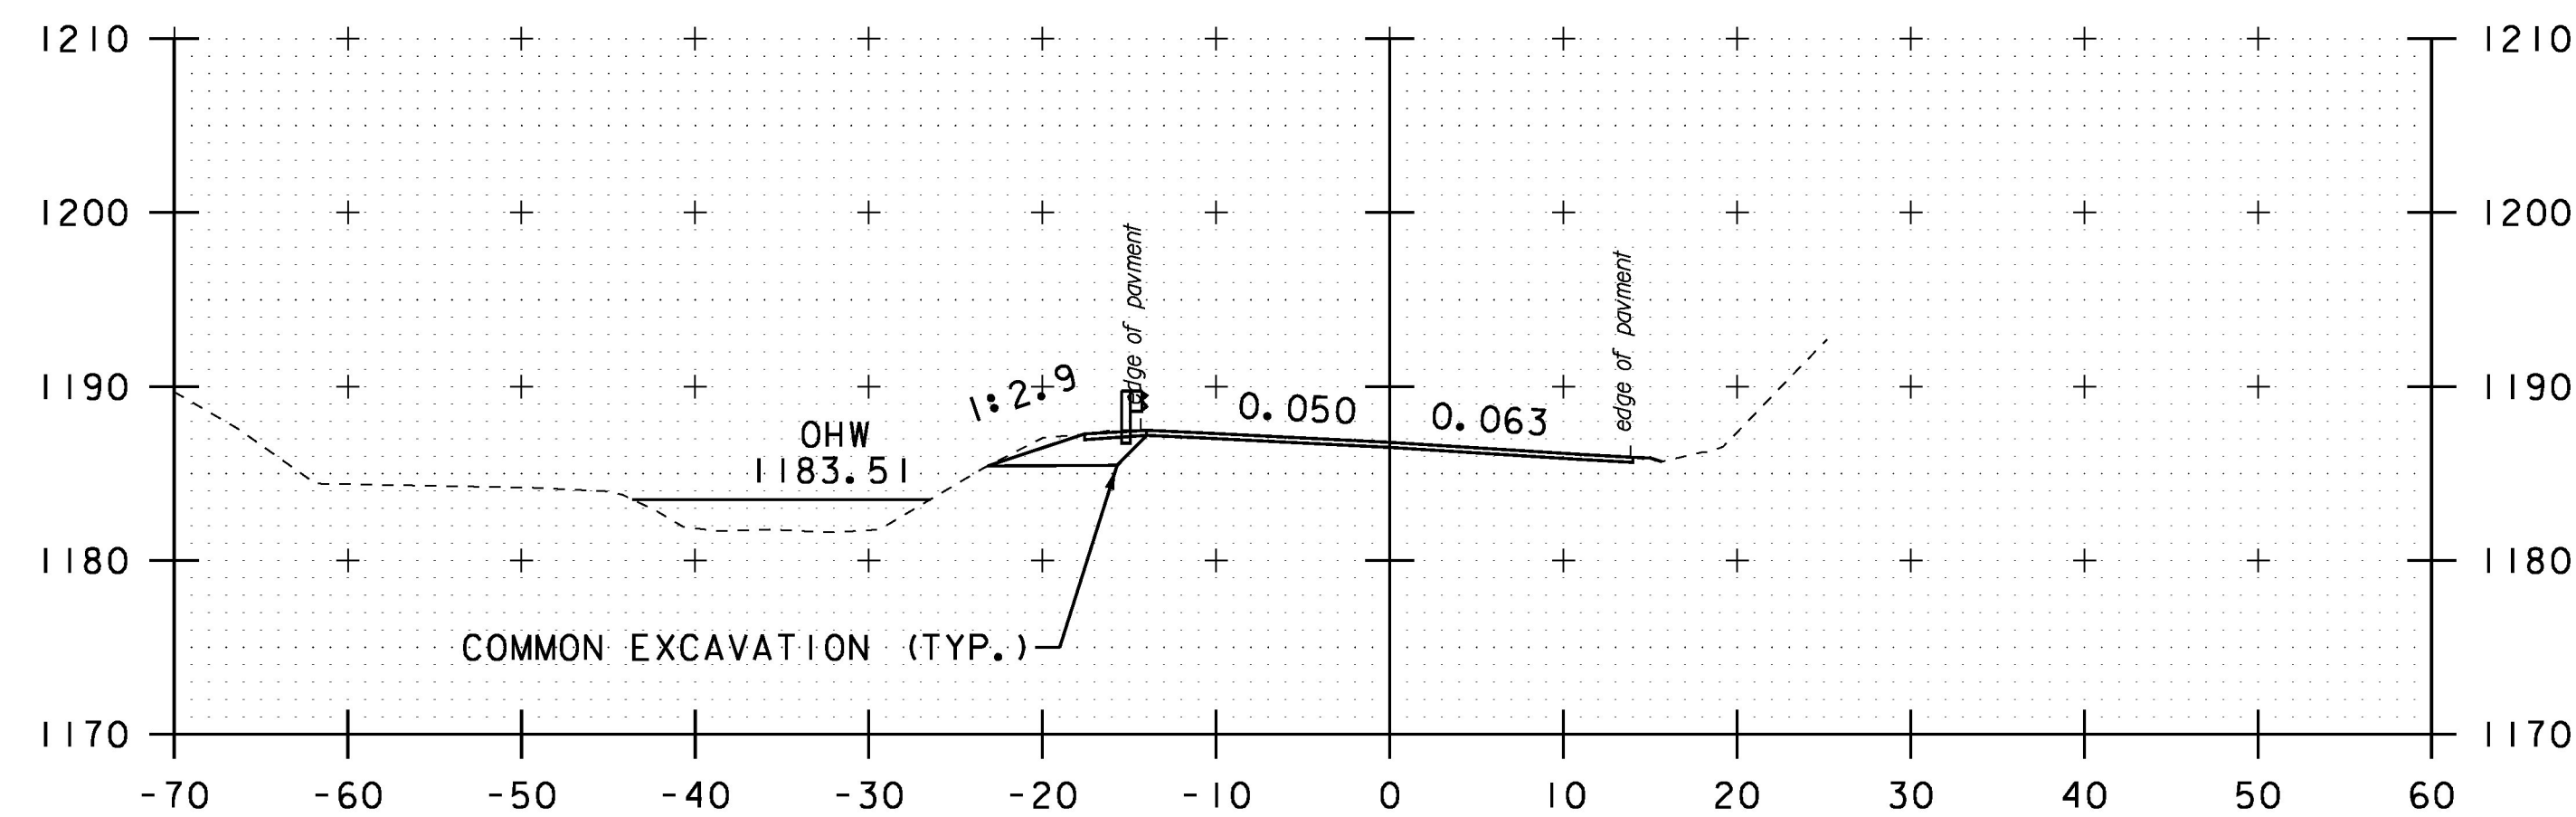

46+00

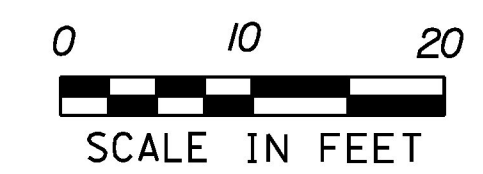

STA. 45+00 TO STA. 46+50

PROJECT NAME: GRANVILLE
PROJECT NUMBER: ER STP 013-4 (40)

FILE NAME: z12b520xs.dgn	PLOT DATE: 7/8/2015
PROJECT LEADER: J. TUCKER	DRAWN BY: B. BRESLEND
DESIGNED BY: B. BRESLEND	CHECKED BY: A. SANZ
VT 100 CROSS SECTION SHEET 22	SHEET 109 OF 141