




49+50

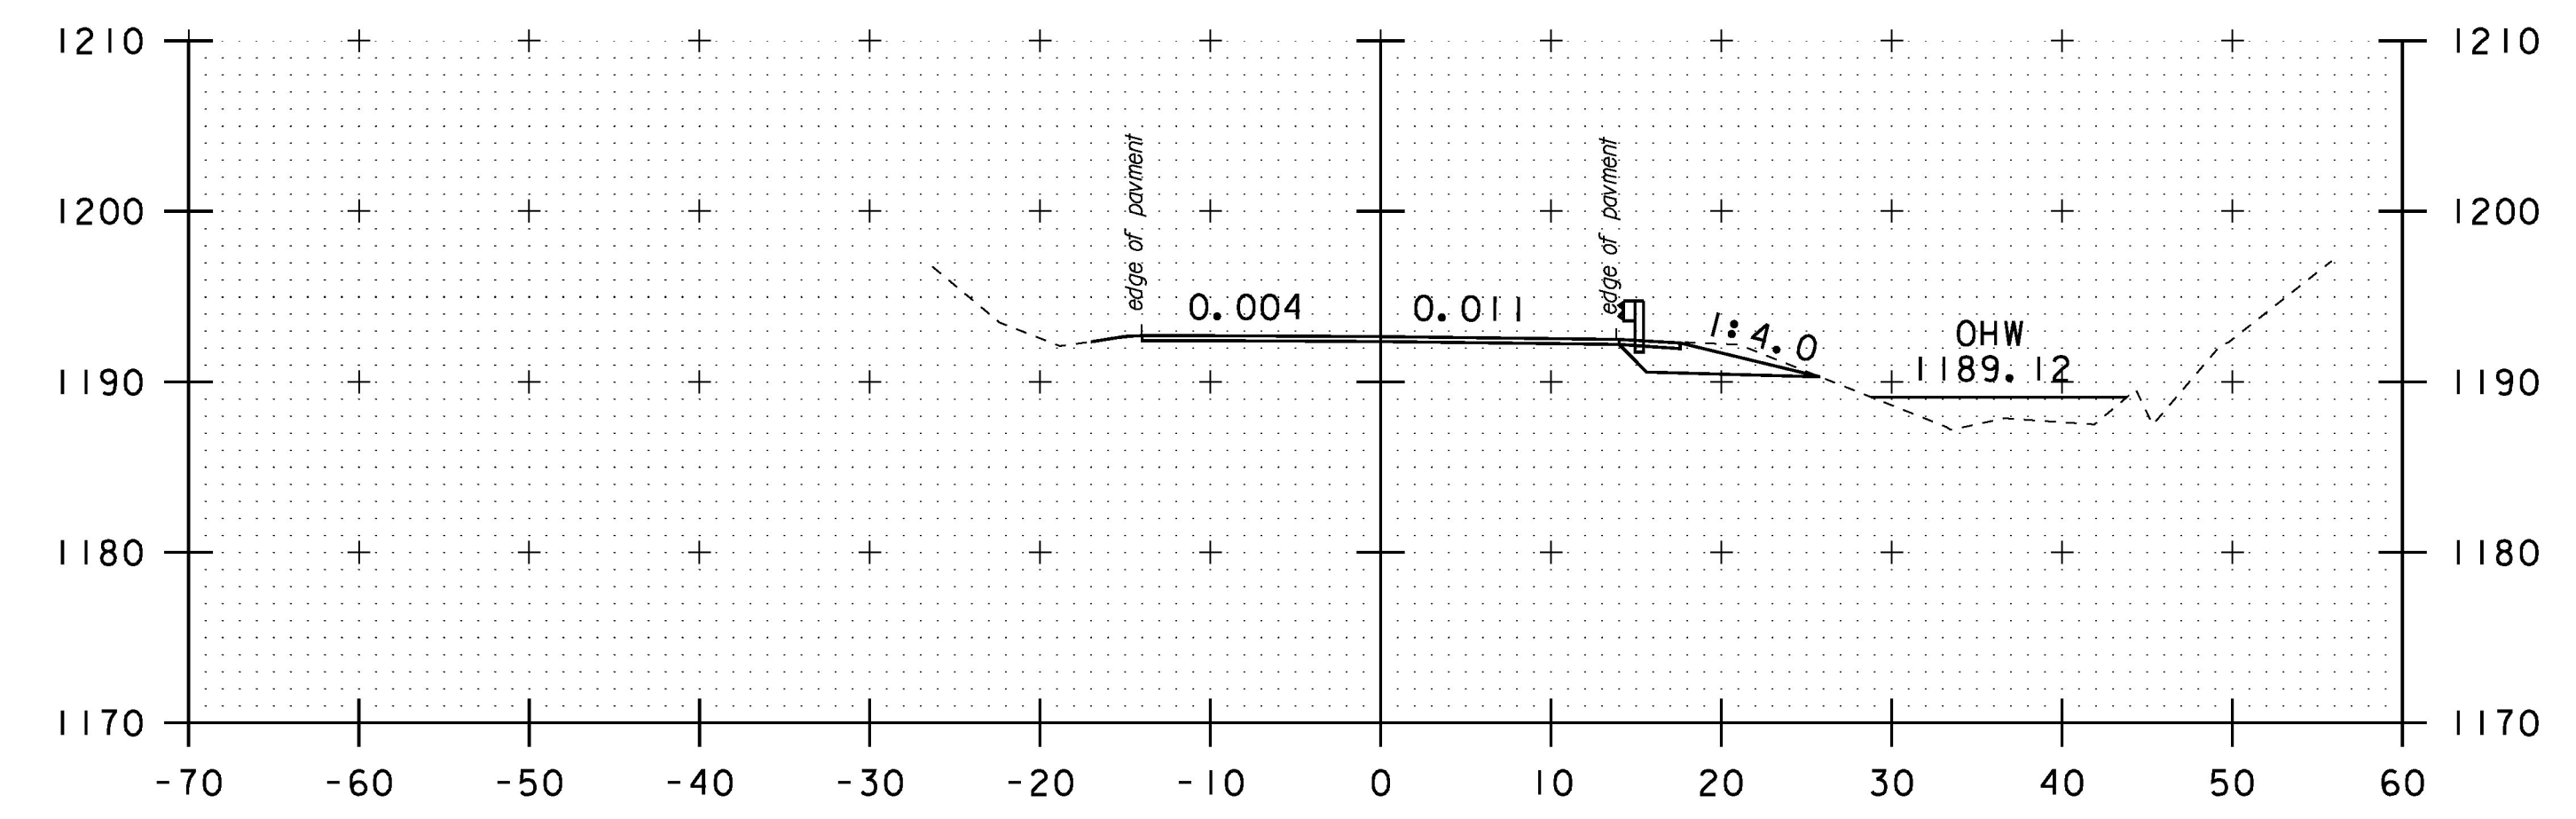


50+50

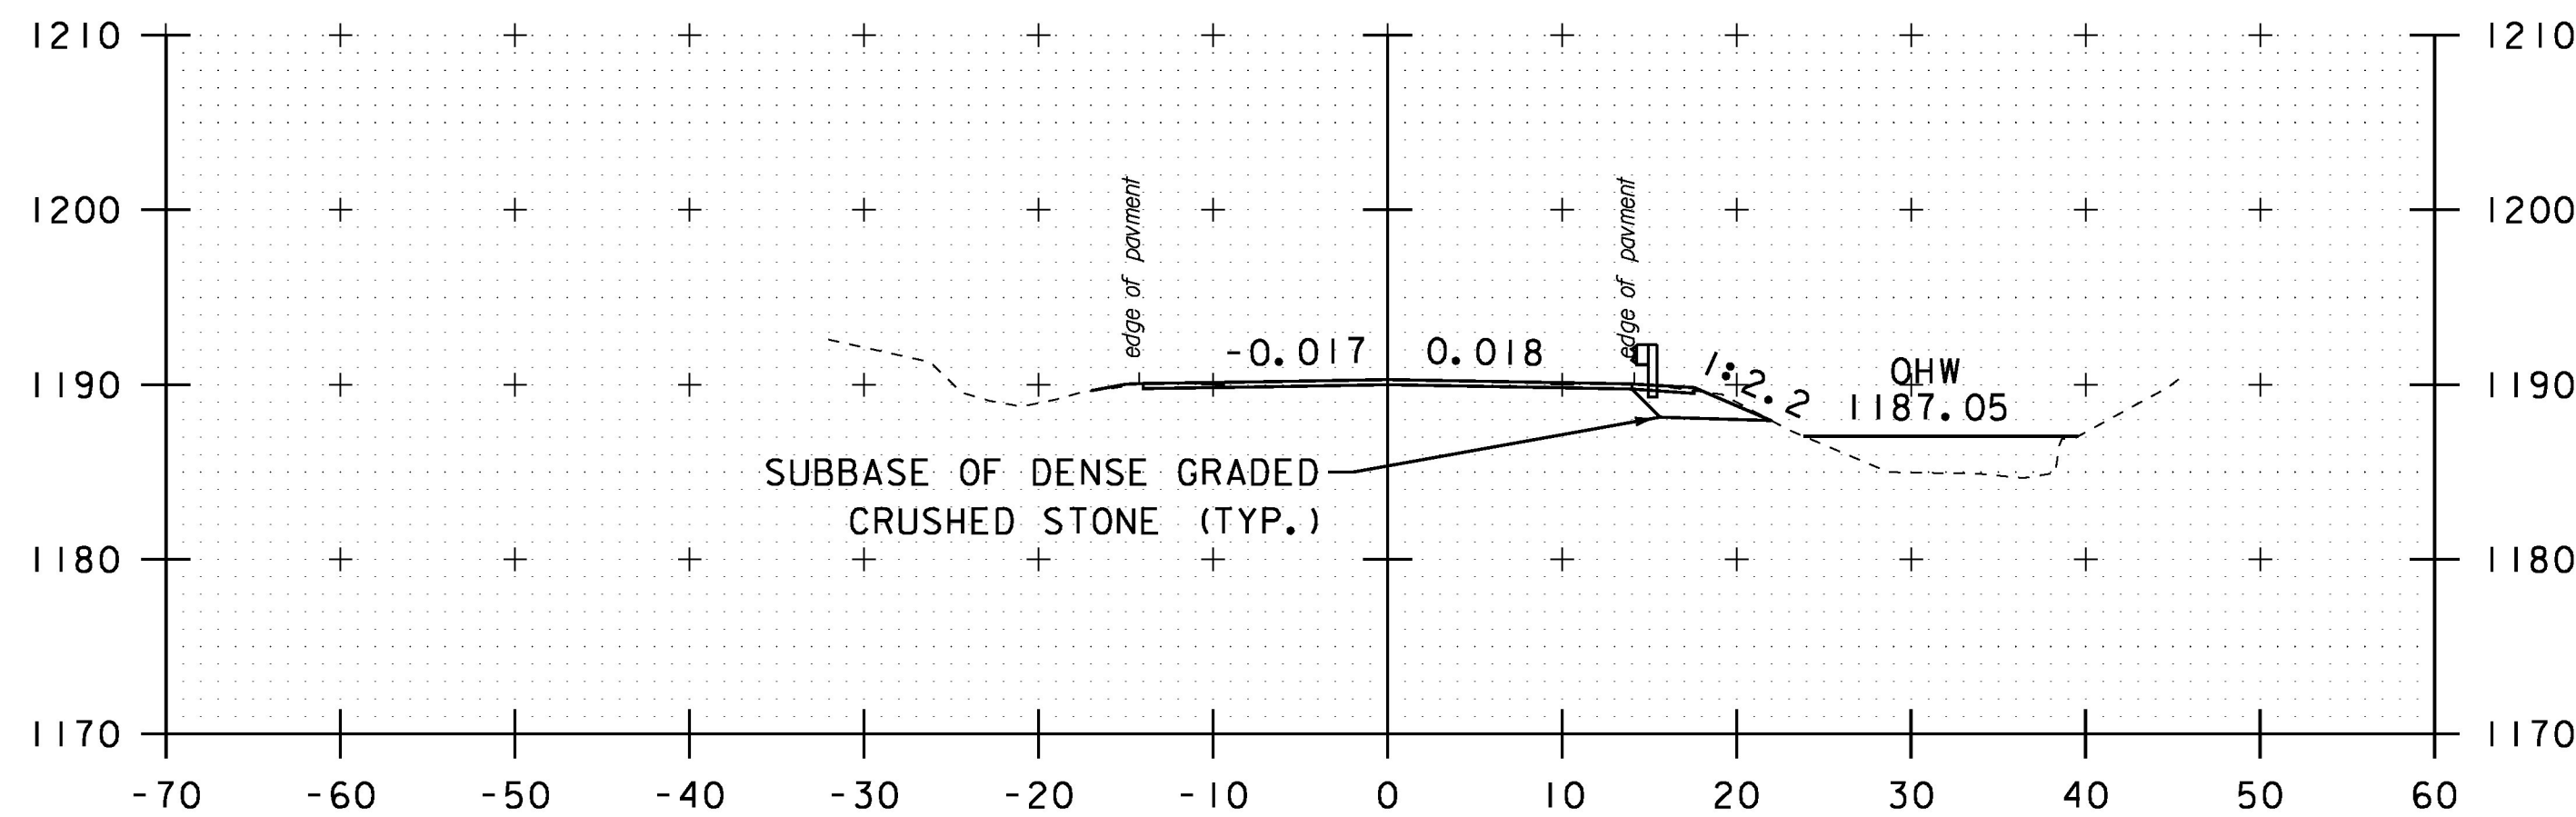

49+00

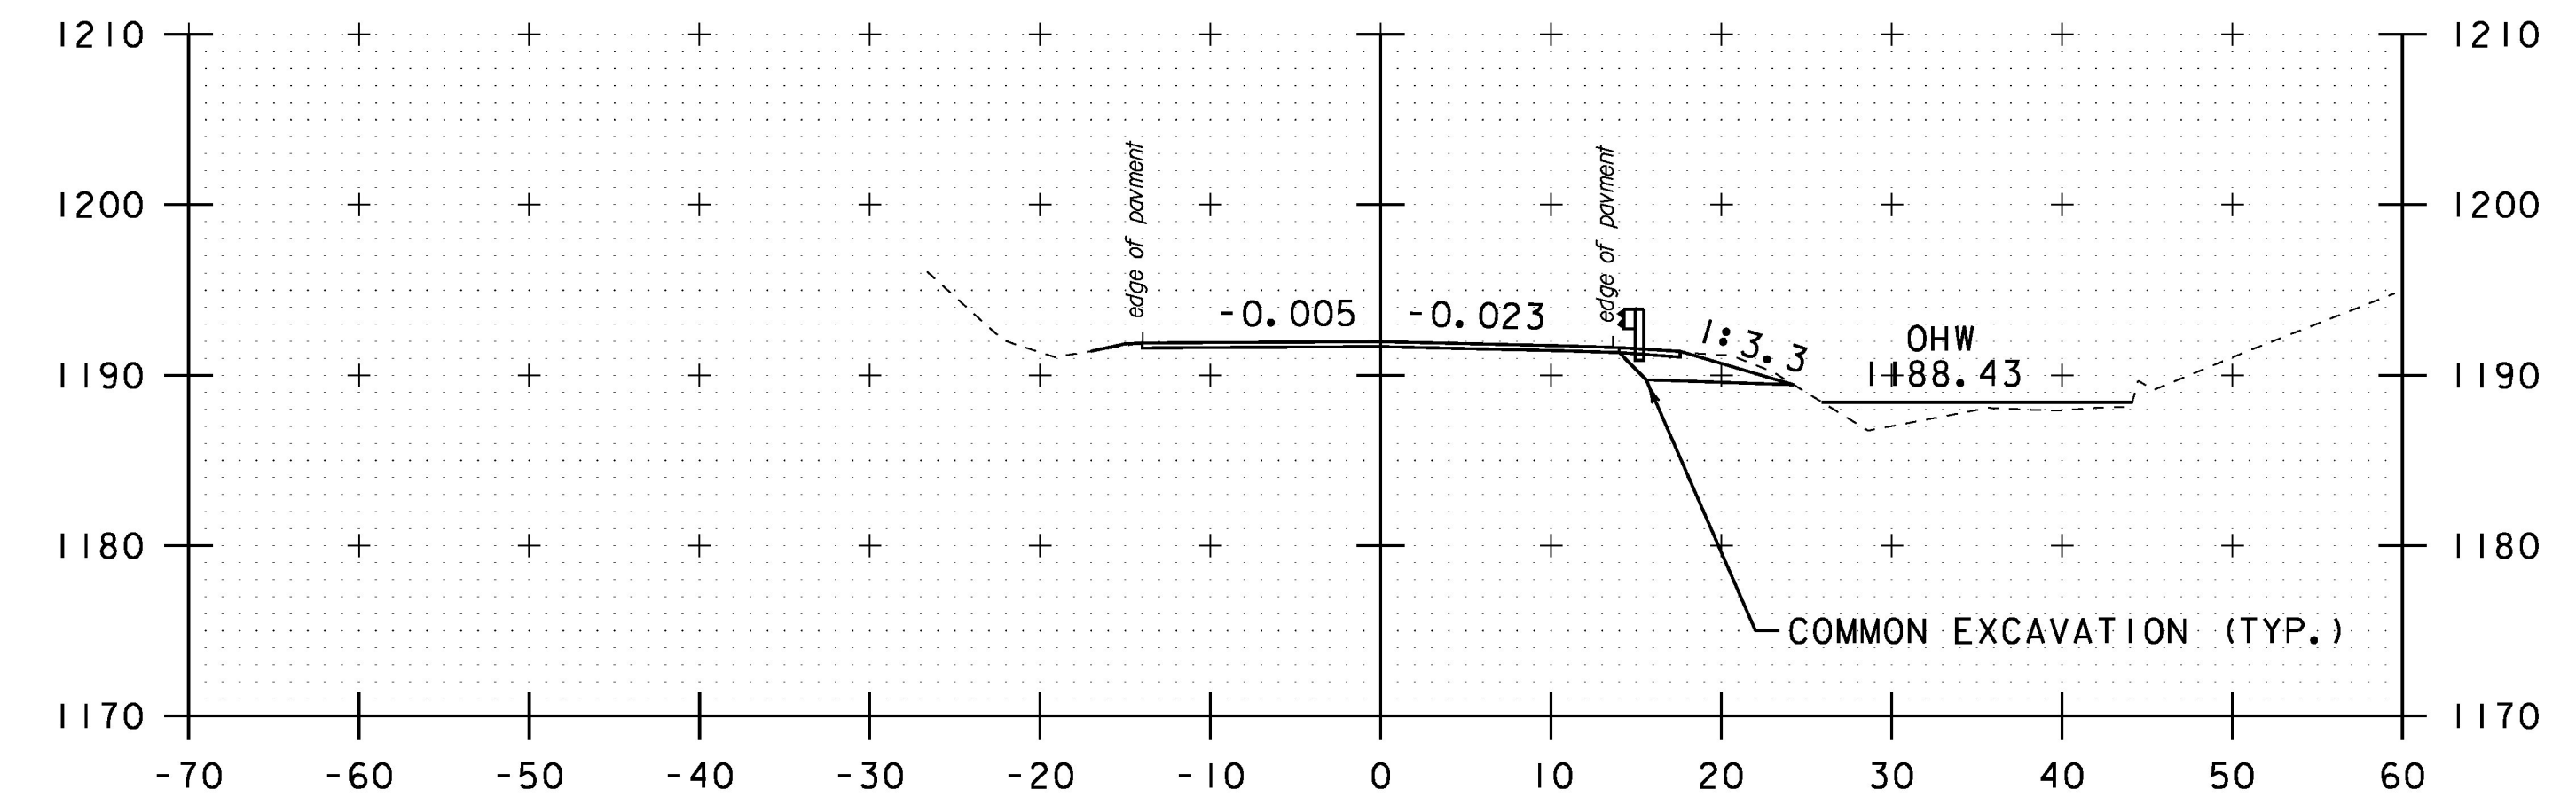

50+00

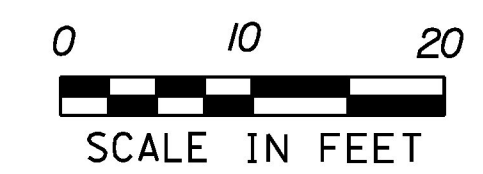

|                               |                   |
|-------------------------------|-------------------|
| STA. 49+00 TO STA. 50+50      |                   |
| PROJECT NAME:                 | GRANVILLE         |
| PROJECT NUMBER:               | ER STP 013-4 (40) |
| FILE NAME:                    | z12b520xs.dgn     |
| PROJECT LEADER:               | J. TUCKER         |
| DESIGNED BY:                  | B. BRESLEND       |
| VT 100 CROSS SECTION SHEET 24 |                   |
| PLOT DATE:                    | 7/8/2015          |
| DRAWN BY:                     | B. BRESLEND       |
| CHECKED BY:                   | A. SANZ           |
| SHEET                         | 111 OF 141        |