




51+50

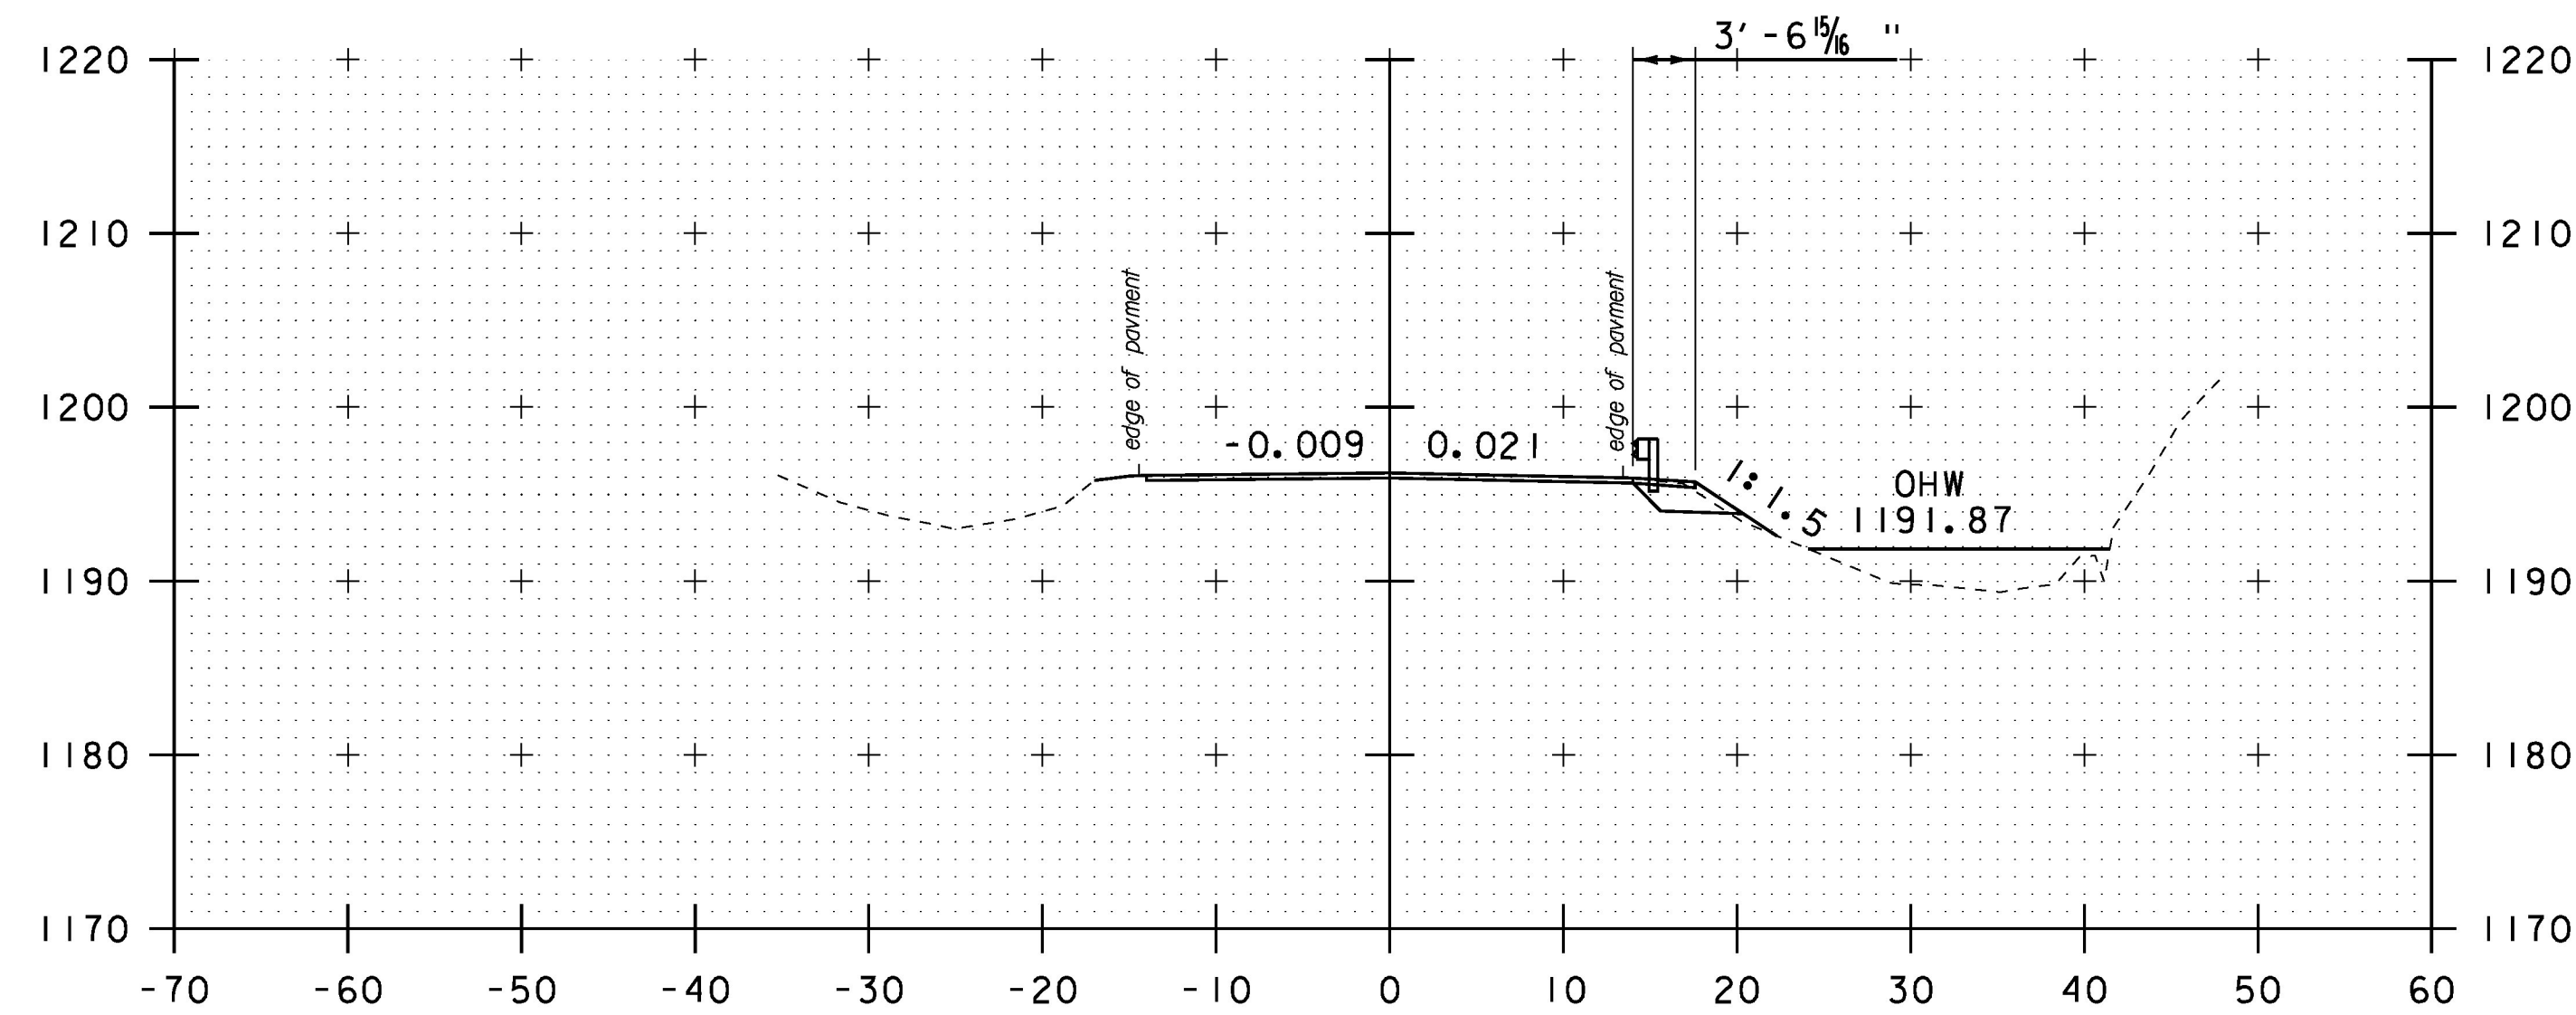

52+50

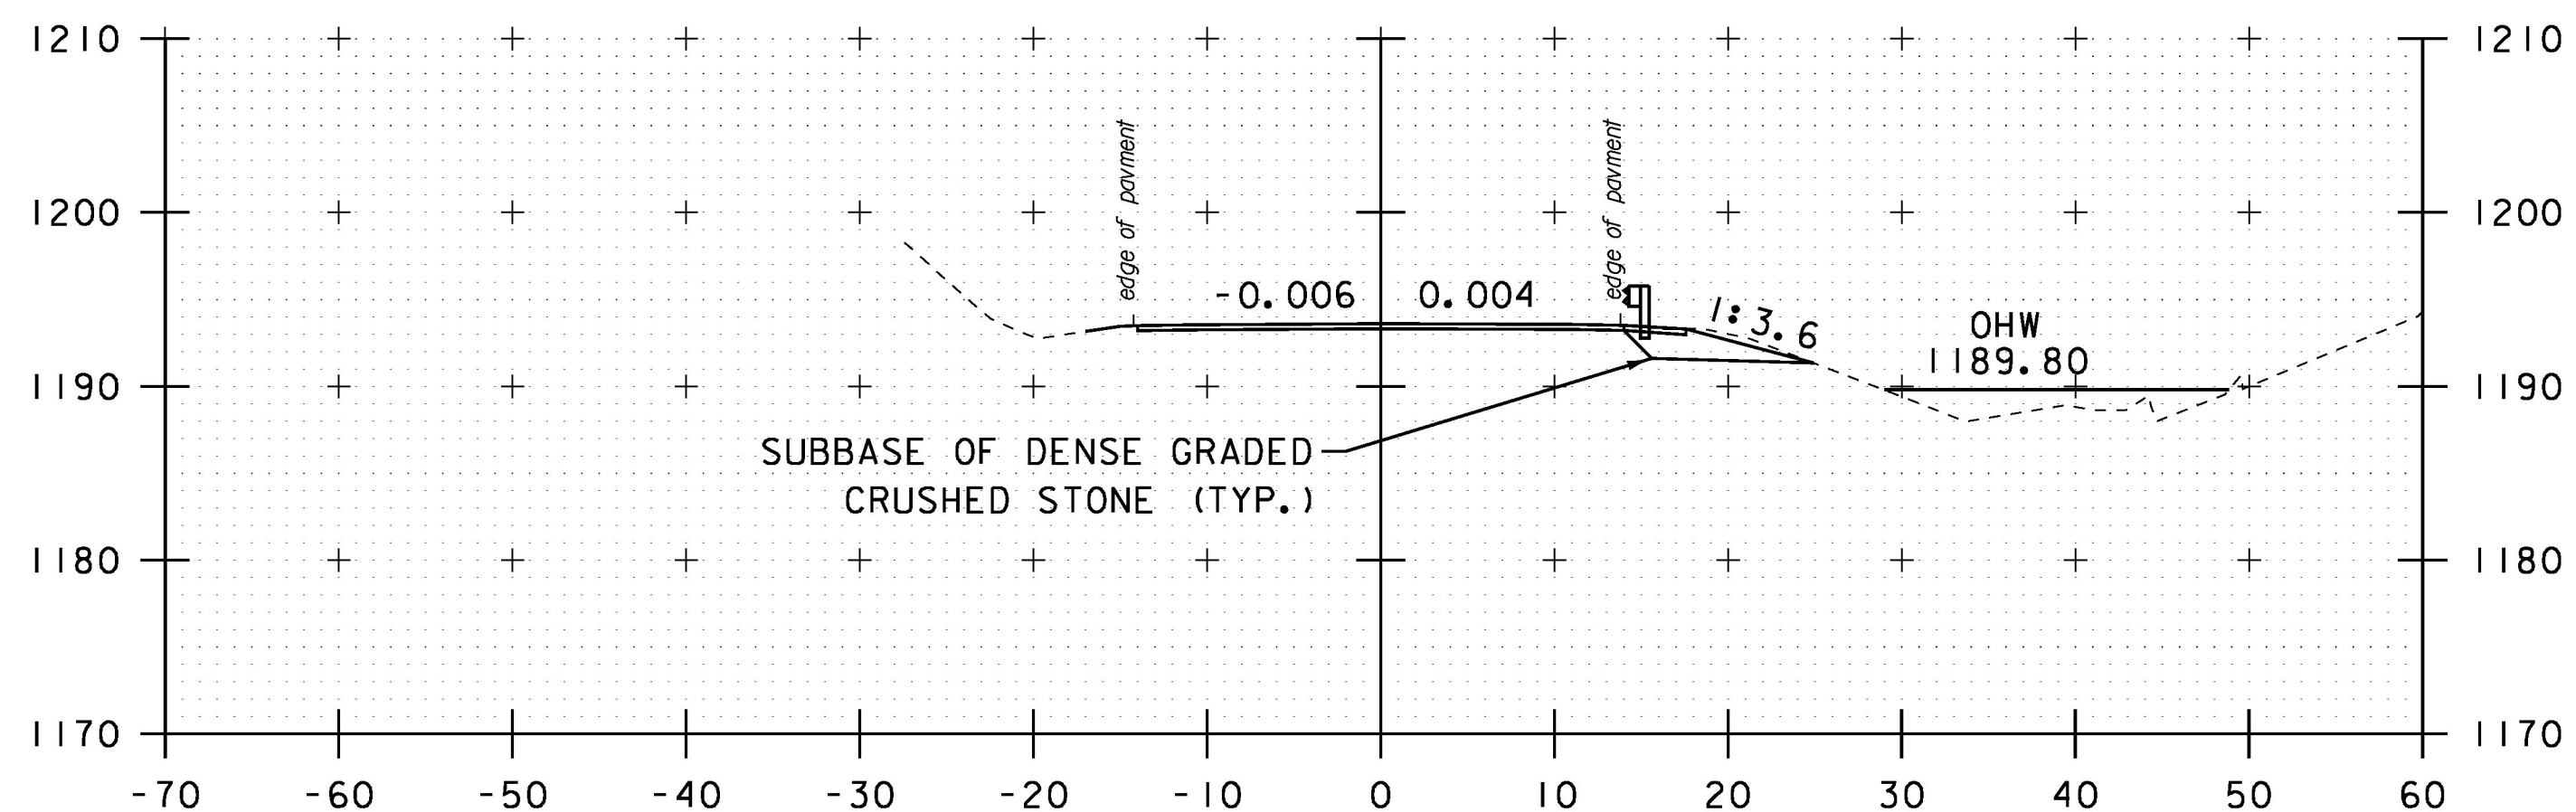

51+00

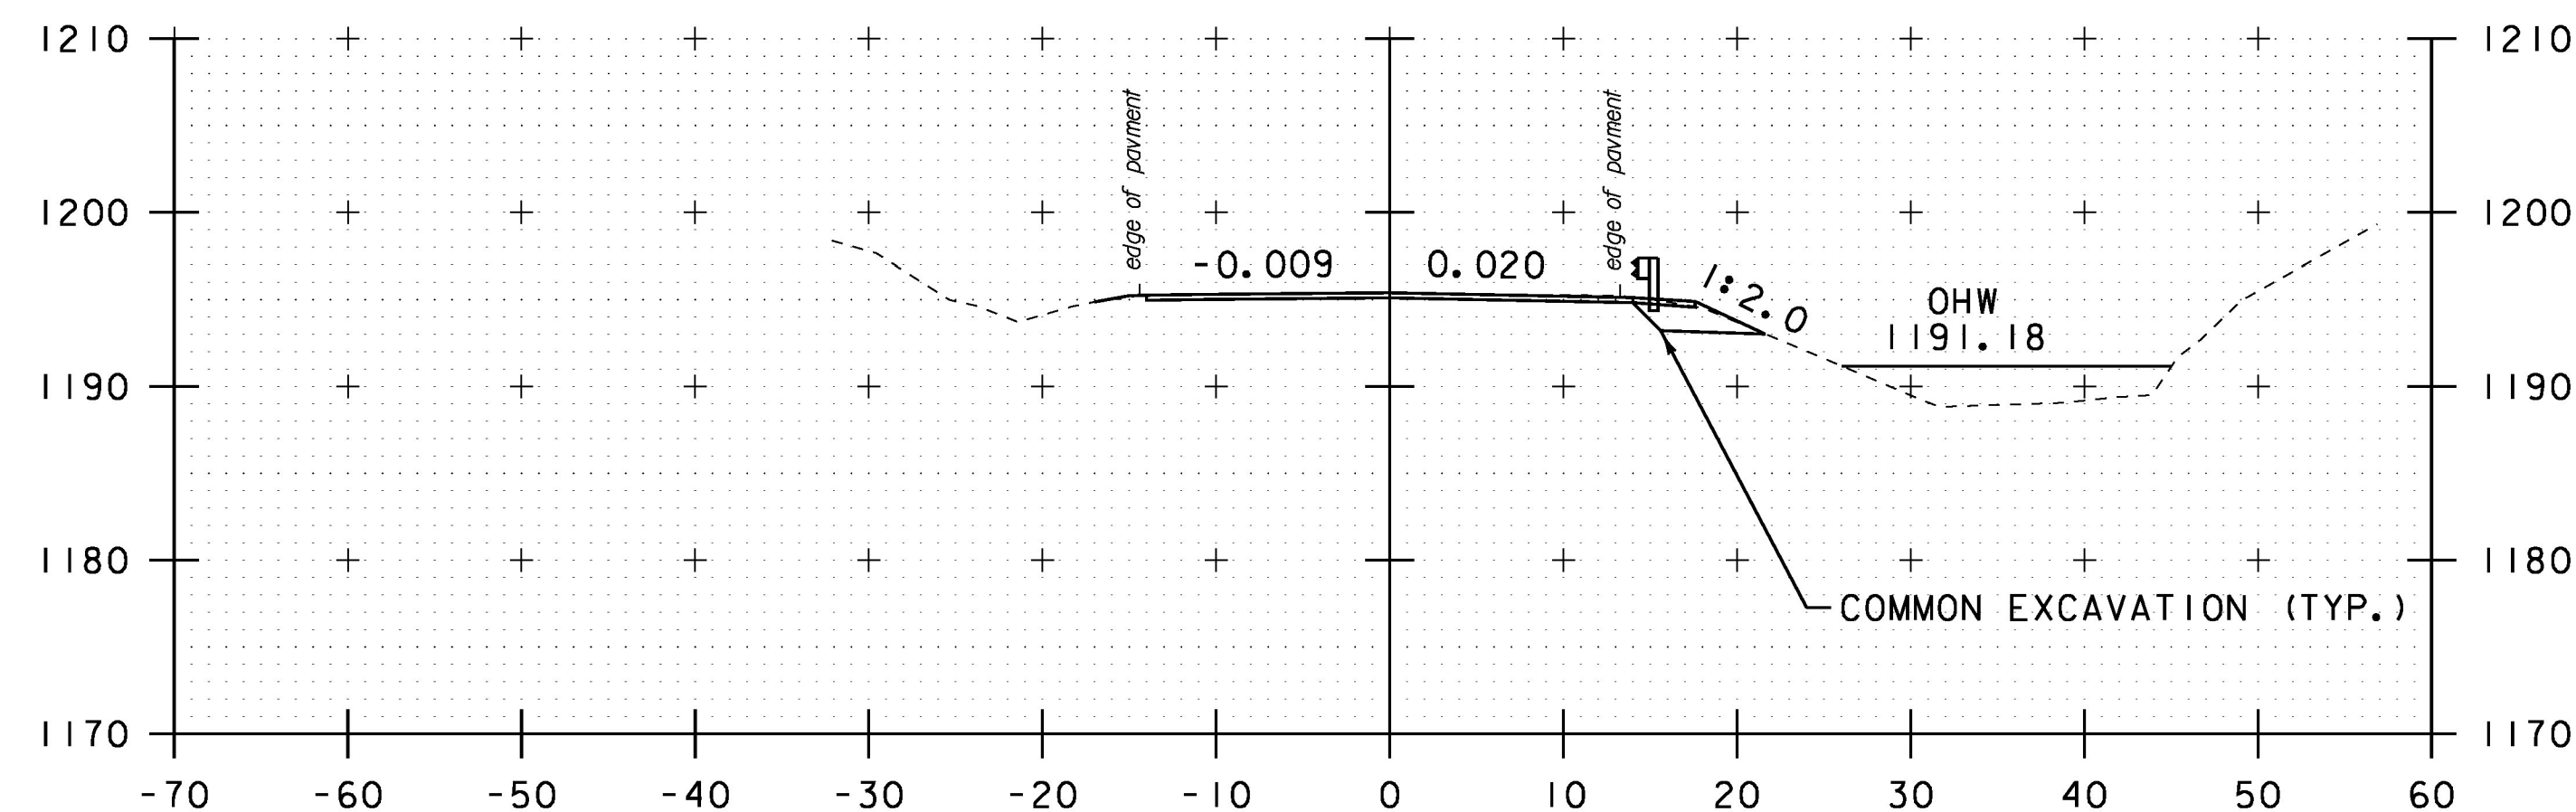

52+00



STA. 51+00 TO STA. 52+50

PROJECT NAME: GRANVILLE
PROJECT NUMBER: ER STP 013-4 (40)

FILE NAME: z12b520xs.dgn
PROJECT LEADER: J. TUCKER
DESIGNED BY: B. BRESLEND
VT 100 CROSS SECTION SHEET 25

PLOT DATE: 7/8/2015
DRAWN BY: B. BRESLEND
CHECKED BY: A. SANZ
SHEET 112 OF 141