




53+50

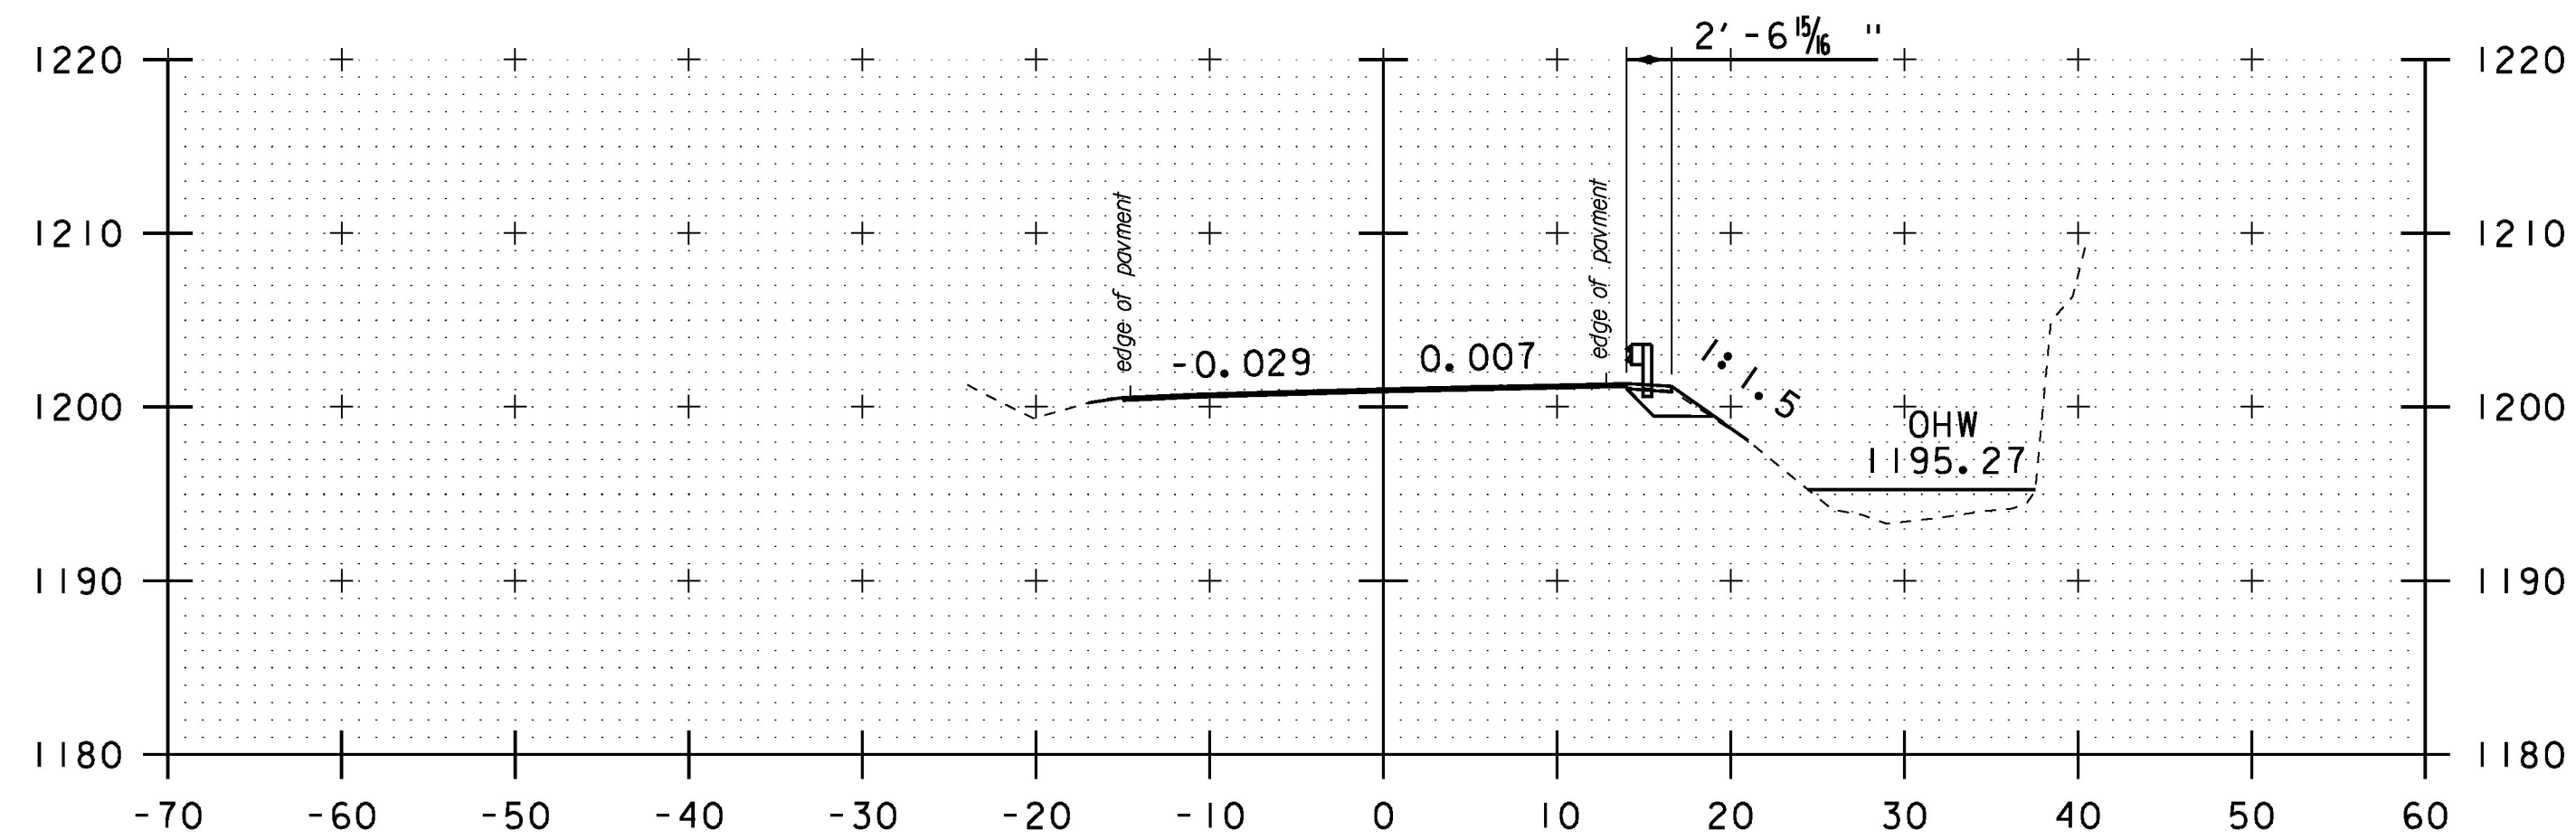


54+50

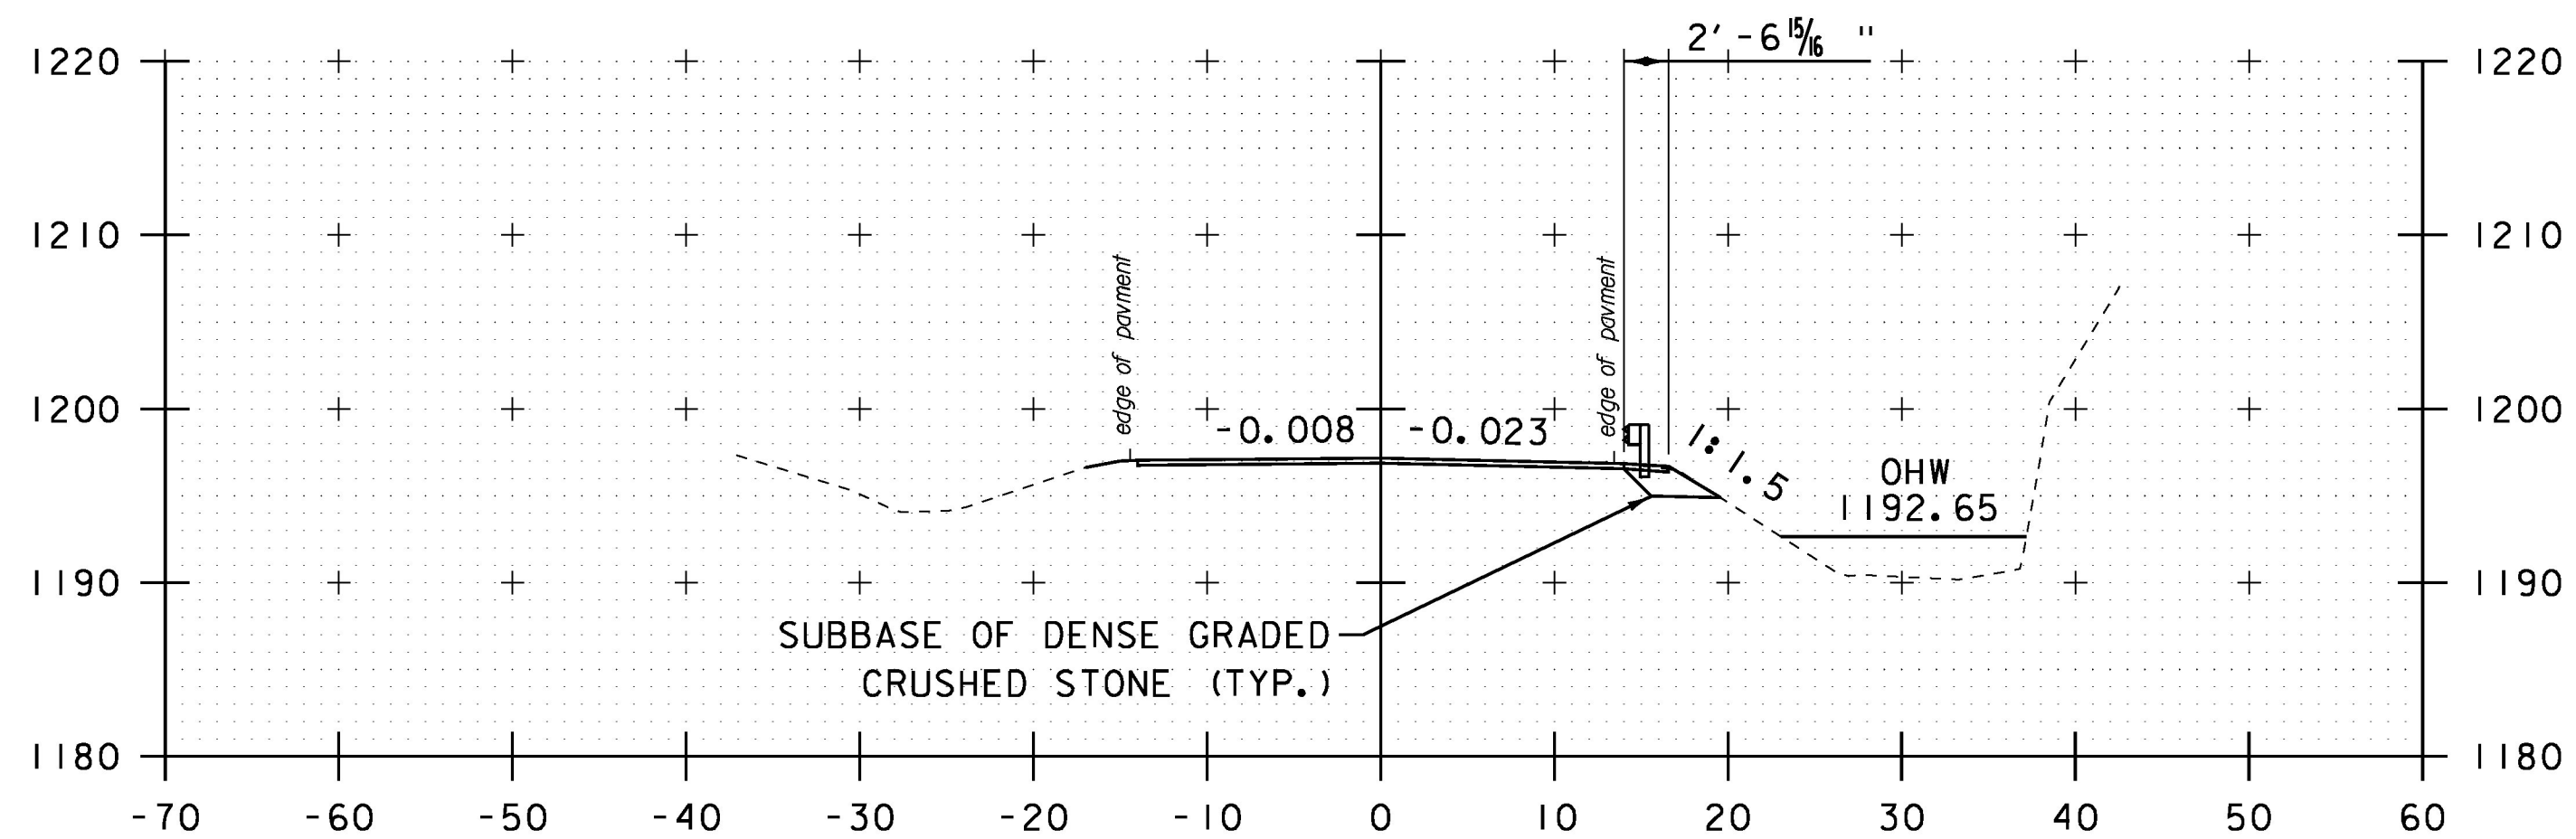

53+00

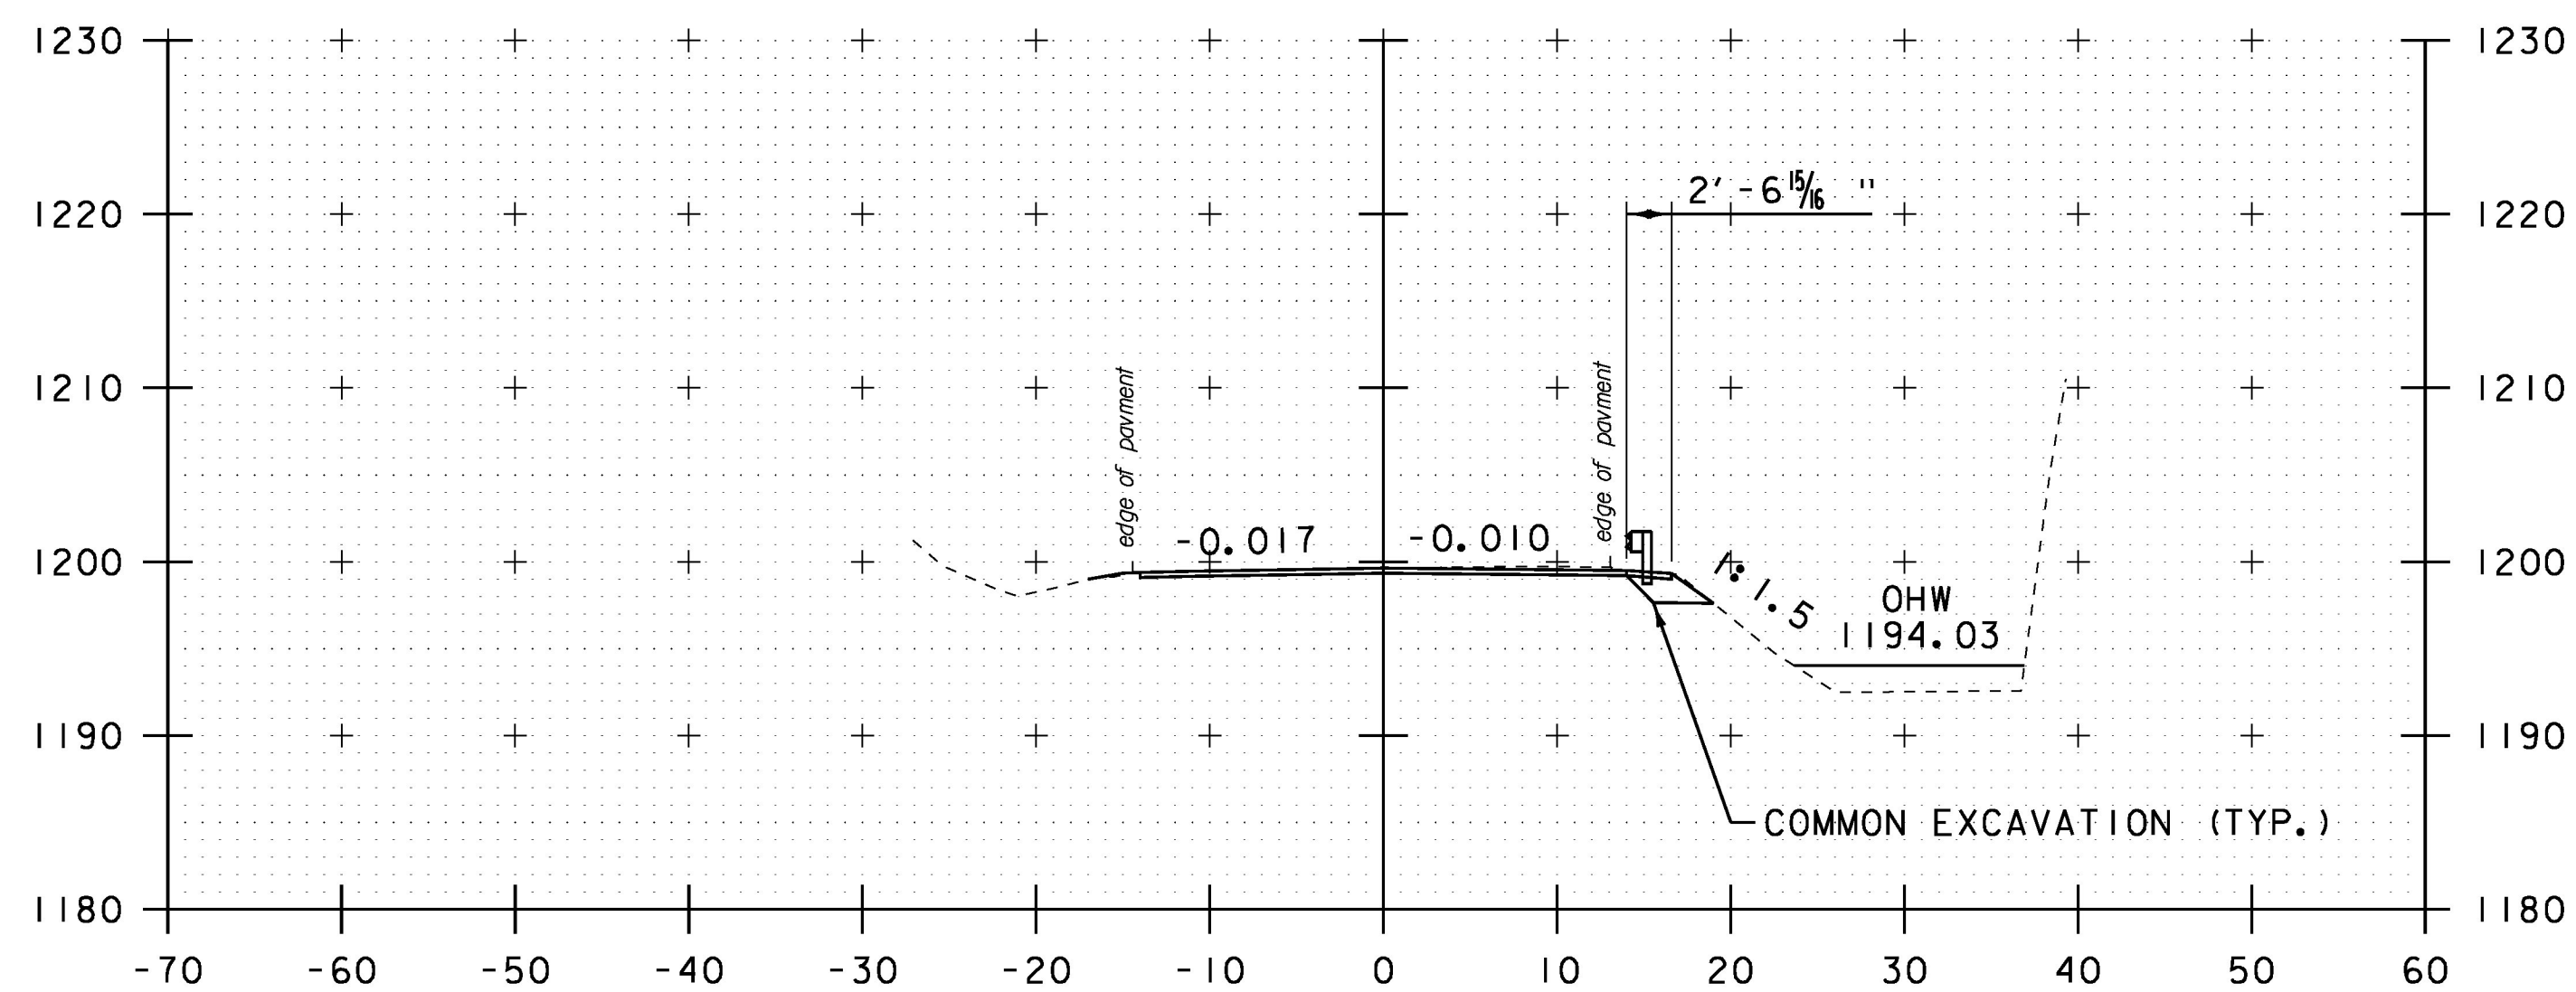

54+00

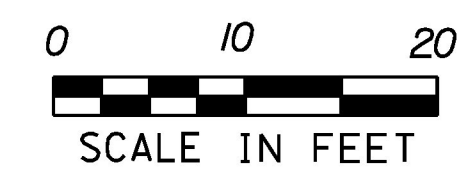

STA. 53+00 TO STA. 54+50

PROJECT NAME: GRANVILLE
PROJECT NUMBER: ER STP 013-4 (40)

FILE NAME: z12b520xs.dgn
PROJECT LEADER: J. TUCKER
DESIGNED BY: B. BRESLEND
VT 100 CROSS SECTION SHEET 26

PLOT DATE: 7/8/2015
DRAWN BY: B. BRESLEND
CHECKED BY: A. SANZ
SHEET 113 OF 141