




55+50

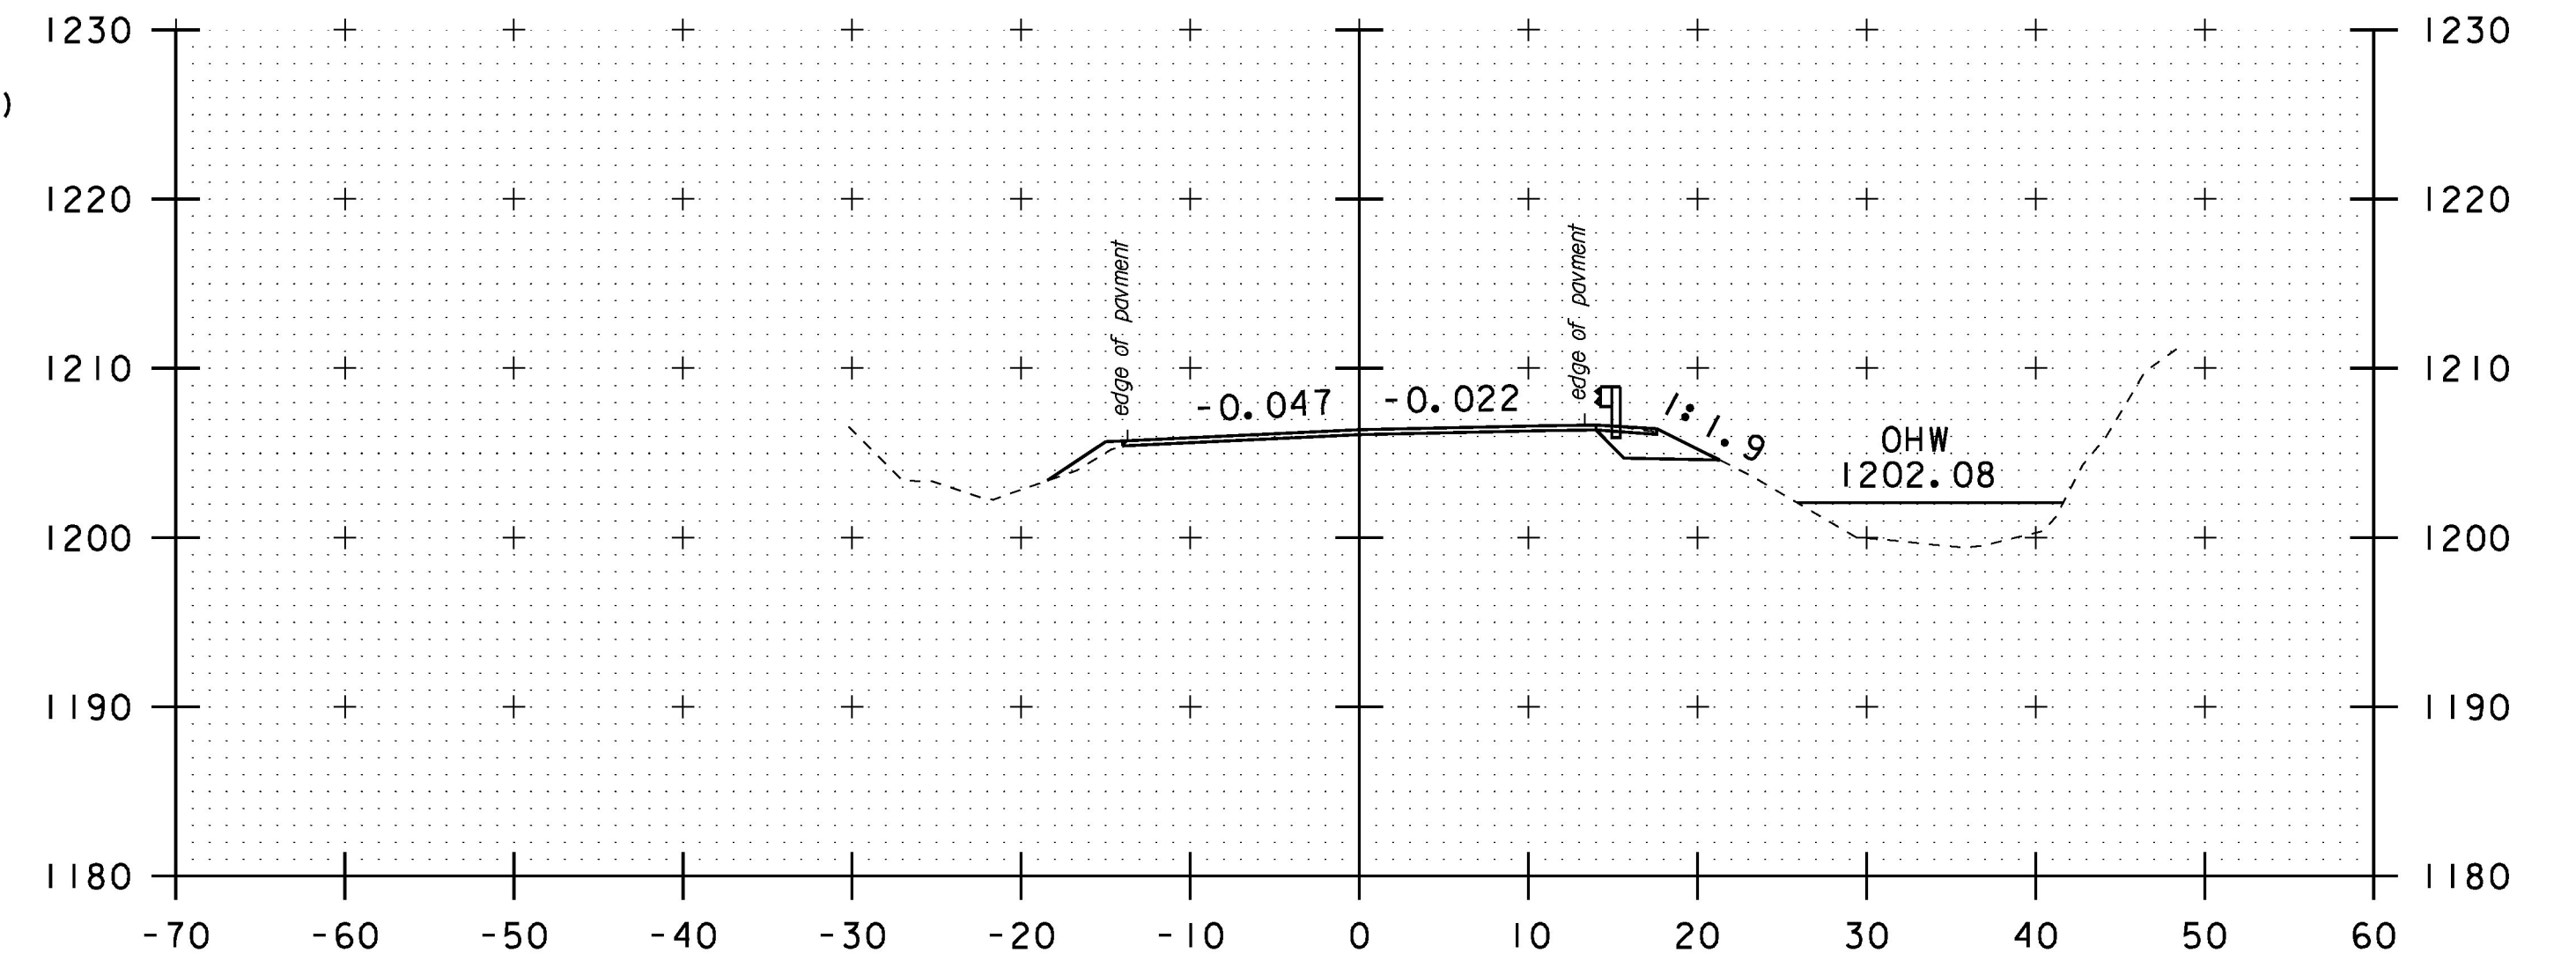


56+50

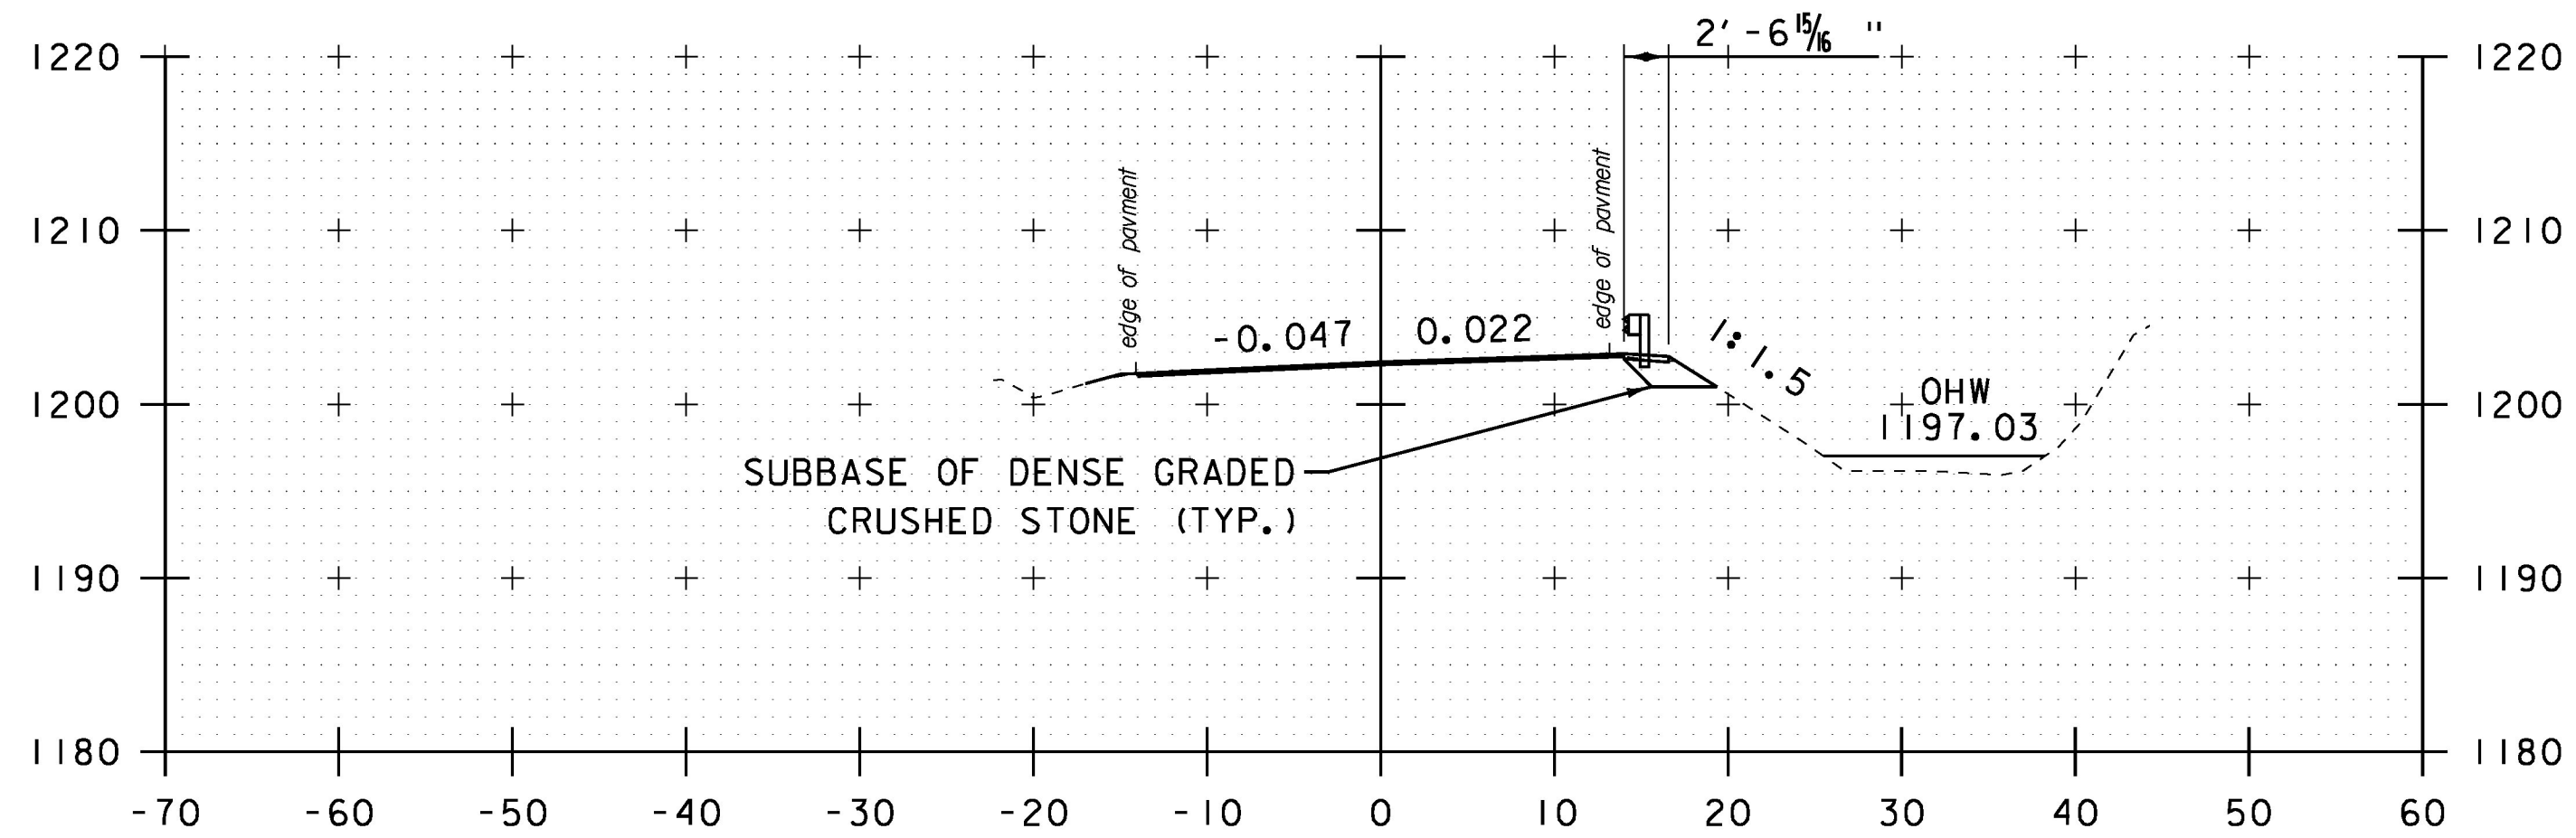

55+00

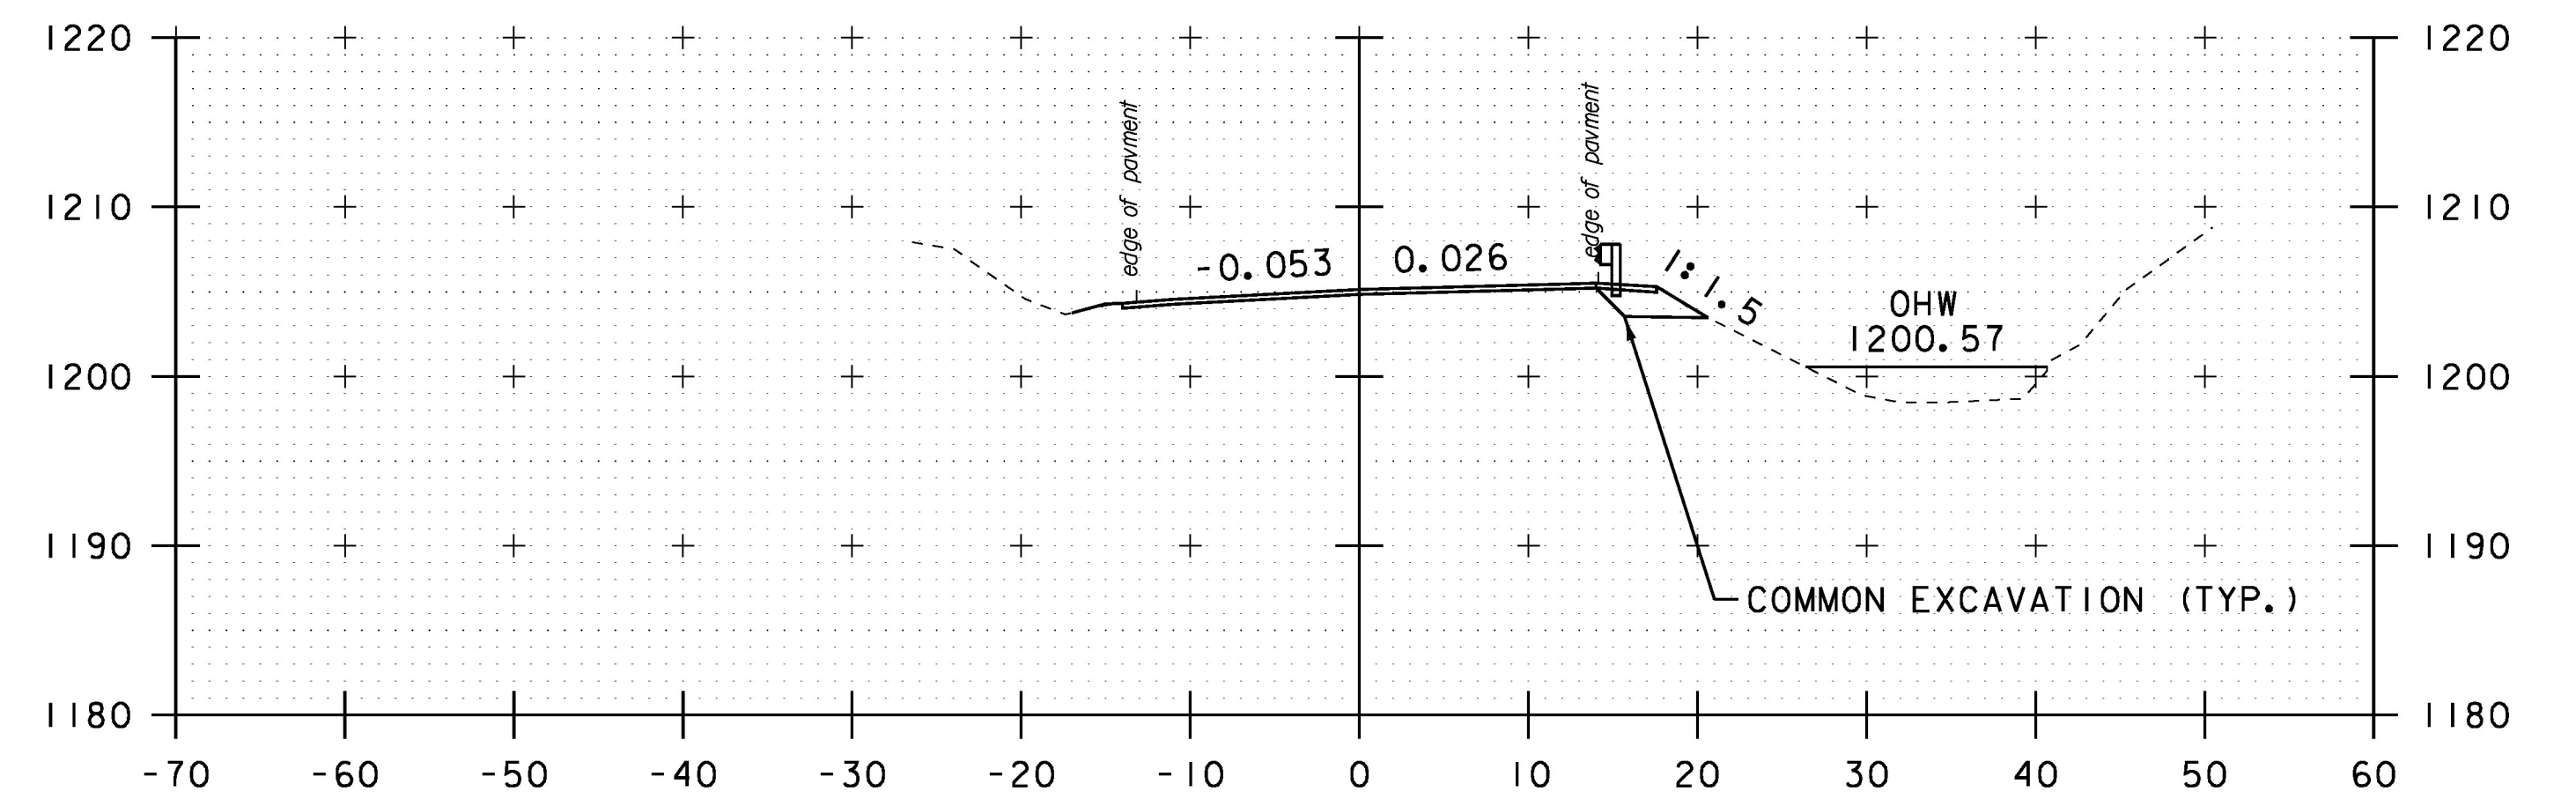

56+00

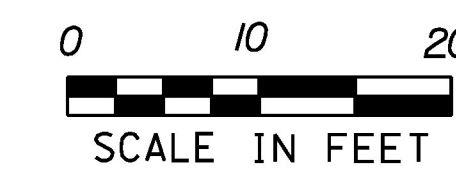

STA. 55+00 TO STA. 56+50

PROJECT NAME: GRANVILLE  
PROJECT NUMBER: ER STP 013-4 (40)

FILE NAME: z12b520xs.dgn	PLOT DATE: 7/8/2015
PROJECT LEADER: J. TUCKER	DRAWN BY: B. BRESLEND
DESIGNED BY: B. BRESLEND	CHECKED BY: A. SANZ
VT 100 CROSS SECTION SHEET 27	SHEET 114 OF 141