




63+50

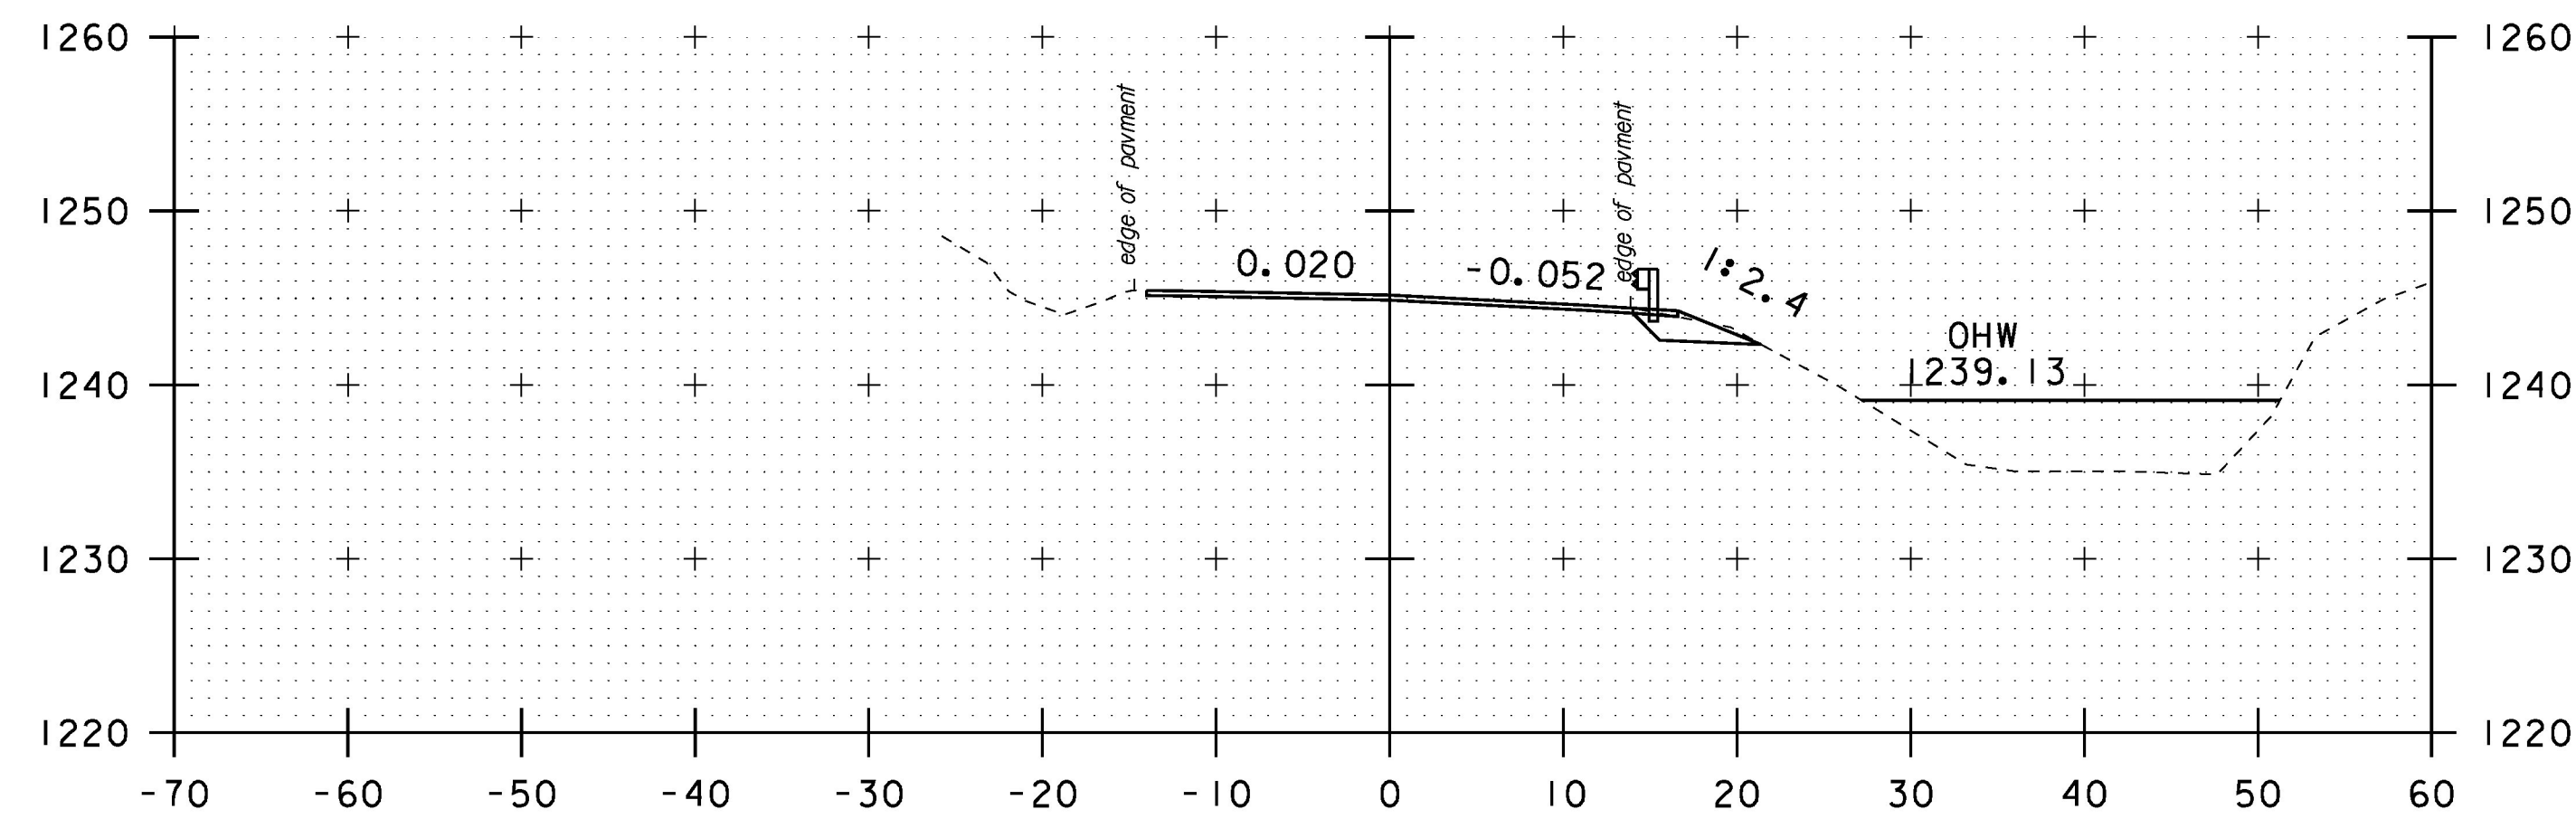


64+50

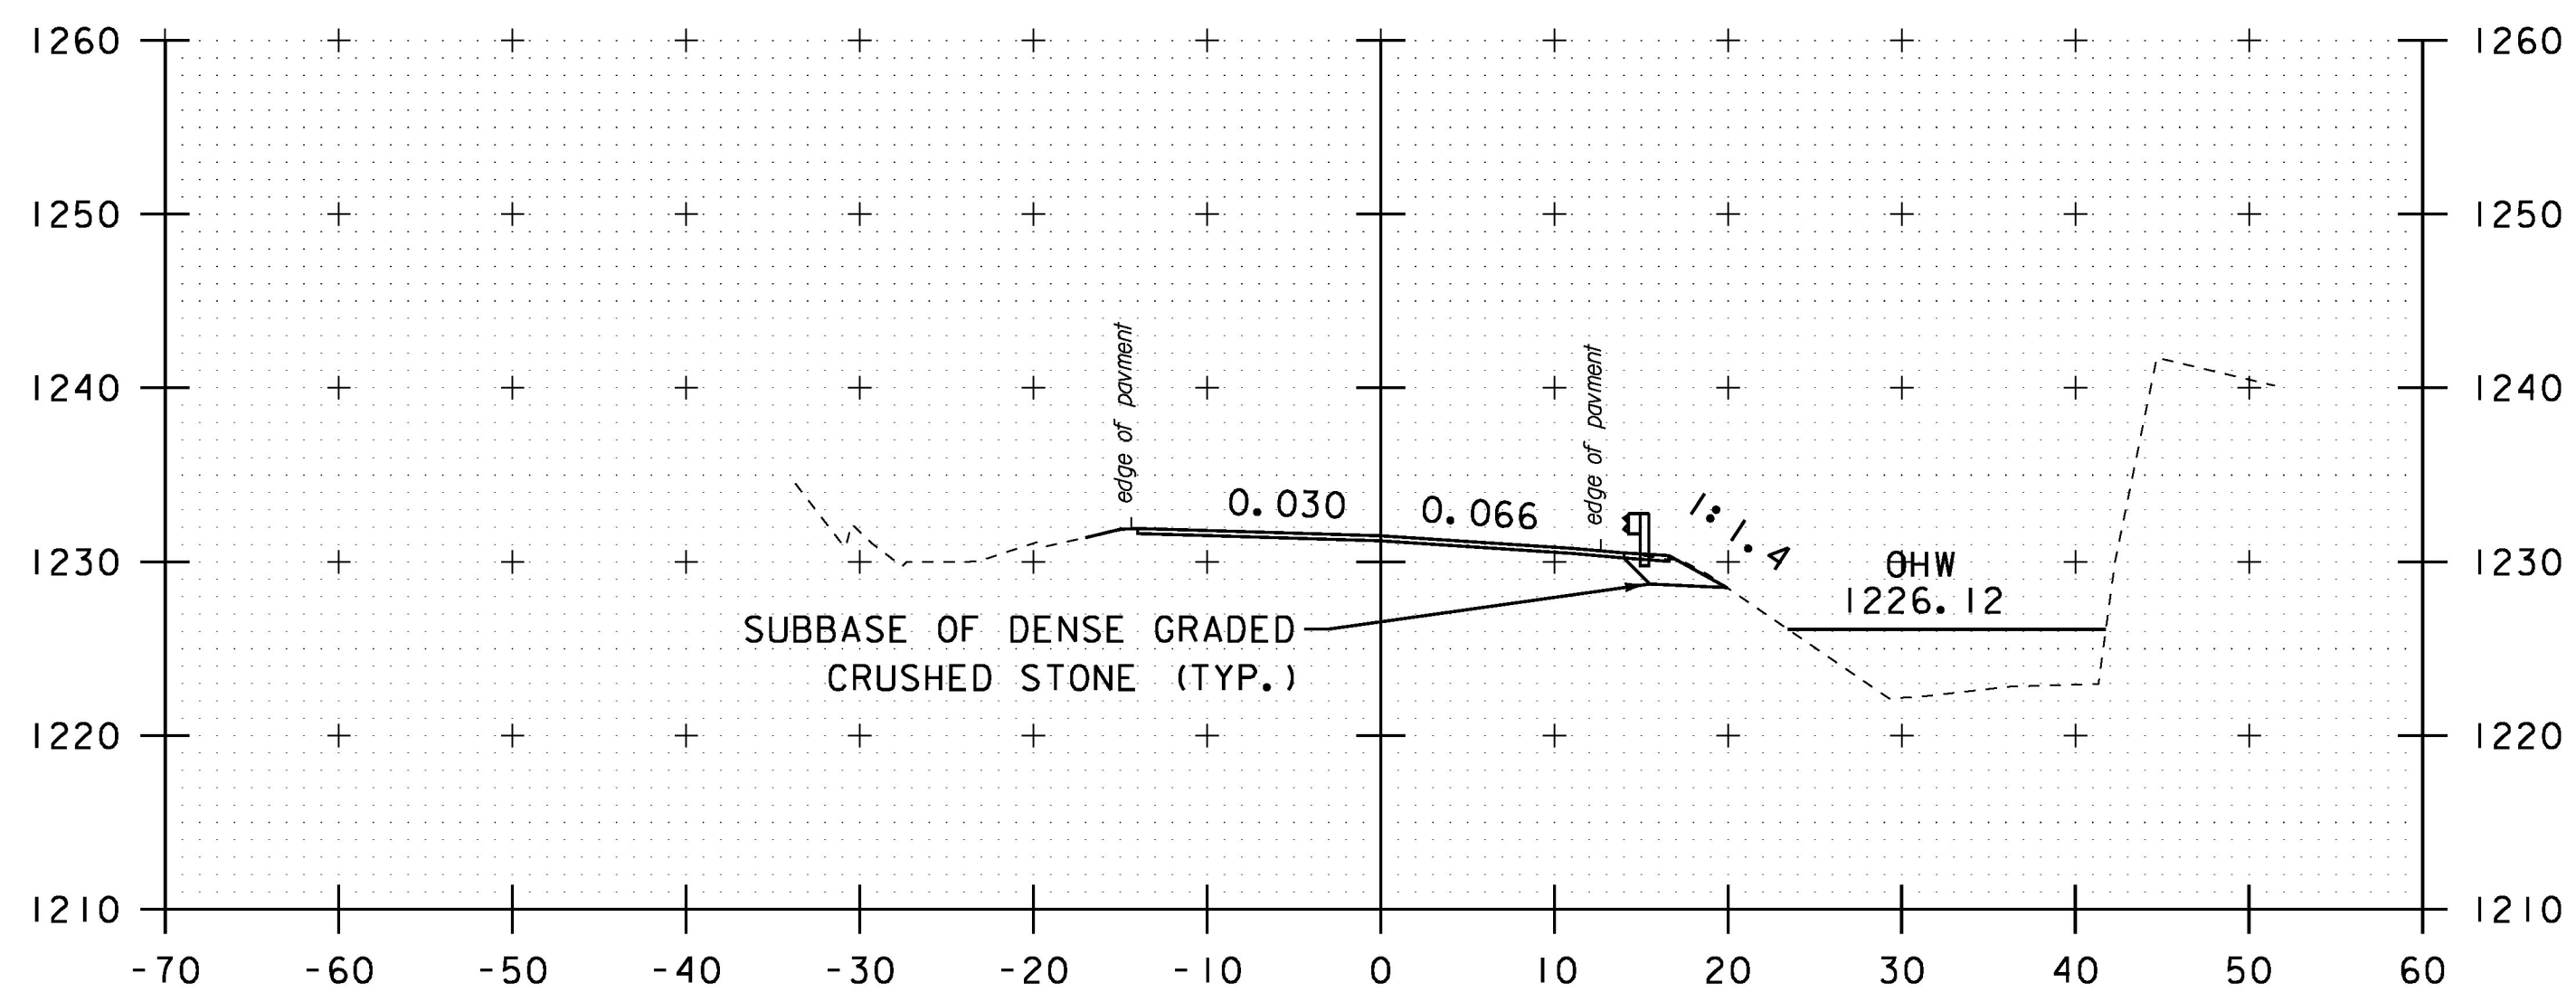

63+00

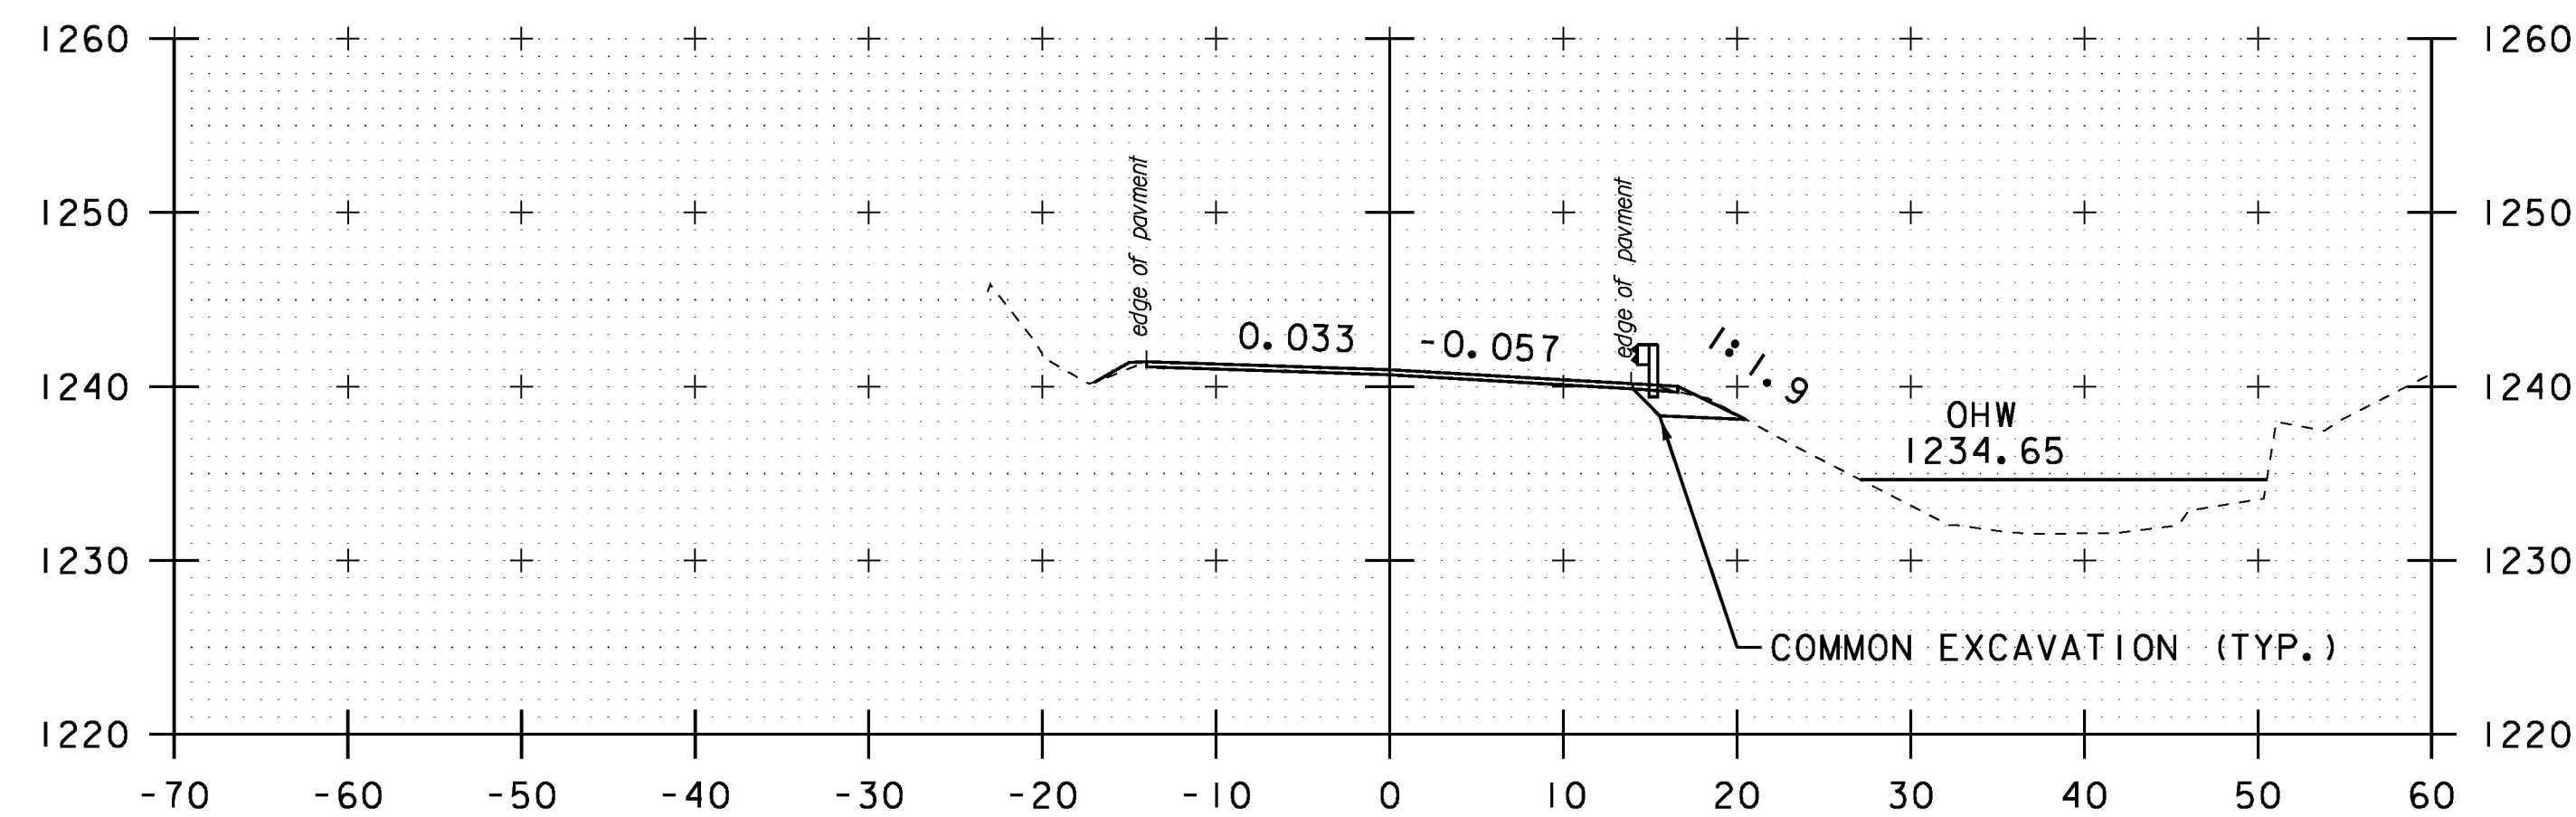

64+00

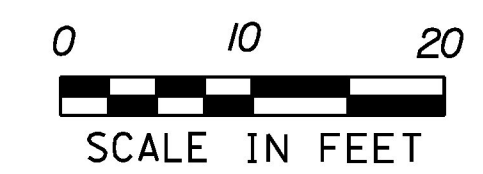

STA. 63+00 TO STA. 64+50	
PROJECT NAME:	GRANVILLE
PROJECT NUMBER:	ER STP 013-4 (40)
FILE NAME:	z12b520xs.dgn
PROJECT LEADER:	J. TUCKER
DESIGNED BY:	B. BRESLEND
VT 100 CROSS SECTION SHEET 31	CHECKED BY: A. SANZ
	PLOT DATE: 7/8/2015
	DRAWN BY: B. BRESLEND
	SHEET 118 OF 141