




65+50

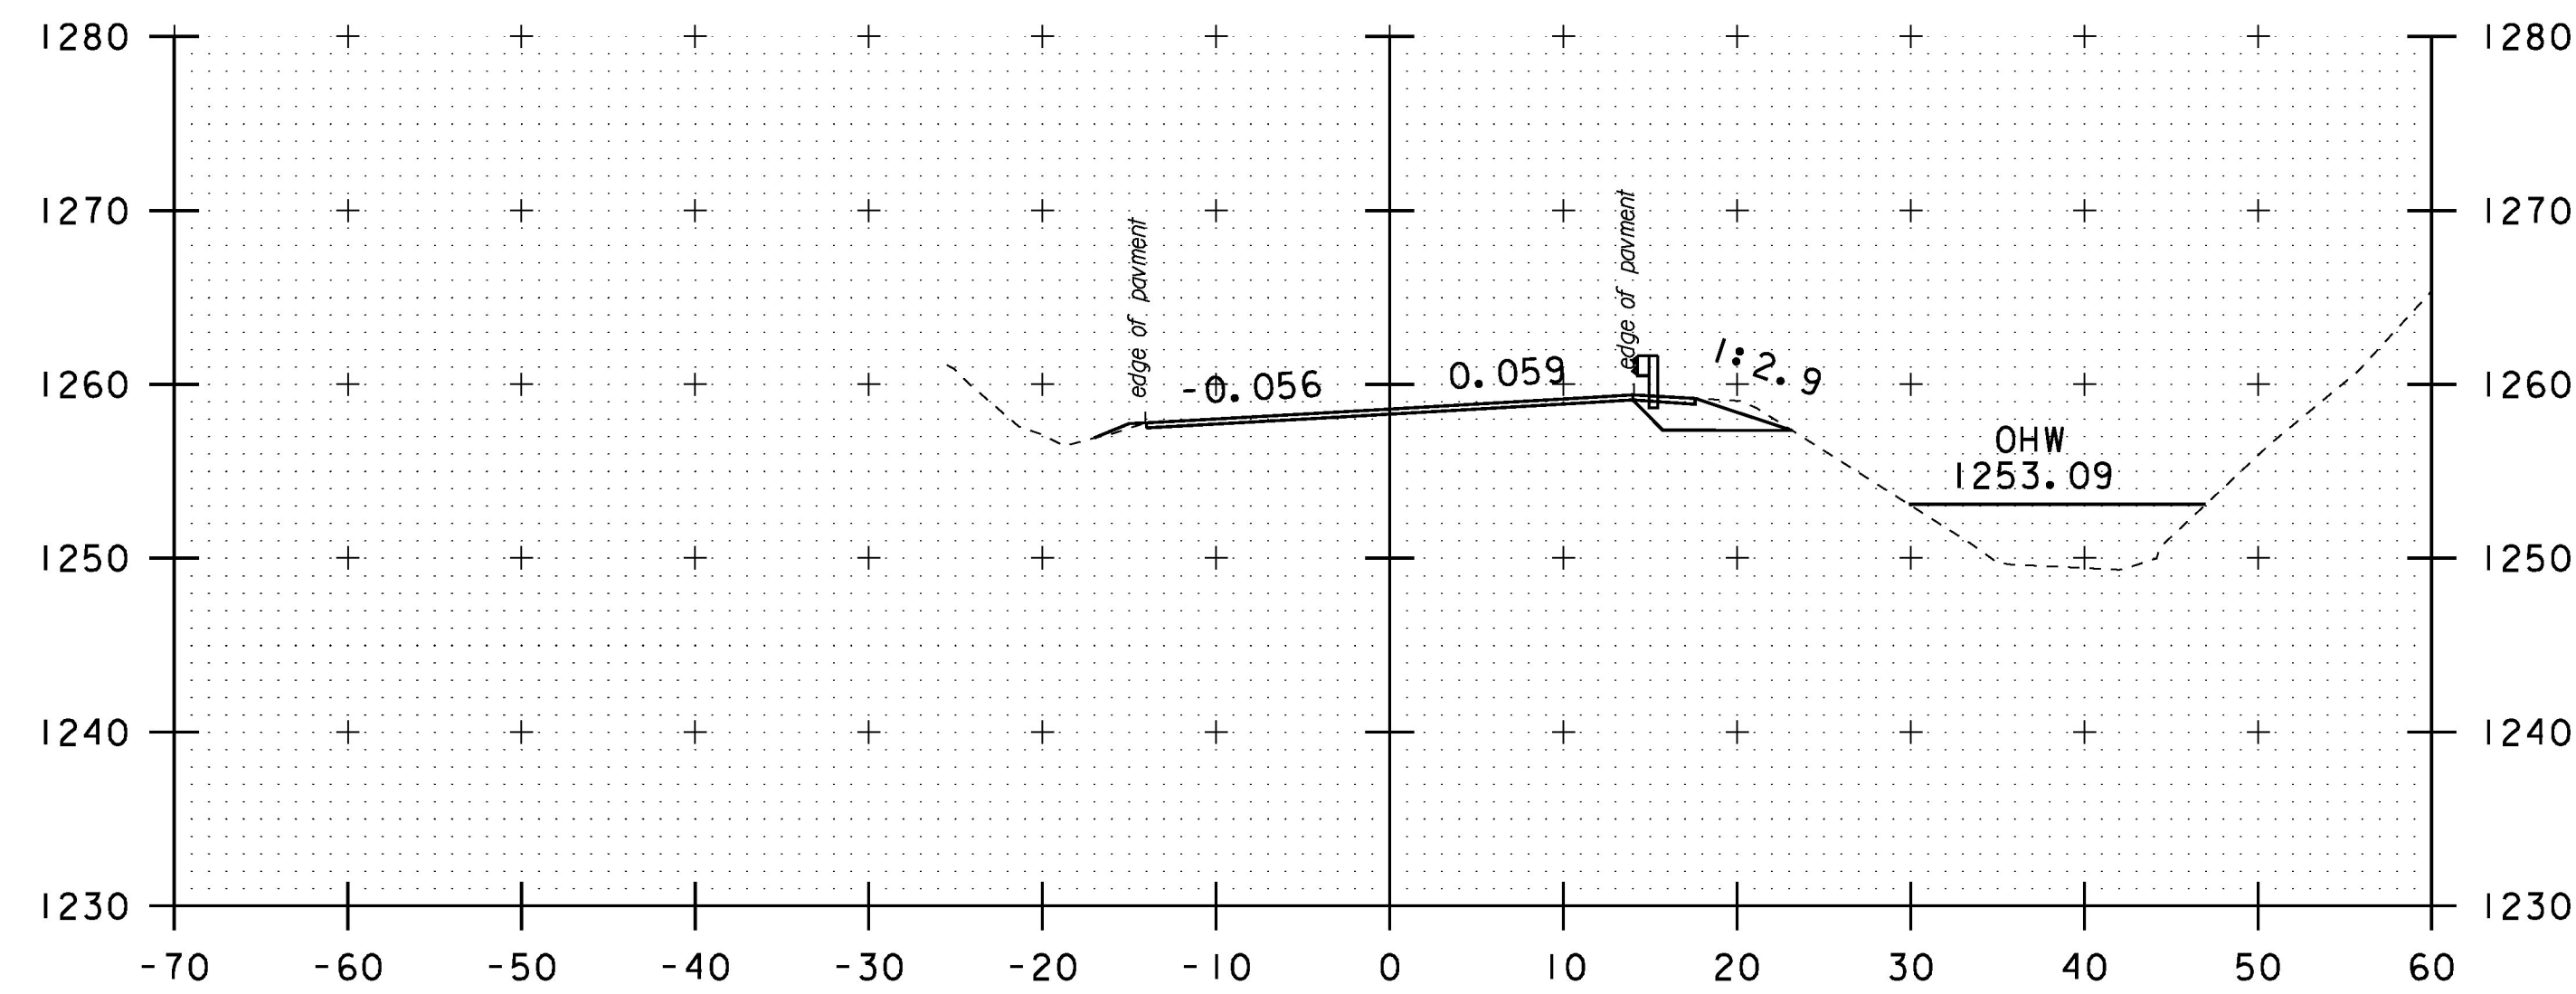


66+50

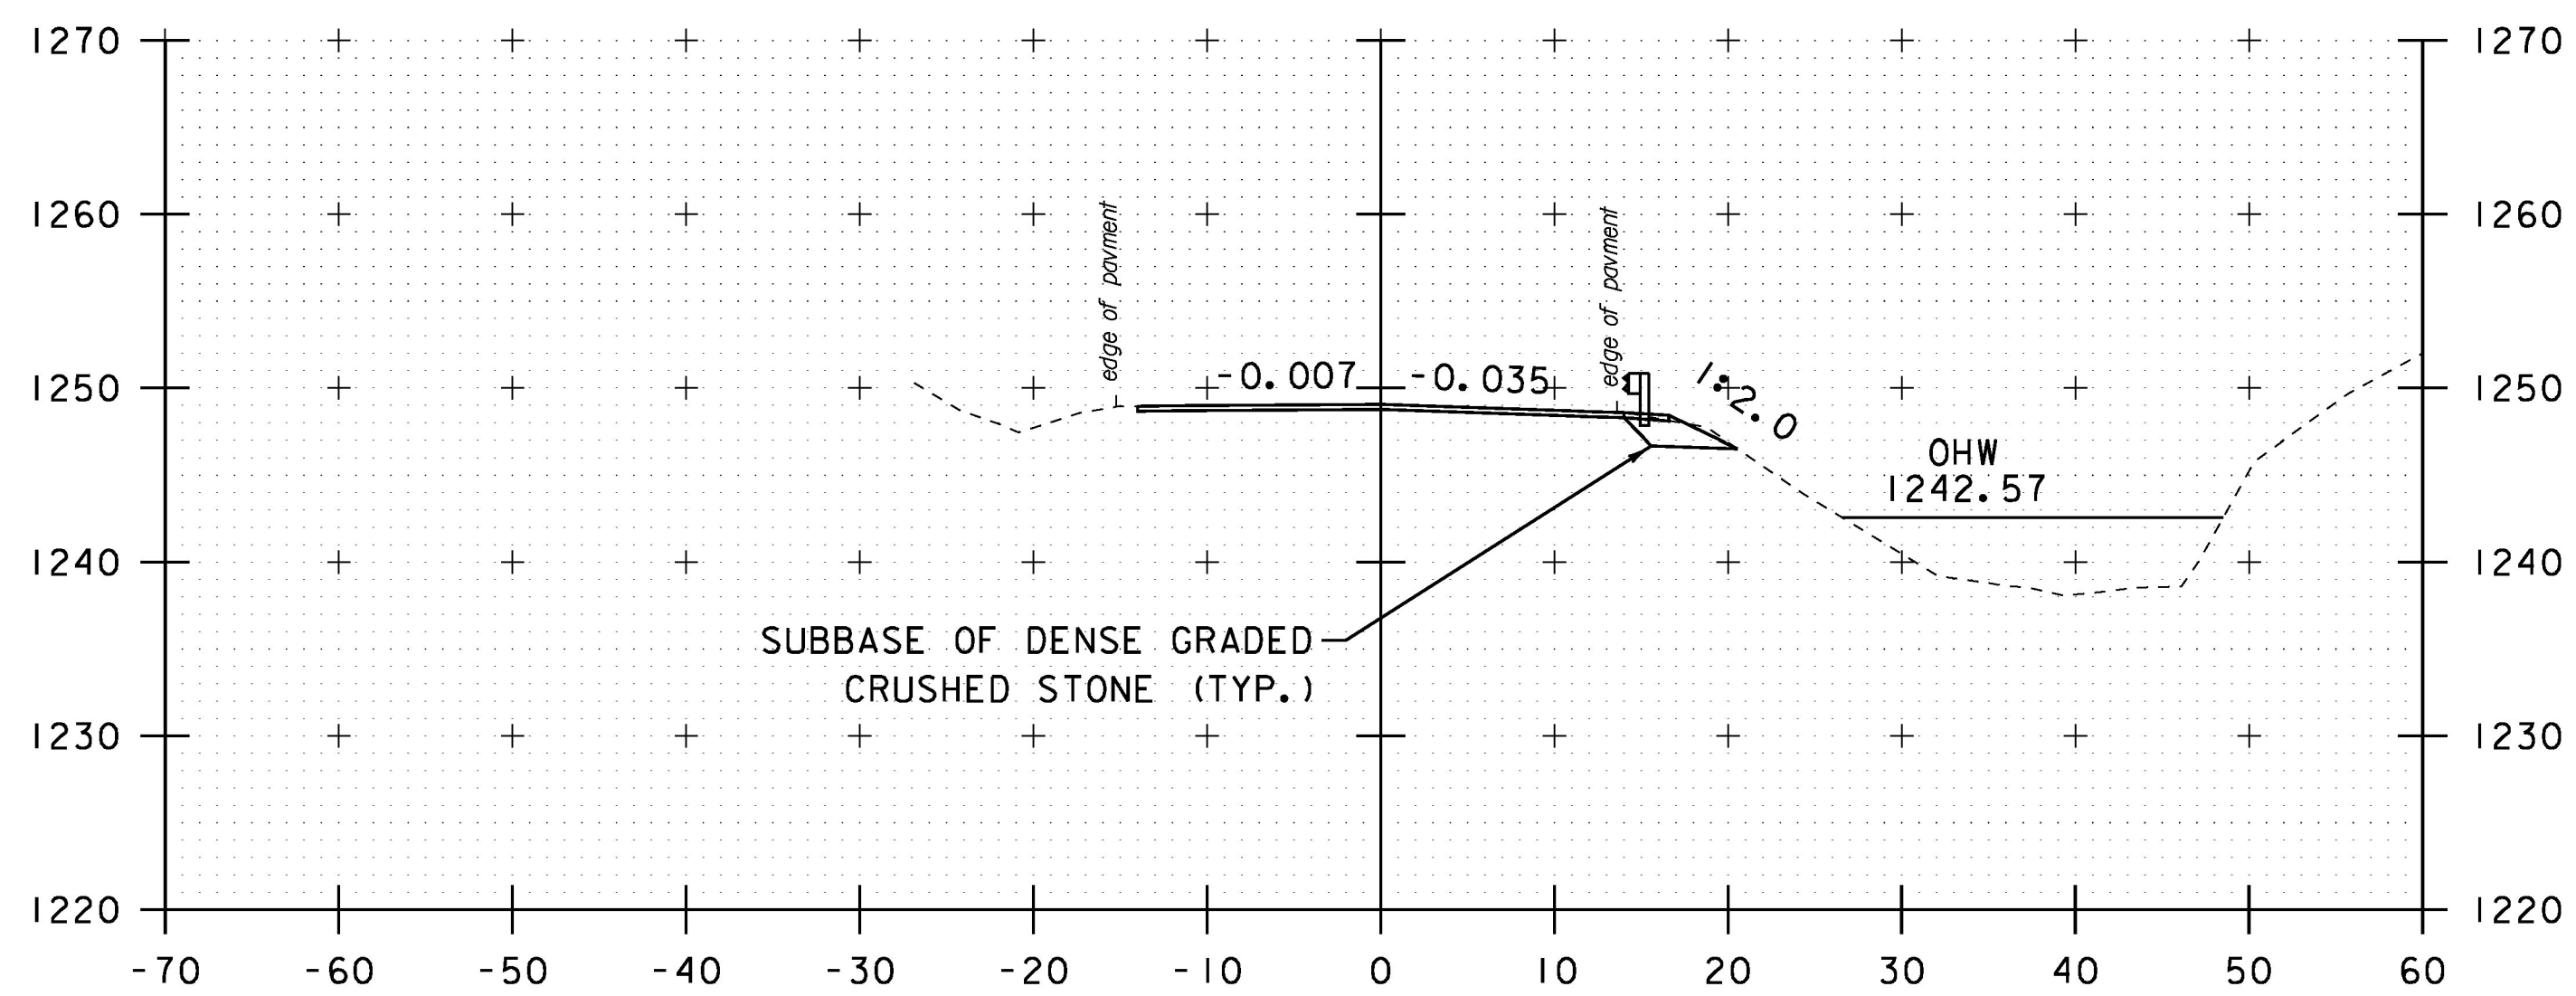

65+00

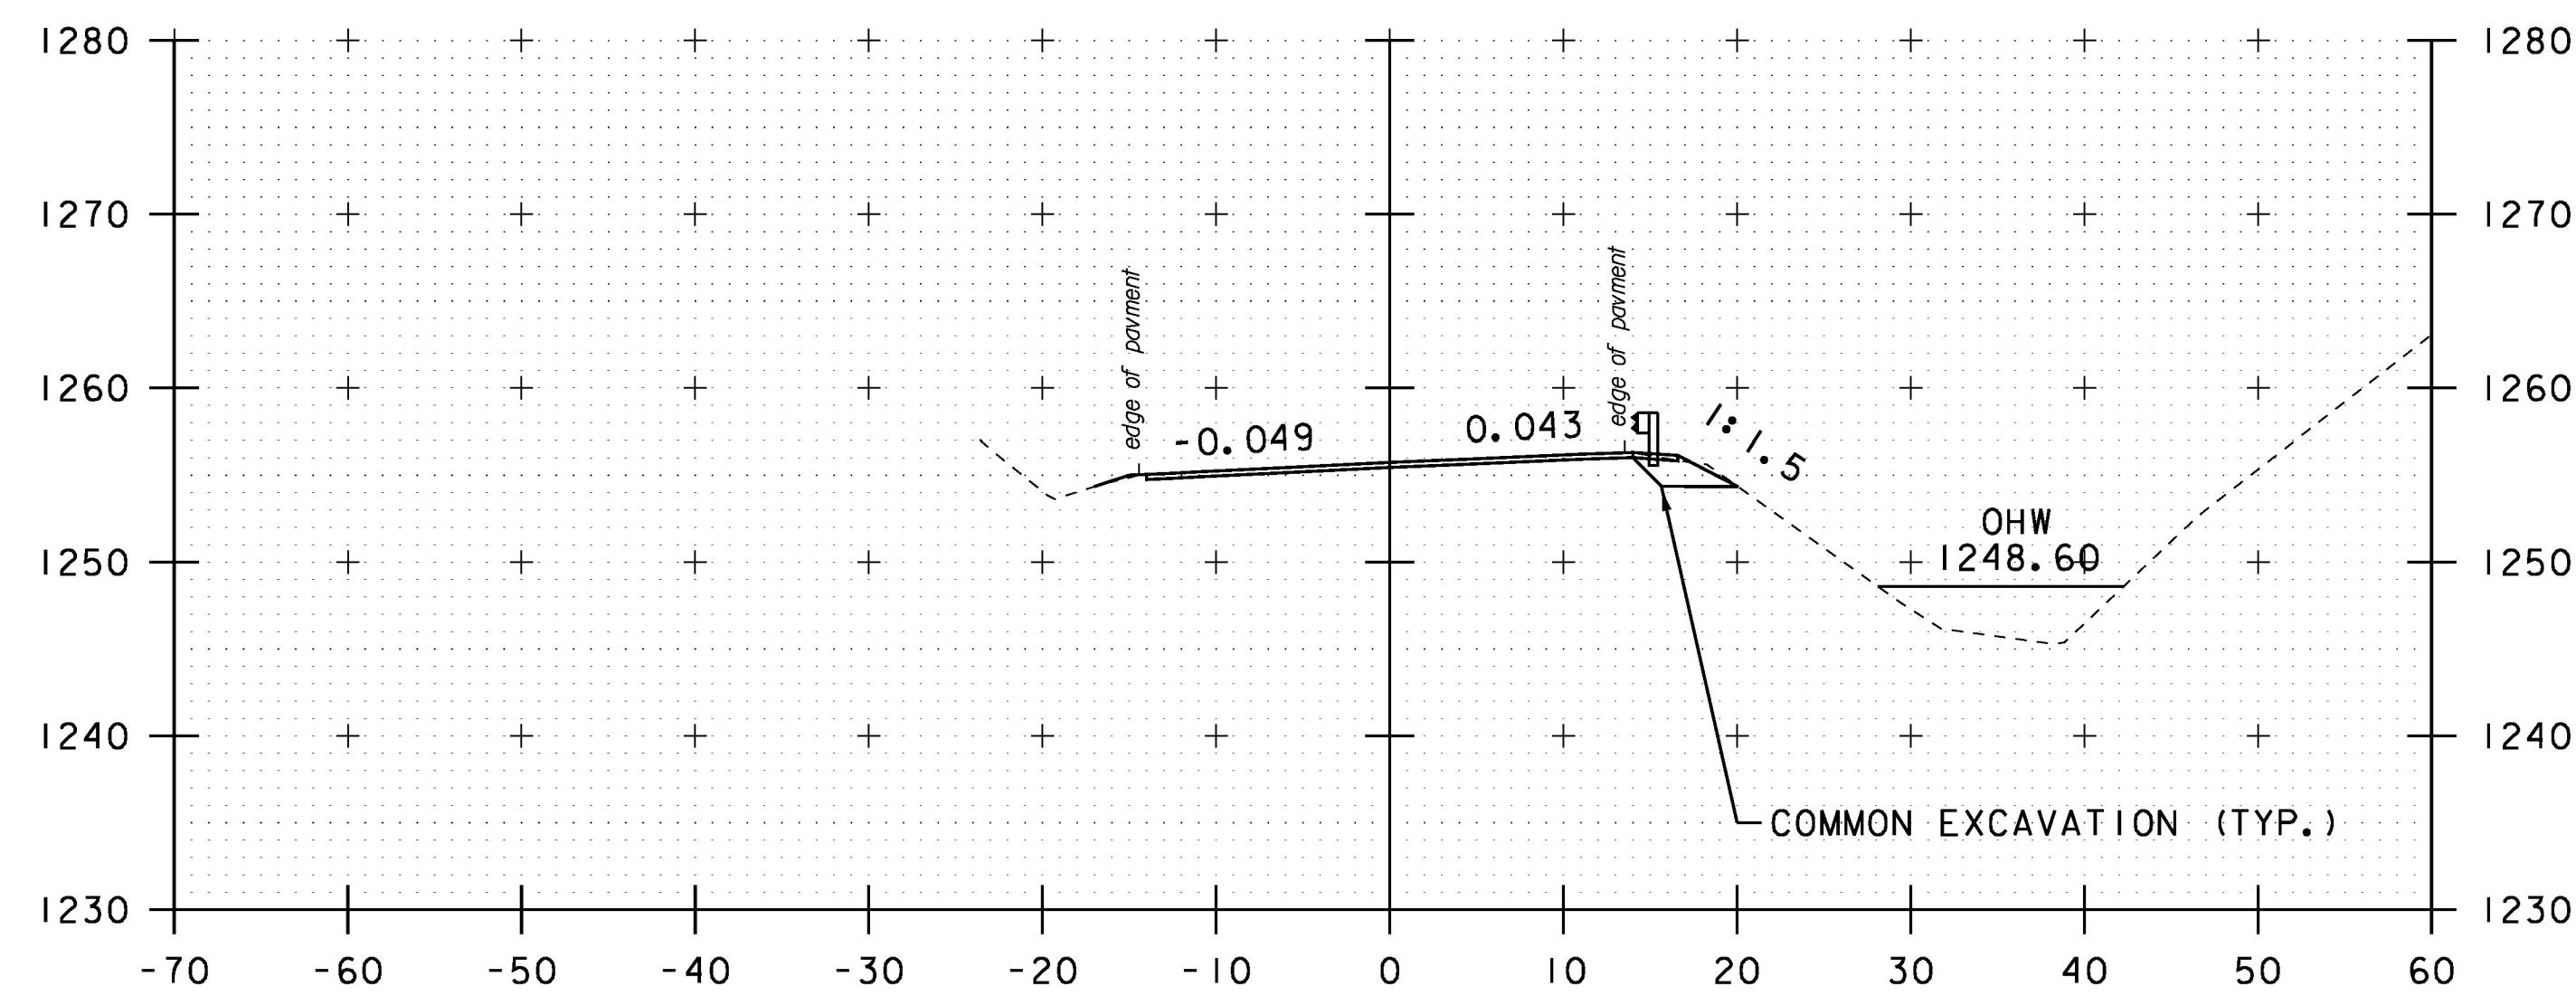

66+00

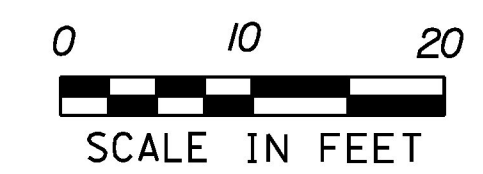

STA. 65+00 TO STA. 66+50	
PROJECT NAME:	GRANVILLE
PROJECT NUMBER:	ER STP 013-4 (40)
FILE NAME:	z12b520xs.dgn
PROJECT LEADER:	J. TUCKER
DESIGNED BY:	B. BRESLEND
VT 100 CROSS SECTION SHEET 32	
PLOT DATE:	7/8/2015
DRAWN BY:	B. BRESLEND
CHECKED BY:	A. SANZ
SHEET	119 OF 141