




67+50

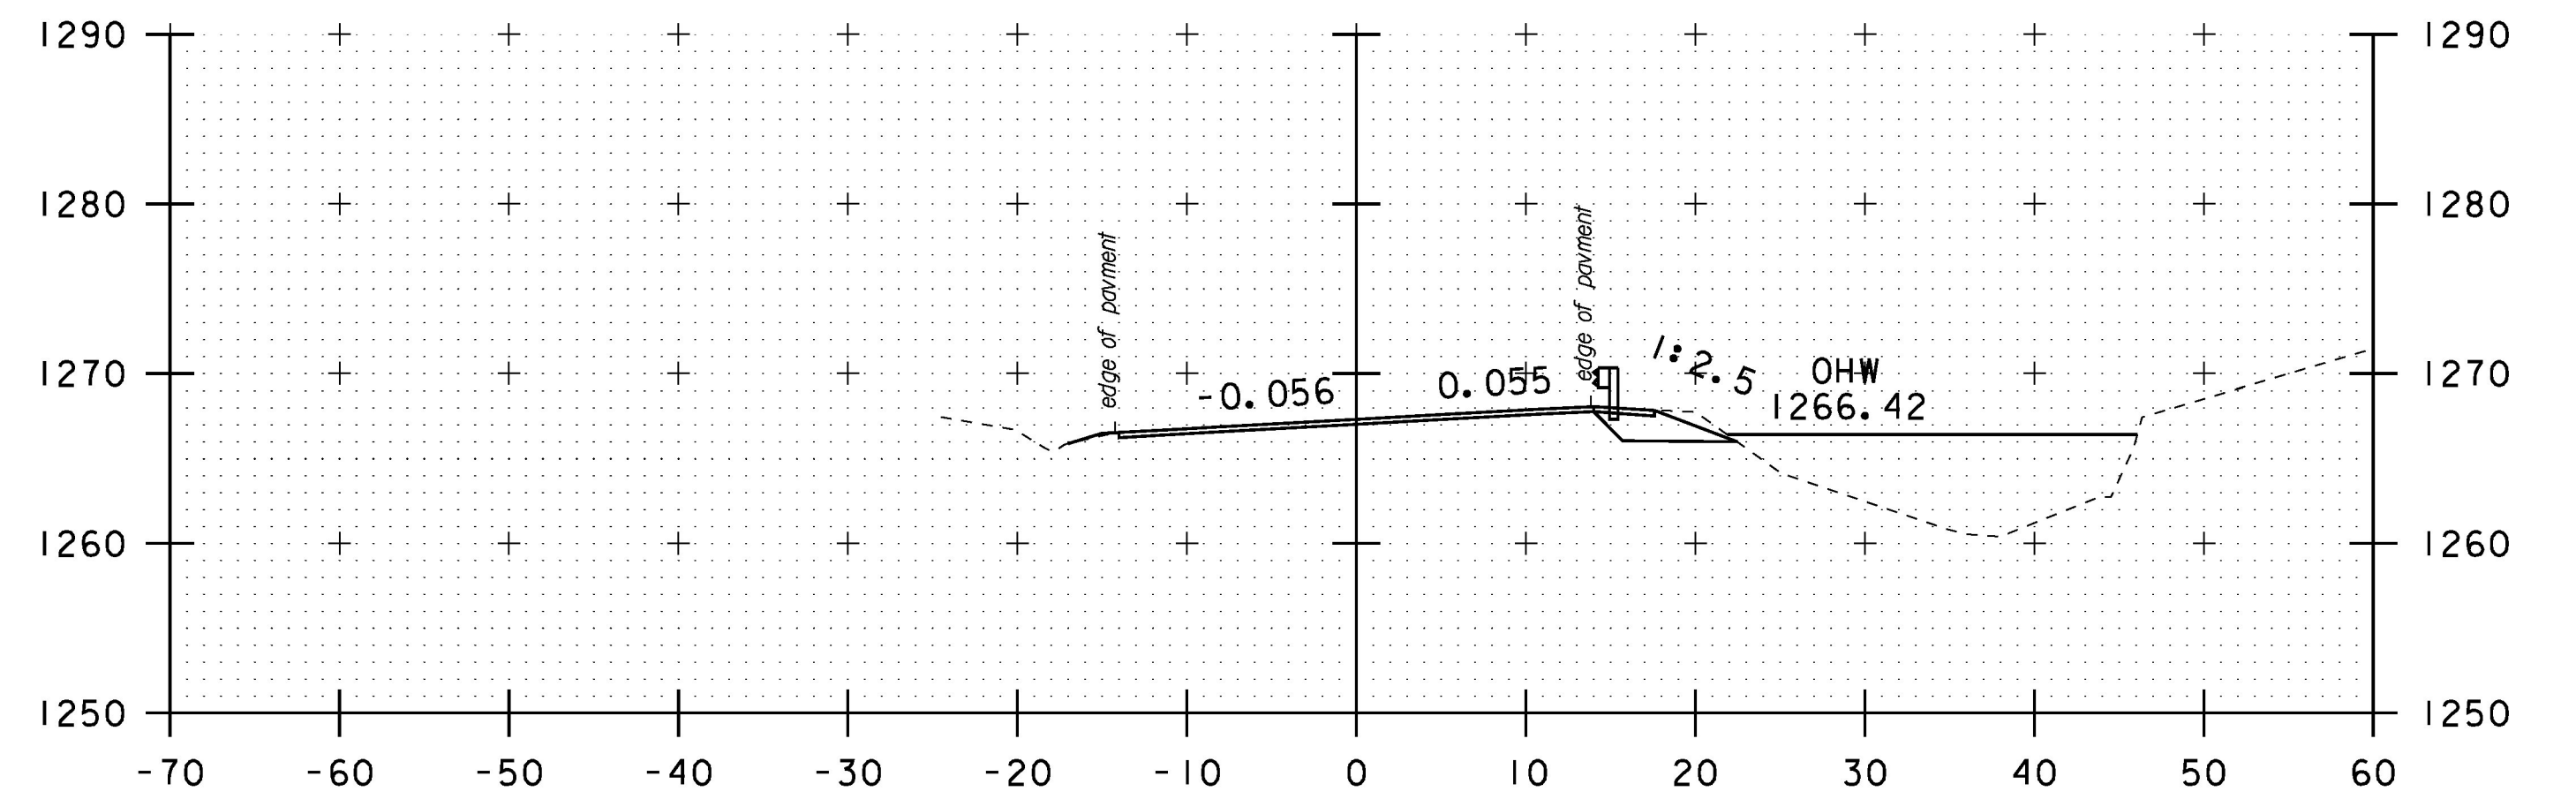


68+50

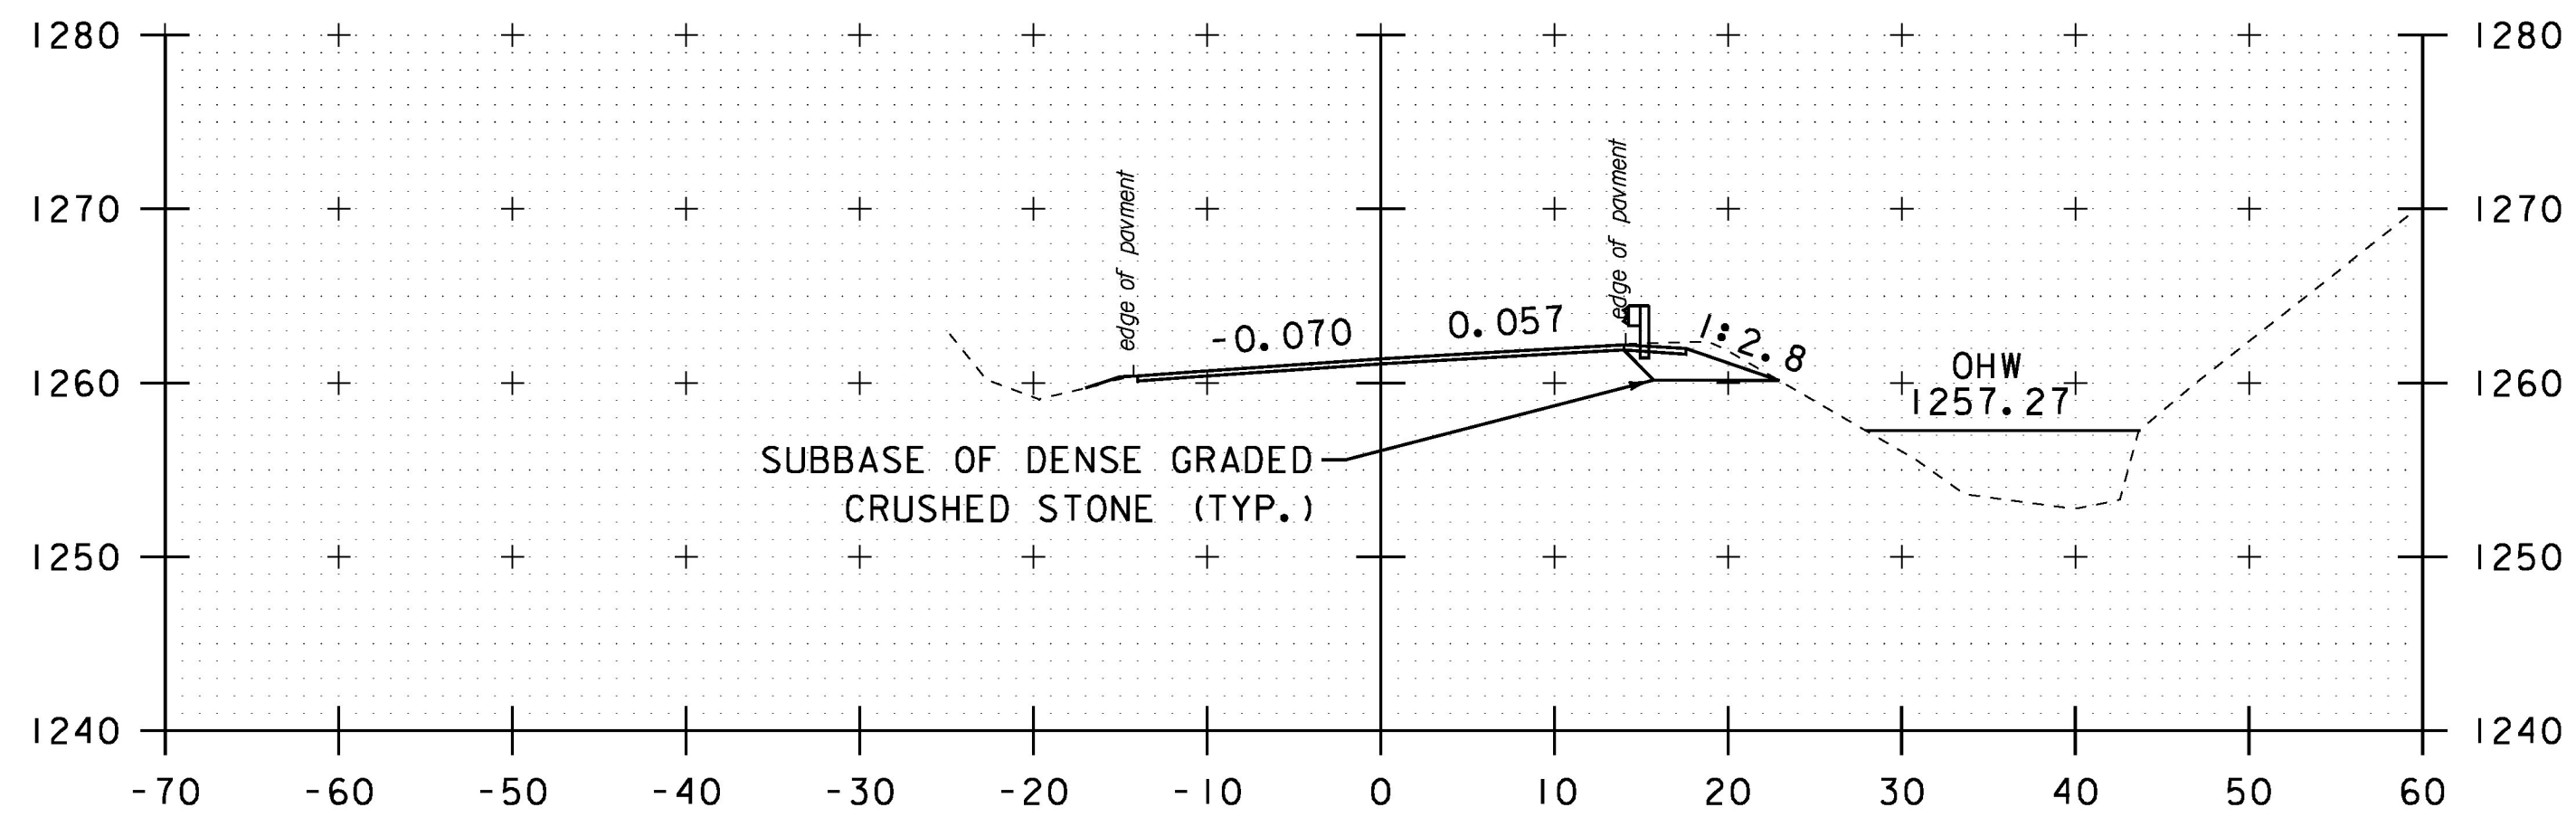

67+00

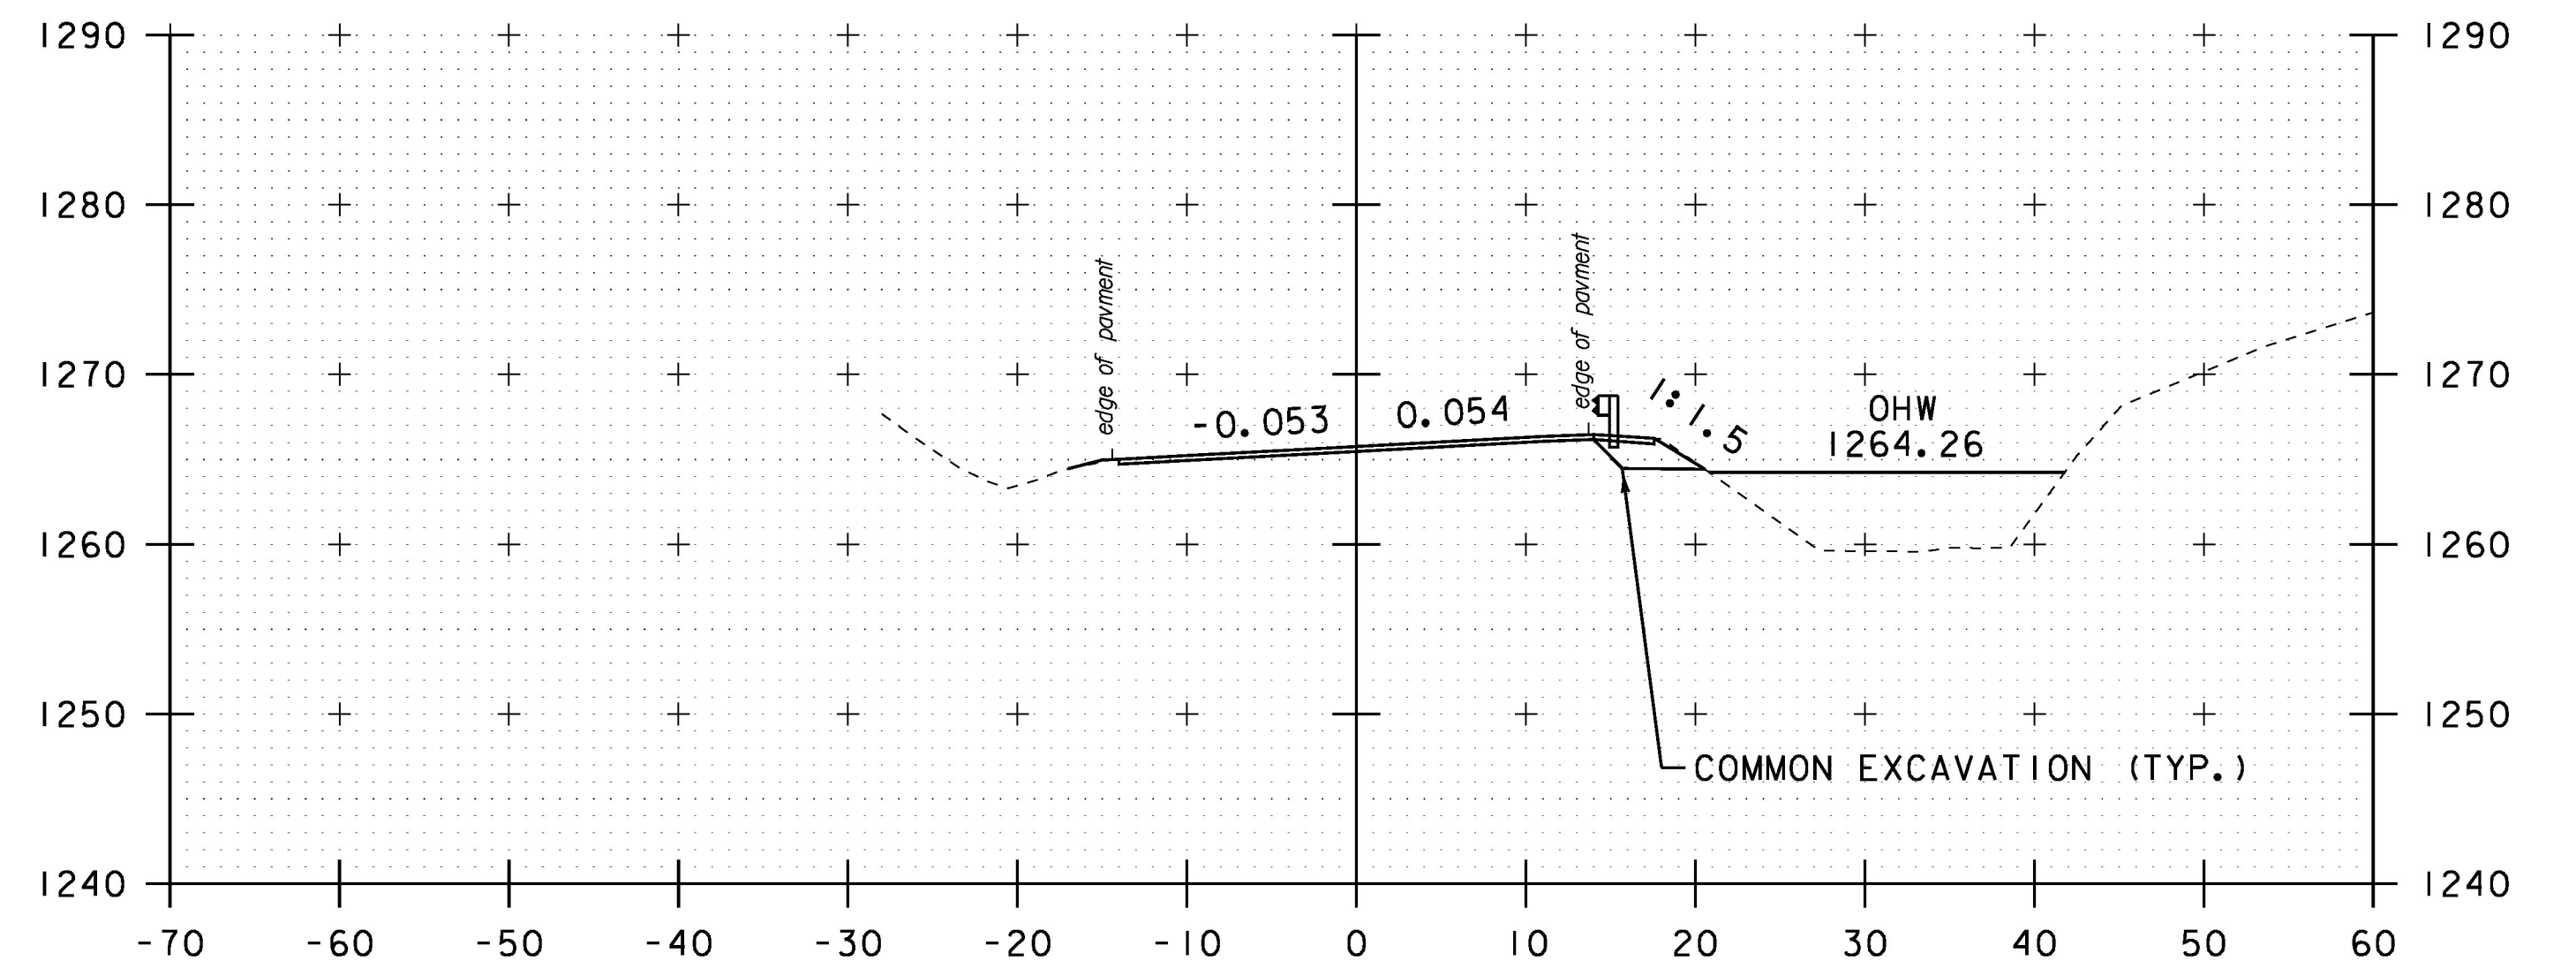

68+00

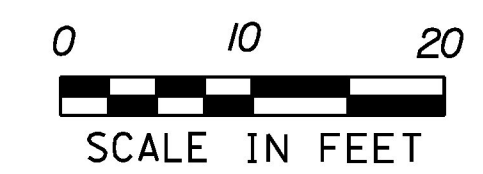

STA. 67+00 TO STA. 68+50

PROJECT NAME: GRANVILLE
PROJECT NUMBER: ER STP 013-4 (40)

FILE NAME: z12b520xs.dgn PLOT DATE: 7/8/2015
PROJECT LEADER: J. TUCKER DRAWN BY: B. BRESLEND
DESIGNED BY: B. BRESLEND CHECKED BY: A. SANZ
VT 100 CROSS SECTION SHEET 33 SHEET 120 OF 141