


STA. 70+75.00  
END PROJECT



STA. 69+00 TO STA. 71+00

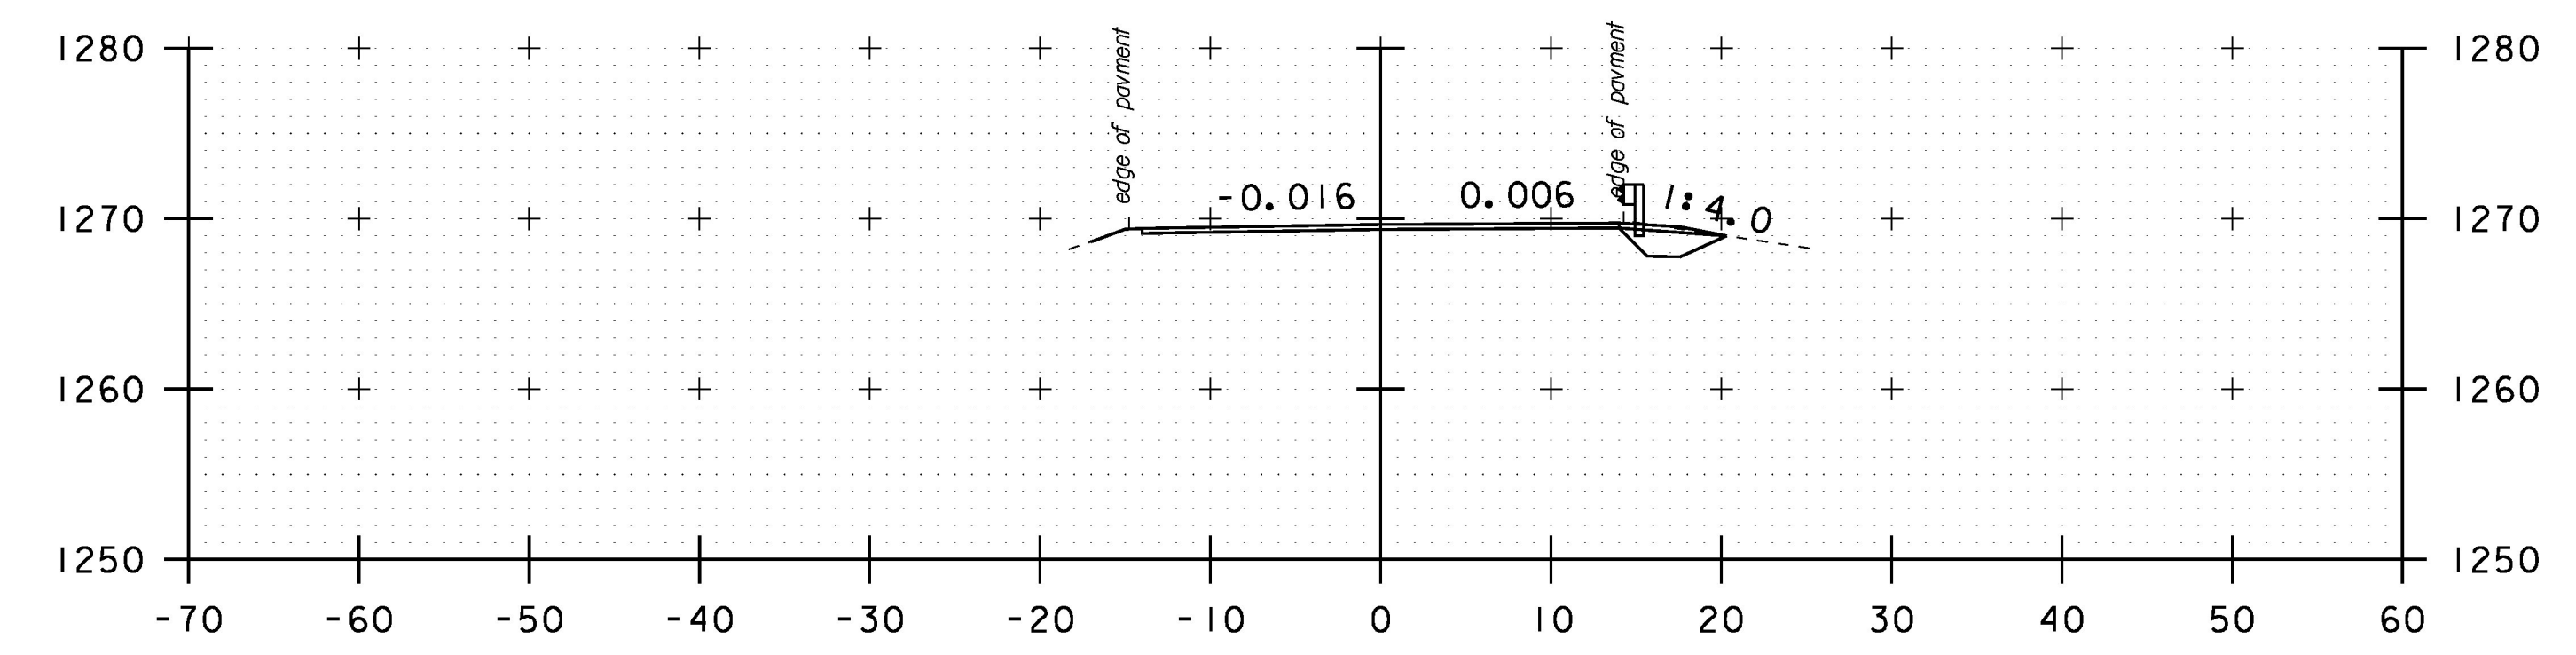

PROJECT NAME: GRANVILLE	
PROJECT NUMBER: ER STP 013-4 (40)	
FILE NAME: z12b520xs.dgn	PLOT DATE: 7/8/2015
PROJECT LEADER: J. TUCKER	DRAWN BY: B. BRESLEND
DESIGNED BY: B. BRESLEND	CHECKED BY: A. SANZ
VT 100 CROSS SECTION SHEET 34	SHEET 121 OF 141