


LAYOUT SHEET 8 : AREA OF IMPACT BELOW OHW - 5 SQ. FT.  
 PROJECT TOTAL : AREA OF IMPACT BELOW OHW - 2351 SQ. FT.

PROJECT TOTAL : VOLUME BELOW OHW - 466 CY

LAYOUT SHEET 8 : AREA OF RESTORATION - 4120 SQ. FT.  
 PROJECT TOTAL : AREA OF RESTORATION - 21238 SQ. FT.

△——△——△ : BOTTOM OF CUT

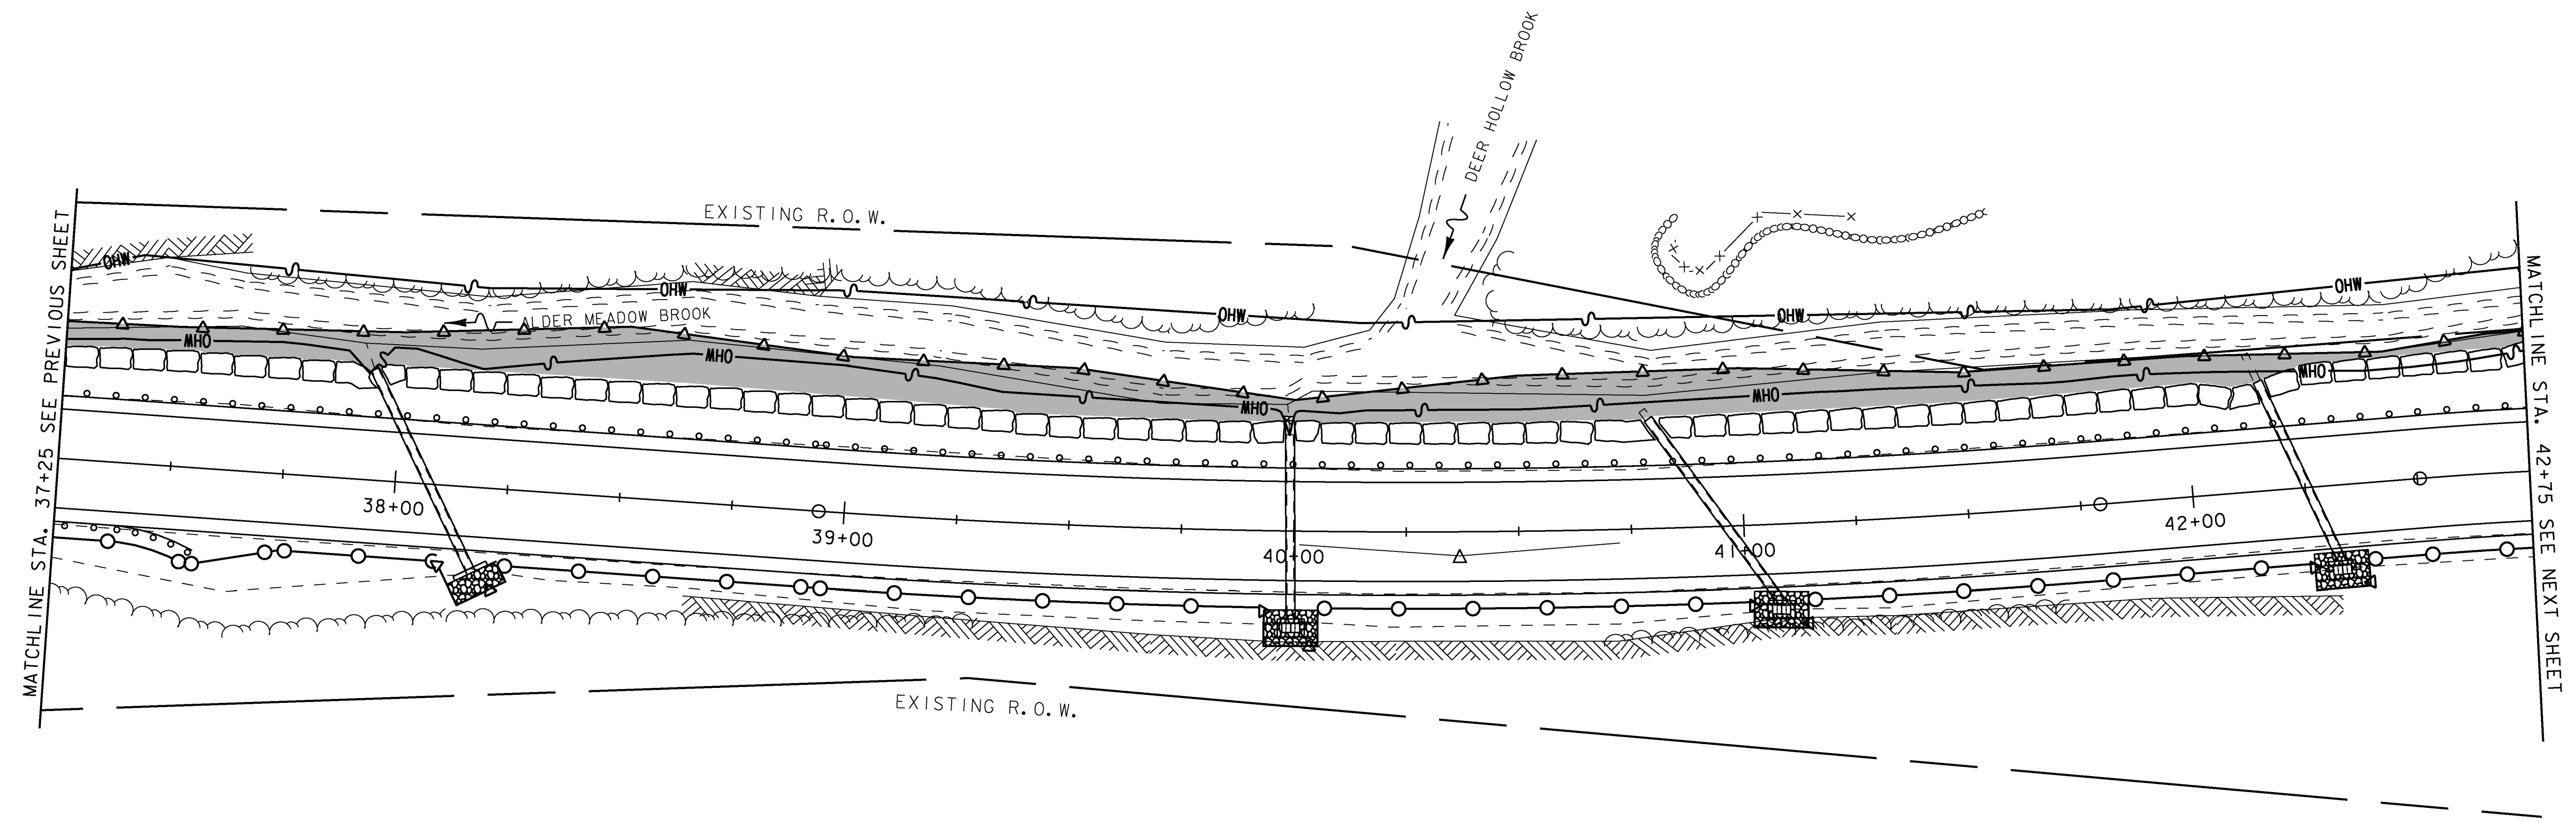

LEGEND

	: AREA OF RESTORATION
	: AREA OF IMPACT BELOW OHW



PROJECT NAME: GRANVILLE	PLOT DATE: 7/8/2015
PROJECT NUMBER: ER STP 013-4 (40)	DRAWN BY: B. BRESLEND
FILENAME: z12b5200HW_bdr.dgn	CHECKED BY: J. TUCKER
DESIGNED BY: B. BRESLEND	SHEET 136 OF 141
OHW LOCATION SHEET 8	