


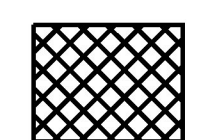
LAYOUT SHEET 9 : AREA OF IMPACT BELOW OHW - 0 SQ. FT.
 PROJECT TOTAL : AREA OF IMPACT BELOW OHW - 2351 SQ. FT.

PROJECT TOTAL : VOLUME BELOW OHW - 466 CY

LAYOUT SHEET 9 : AREA OF RESTORATION - 20 SQ. FT.
 PROJECT TOTAL : AREA OF RESTORATION - 21238 SQ. FT.

△—△—△ : BOTTOM OF CUT

LEGEND

	: AREA OF RESTORATION
	: AREA OF IMPACT BELOW OHW

CURVE (6)
 DELTA = 33°59'07"
 D = 7°09'43" (1) D = 9°10'02" (2) D = 5°43'47" (3)
 R = 800.00' (1) R = 625.00' (2) R = 999.98 (3)
 T = 225.33' (1) T = 257.48' (2)
 L = 104.88' (1) L = 164.26' (2) L = 200.13' (3)
 E = 31.13'



PROJECT NAME: GRANVILLE	PLOT DATE: 7/8/2015
PROJECT NUMBER: ER STP 013-4 (40)	DRAWN BY: B. BRESLEND
FILENAME: z12b5200HW_bdr.dgn	CHECKED BY: J. TUCKER
PROJECT LEADER: J. TUCKER	SHEET 137 OF 141
DESIGNED BY: B. BRESLEND	
OHW LOCATION SHEET 9	