







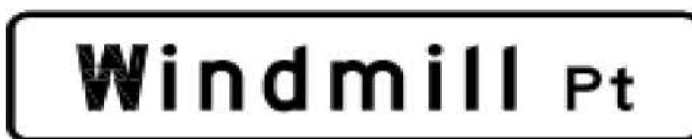




DIRECTION	MILEPOINT	LOCATION CODE (SHEET 2)	SIGN CODE	WIDTH (IN)	HEIGHT (IN)	SHEETING REMARKS	SIGN LEGEND	NEW SIGNS		EXISTING SIGNS				EXIST POST		NUMBER OF NEW POSTS	SQUARE STEEL (IN)			TUBULAR STEEL Ø (IN)				SIGN FRAME REQUIRED	REMARKS	SIGN DETAIL LOCATION			
								"A"	"B"	RETAIN	SALVAGE FROM	SALVAGE TO	REMOVE	RETAIN	REMOVE		1.75	2.00	2.50	FOUNDATION	3.00	3.50	4.00			5.00	SHSM	PROJECT SHEET #	STANDARD SHEET #
																	(LB / FT)				(LB / FT)								
ALBURGH US-2 EB							FY-FLUORESCENT YELLOW FYG-FLUORESCENT YELLOW GREEN															"SHSM"-STANDARD HIGHWAY SIGNS AND MARKINGS							
EB	1.869	A	W1-8L	18	24		 11/8/14	3.00							1	X 15.75								INSTALL 95 FT EAST OF LEFT LARGE ARROW	X				
		B	W1-8R	18	24			3.00																	X				
EB	1.900	A	W1-8L	18	24		 11/8/14	3.00							1	X 15.25								INSTALL 164 FT EAST OF PREVIOUS CHEVRON	X				
		B	W1-8R	18	24			3.00																	X				
EB	1.930	A	W1-8L	18	24		 11/8/14	3.00							1	X 14.50								INSTALL 158 FT EAST OF PREVIOUS CHEVRON	X				
		B	W1-8R	18	24			3.00																	X				
EB	1.960	A	W1-8L	18	24		 11/8/14	3.00							1	X 14.25								INSTALL 158 FT EAST OF PREVIOUS CHEVRON	X				
		B	W1-8R	18	24			3.00																	X				
EB	1.974	A	D3-1	UNK.	UNK.							1		X															
		A/B	D3-1	42	12		 11/8/14	3.50							1	X								WINDMILL POINT RD (TH-20); FIELD LOCATE FOR VISIBILITY FROM ROUTE 2		12			
EB	1.974	C	VR-017	24	30							1		X															
		C	VR-017	24	30		 11/8/14	5.00																WINDMILL POINT RD (TH-20)		10			
EB	1.981	D	R1-1	30	30							1		X															
		D	R1-1	30	30		 11/8/14	6.25																WINDMILL POINT RD (TH-20)	X				
EB	1.991	C	VR-017	24	30							1		X															
SIGN SUMMARY SHEET							SHEET TOTALS	38.75	0.00	0	0	0	4	0	0	5	103.50 75.0	0	0.0	0.0	0.0	0.0	PROJECT NAME: ALBURGH-COLCHESTER PROJECT NUMBER: STPG SIGN(45)						
VERMONT AGENCY OF TRANSPORTATION							TOWN DIRECTIONAL TOTALS	897.8	0.0	37	1	1	165	0	0	92	1380.0	0		0.0		FILE NAME: 1 Alburgh US2 EB TSS.xls PROJECT MANAGER: D. BRYANT DESIGNED BY: B. TOOTHAKER ALBURGH EB SHEET 3	PLOT DATE: 4/15/2014 DRAWN BY: J. BLANCHARD CHECKED: K. KERN SHEET 17 OF 167						