




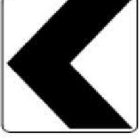





DIRECTION	MILEPOINT	LOCATION CODE (SHEET 2)	SIGN CODE	WIDTH (IN)	HEIGHT (IN)	SHEETING REMARKS	SIGN LEGEND	NEW SIGNS		EXISTING SIGNS				EXIST POST		NUMBER OF NEW POSTS	SQUARE STEEL (IN)			TUBULAR STEEL Ø (IN)				SIGN FRAME REQUIRED	REMARKS	SIGN DETAIL LOCATION		
								"A"	"B"	RETAIN	SALVAGE FROM	SALVAGE TO	REMOVE	RETAIN	REMOVE		1.75	2.00	2.50	3.00	3.50	4.00	5.00			SHSM	PROJECT SHEET #	STANDARD SHEET #
																	(LB / FT)			(LB / FT)								
<b>ALBURGH US-2 EB</b>							FY-FLUORESCENT YELLOW FYG-FLUORESCENT YELLOW GREEN															"SHSM"-STANDARD HIGHWAY SIGNS AND MARKINGS						
		C	VR-017	24	30		 11/8/14	5.00															WINDMILL POINT RD (TH-20)		10			
EB	1.995	A	W1-8L	18	24		 11/8/14	3.00						1		X	13.25						INSTALL 10 FT CLOSER TO ROAD THAN STREET SIGN	X				
		B	W1-8R	18	24		 11/8/14	3.00																	X			
EB	1.995	A	D3-1	UNK.	UNK..		11/8/14									X	12.00											
		A/B	D3-1	42	12		 11/8/14	3.50						1		X							WINDMILL POINT RD (TH-20); FIELD LOCATE FOR VISIBILITY FROM ROUTE 2		12			
EB	2.004	D	R1-1	30	30												X	14.00										
		D	R1-1	30	30		 11/8/14	6.25															WINDMILL POINT RD (TH-20)	X				
EB	2.016	B	W1-6	48	24		RIGHT ==> LARGE ARROW 11/8/14									X												
EB	2.031	A	W1-8L	18	24		 11/8/14	3.00						1		X	14.25						INSTALL 80 FT EAST OF RIGHT LARGE ARROW	X				
		B	W1-8R	18	24		 11/8/14	3.00																	X			
EB	2.499	A	VD-123	UNK.	12		511 TRAVEL INFO PHONE SYMBOL									X												
		A	D12-5	48	60		 11/8/14	20.00						2			13.25	X					SLIP BASES	X				
EB	2.741	A	W1-2R	30	30		RIGHT CURVE 11/8/14									X												
EB	2.803	A	W1-10R	36	36		 11/8/14	9.00						2			16.00	X					INSTALL 200 FT WEST OF BEGINNING OF CURVE (250 FT WEST OF SHARE THE ROAD ASSEMBLY)	X				
EB	2.850	A	W16-1	18	24		11/8/14									X												
<b>SIGN SUMMARY SHEET</b>							<b>SHEET TOTALS</b>	55.75	0.00	0	0	0	6	0	0	7	112.75	0	0.0	0.0	0.0	0.0	PROJECT NAME: <b>ALBURGH-COLCHESTER</b>					
								SF	SF	EA	EA	EA	EA	EA	EA	EA	FT	EA	LB	LB	LB	LB	PROJECT NUMBER: <b>STPG SIGN(45)</b>					
VERMONT AGENCY OF TRANSPORTATION							<b>TOWN DIRECTIONAL TOTALS</b>	897.8	0.0	37	1	1	165	0	0	92	1380.0	0		0.0				FILE NAME: <b>1 Alburgh US2 EB TSS.xls</b> PLOT DATE: <b>4/15/2014</b>				
																							DRAWN BY: <b>J. BLANCHARD</b>					
																							DESIGNED BY: <b>B. TOOTHAKER</b> CHECKED: <b>K. KERN</b>					
																							ALBURGH EB SHEET 4 SHEET <b>18</b> OF <b>167</b>					