


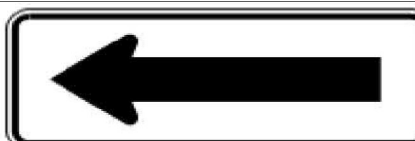



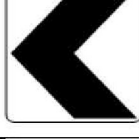




DIRECTION	MILEPOINT	LOCATION CODE (SHEET 2)	SIGN CODE	WIDTH (IN)	HEIGHT (IN)	SHEETING REMARKS	SIGN LEGEND	NEW SIGNS		EXISTING SIGNS				EXIST POST		NUMBER OF NEW POSTS	SQUARE STEEL (IN)			TUBULAR STEEL Ø (IN)				SIGN FRAME REQUIRED	REMARKS	SIGN DETAIL LOCATION			
								"A"	"B"	RETAIN	SALVAGE FROM	SALVAGE TO	REMOVE	RETAIN	REMOVE		1.75	2.00	2.50	FOUNDATION	3.00	3.50	4.00			5.00	SHSM	PROJECT SHEET #	STANDARD SHEET #
																	(LB / FT)				(LB / FT)								
ALBURGH US-2 EB							FY-FLUORESCENT YELLOW FYG-FLUORESCENT YELLOW GREEN															"SHSM"-STANDARD HIGHWAY SIGNS AND MARKINGS							
		C	R2-1	24	30		SPEED LIMIT 35			1														SUMMIT RD (TH-35)					
		C	VR-017	24	30			5.00						1		15.25								SUMMIT RD (TH-35) - REPOSITION IN FRONT OF UTILITY POLE		10			
EB	9.805	D	R1-1	30	30		11/24/14					1	X																
		A/B	D3-1	UNK.	UNK..		SUMMIT RD					1																	
		D	R1-1	30	30			6.25																SUMMIT RD (TH-35)	X				
EB	9.805	A/B	D3-1	42	12			3.50						1		12.50 X								SUMMIT RD (TH-35); FIELD LOCATE FOR VISIBILITY FROM ROUTE 2		12			
EB	9.806	A	W1-6	48	24							1	X																
		A	W1-6L	48	24			8.00								16.00													
EB	9.980	A	W1-2L	30	30							1	X																
		A	W1-2L	30	30			6.25																					
EB	10.005	A	W1-8L	18	24			3.00						1		16.00 X								INSTALL 132 FT EAST OF LEFT CURVE WARNING	X				
		B	W1-8R	18	24			3.00																					
EB	10.034	A	W1-8L	18	24			3.00						1		15.25 X								INSTALL 153 FT EAST OF PREVIOUS CHEVRON	X				
		B	W1-8R	18	24			3.00																					
EB	10.065	A	W1-8L	18	24			3.00						1		15.25 X								INSTALL 164 FT EAST OF PREVIOUS CHEVRON	X				
SIGN SUMMARY SHEET							SHEET TOTALS	44.00	0.00	1	0	0	4	0	0	4	90.25 60.0	0	0.0	0.0	0.0	0.0	PROJECT NAME: ALBURGH-COLCHESTER	PROJECT NUMBER: STPG SIGN(45)					
VERMONT AGENCY OF TRANSPORTATION							TOWN DIRECTIONAL TOTALS	897.8	0.0	37	1	1	165	0	0	92	1380.0	0		0.0		FILE NAME: 1 Alburgh US2 EB TSS.xls	PLOT DATE: 4/15/2014	DRAWN BY: J. BLANCHARD					
																					DESIGNED BY: B. TOOTHAKER	CHECKED: K. KERN	SHEET 37 OF 167						