
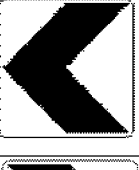
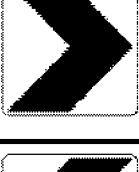
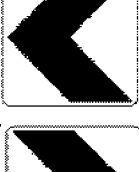

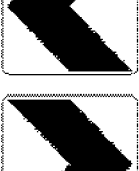
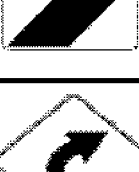
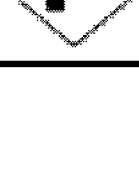




DIRECTION	MILEPOINT	LOCATION CODE (SHEET 2)	SIGN CODE	WIDTH (IN)	HEIGHT (IN)	SHEETING REMARKS	SIGN LEGEND	NEW SIGNS		EXISTING SIGNS				EXIST POST		NUMBER OF NEW POSTS	SQUARE STEEL (IN)			TUBULAR STEEL Ø (IN)				SIGN FRAME REQUIRED	REMARKS	SIGN DETAIL LOCATION				
								"A"	"B"	RETAIN	SALVAGE FROM	SALVAGE TO	REMOVE	RETAIN	REMOVE		1.75	2.00	2.50	FOUNDATION	3.00	3.50	4.00			5.00	SHSM	PROJECT SHEET #	STANDARD SHEET #	
																	(LB / FT)				(LB / FT)									
ALBURGH US-2 EB							FY-FLUORESCENT YELLOW FYG-FLUORESCENT YELLOW GREEN																"SHSM"-STANDARD HIGHWAY SIGNS AND MARKINGS							
		B	W1-8R	18	24			3.00																	X					
EB	10.095	A	W1-8L	18	24			3.00						1	14.75 X										X		INSTALL 158 FT EAST OF PREVIOUS CHEVRON			
		B	W1-8R	18	24			3.00																	X					
EB	10.125	A	W1-8L	18	24			3.00						1	12.75 X										X		INSTALL 158 FT EAST OF PREVIOUS CHEVRON			
		B	W1-8R	18	24			3.00																	X					
EB	10.155	A	W1-8L	18	24			3.00						1	13.75 X										X		INSTALL 158 FT EAST OF PREVIOUS CHEVRON			
		B	W1-8R	18	24			3.00																	X					
EB	10.340	A	W1-2R	30	30			6.25						1	14.25 X										X		INSTALL 227 FT WEST OF BUSINESS SIGNS			
EB	10.383	A	VD-062BRN	72	16		BUSINESS SIGN			1																				
		A	VD-062AL	72	16		BUSINESS SIGN			1																				
EB	11.095	A	W3-5	48	48		SPEED REDUCTION SPEED LIMIT 40 11/25/14						1																	
EB	11.160	A	W3-5	36	36			9.00						2	16.75 X 15.50									X		INSTALL 500 FT WEST OF SPEED LIMIT SIGN (105 FT WEST OF EXISTING VILLAGE SIGN)				
EB	11.180	A	VD-018	30	18		SOUTH ALBURGH NORTH HERO 7						1																	
EB	11.208	A	VD-018	30	18			3.75						1	13.25 X												INSTALL 250 FT WEST OF SPEED LIMIT SIGN	6		
EB	11.255	A	R2-1	36	48								1																	
SIGN SUMMARY SHEET							SHEET TOTALS	40.00	0.00	2	0	0	3	0	0	7	101.00 106.0	0	0.0	0.0	0.0	0.0		PROJECT NAME: ALBURGH-COLCHESTER						
								SF	SF	EA	EA	EA	EA	EA	EA	EA	FT	EA	LB	LB	LB	LB	PROJECT NUMBER: STPG SIGN(45)							
VERMONT AGENCY OF TRANSPORTATION							TOWN DIRECTIONAL TOTALS	897.8	0.0	37	1	1	165	0	0	92	1380.0	0			0.0		FILE NAME: 1 Alburgh US2 EB TSS.xls	PLOT DATE: 4/15/2014						
																					PROJECT MANAGER: D. BRYANT	DRAWN BY: J. BLANCHARD								
																					DESIGNED BY: B. TOOTHAKER	CHECKED: K. KERN								
																					ALBURGH EB SHEET 24	SHEET 38	OF	167						