




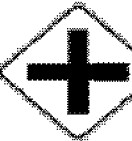



DIRECTION	MILEPOINT	LOCATION CODE (SHEET 2)	SIGN CODE	WIDTH (IN)	HEIGHT (IN)	SHEETING REMARKS	SIGN LEGEND	NEW SIGNS		EXISTING SIGNS				EXIST POST		NUMBER OF NEW POSTS	SQUARE STEEL (IN)			TUBULAR STEEL Ø (IN)				SIGN FRAME REQUIRED	REMARKS	SIGN DETAIL LOCATION		
								"A"	"B"	RETAIN	SALVAGE FROM	SALVAGE TO	REMOVE	RETAIN	REMOVE		1.75	2.00	2.50	3.00	3.50	4.00	5.00			SHSM	PROJECT SHEET #	STANDARD SHEET #
																	(LB / FT)			(LB / FT)								
ALBURGH US-2 WB							FY-FLUORESCENT YELLOW FYG-FLUORESCENT YELLOW GREEN															"SHSM"-STANDARD HIGHWAY SIGNS AND MARKINGS						
		H	R1-1	30	30		 11/21/14	6.25																				
WB	6.729	F	D3-1	60	12		 11/20/14	5.00						2		12.50	X								12			
WB	6.684	F	R2-1	24	30																							
		F	R2-1	24	30		 11/20/14	5.00									12.50								X			
WB	6.553	F	R2-1	24	30																							
		F	R2-1	24	30		 11/20/14	5.00									14.00								X			
WB	6.491	F	VD-062AS	72	16		BUSINESS SIGN			1																		
WB	6.439	F	R4-1	24	30																							
		E	W14-3	48	36		NO PASSING ZONE PENNANT																					
		F	R4-1	24	30		 11/20/14	5.00						1			X								X			
WB	6.412	F	W2-1	48	48																							
		F	W16-2	24	12																							
		F	W2-1	30	30		 11/20/14	6.25									14.00								X			
		F	W16-2P	24	18		 11/21/14	3.00																	X			
WB	6.373	F	M2-1	21	15		ROUTE MARKER ASSEMBLY 11/20/14																					
SIGN SUMMARY SHEET							SHEET TOTALS		35.50	0.00	1	0	0	7	0	0	3	67.25	0	0.0	0.0	0.0	0.0	PROJECT NAME: ALBURGH-COLCHESTER				
							SF	SF	EA	EA	EA	EA	EA	EA	EA	EA	EA	FT	EA	LB	LB	LB	LB	PROJECT NUMBER: STPG SIGN(45)				
VERMONT AGENCY OF TRANSPORTATION							TOWN DIRECTIONAL TOTALS		870.8	0.0	23	3	2	157	0	0	80	1200.0	0		0.0			FILE NAME: 2 Alburgh US2 WB TSS.xls				
																							PLOT DATE: 4/15/2014					
																							DRAWN BY: J. BLANCHARD					
																							DESIGNED BY: B. TOOTHAKER					
																							CHECKED: K. KERN					
																							SHEET 47 OF 167					