


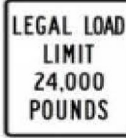



DIRECTION	MILEPOINT	LOCATION CODE (SHEET 2)	SIGN CODE	WIDTH (IN)	HEIGHT (IN)	SHEETING REMARKS	SIGN LEGEND	NEW SIGNS		EXISTING SIGNS				EXIST POST		NUMBER OF NEW POSTS	SQUARE STEEL (IN)			TUBULAR STEEL Ø (IN)				SIGN FRAME REQUIRED	REMARKS	SIGN DETAIL LOCATION			
								"A"	"B"	RETAIN	SALVAGE FROM	SALVAGE TO	REMOVE	RETAIN	REMOVE		1.75	2.00	2.50	FOUNDATION	3.00	3.50	4.00			5.00	SHSM	PROJECT SHEET #	STANDARD SHEET #
																	(LB / FT)				(LB / FT)								
ALBURGH US-2 WB							FY-FLUORESCENT YELLOW FYG-FLUORESCENT YELLOW GREEN																"SHSM"-STANDARD HIGHWAY SIGNS AND MARKINGS						
		F	D9-22	24	24			4.00																	X				
		E	D9-22	24	24		 II/15/14	4.00																	X				
WB	3.327	F	R2-1	24	30		SPEED LIMIT 50 II/15/14					1	X				14.00 14.25												
		F	W1-10L	36	36			9.00						2		X								X		INSTALL AT LOCATION OF EXISTING SPEED LIMIT SIGN			
WB	3.292	F	D3-1	UNK.	UNK.		II/15/14					1	X				13.25 14.25												
		F	D3-1	64	12		Missile Base Rd	5.33						2		X										MISSILE BASE RD (TH-56); FIELD LOCATE FOR VISIBILITY FROM ROUTE 2		13	
WB	3.292	G	VR-017	24	30							1	X																
		G	R2-1	24	30		SPEED LIMIT 35 SIDE ROAD	5.00		+																			
		G	VR-017	24	30		 II/15/14	5.00																		MISSILE BASE RD (TH-56)		10	
WB	3.285	H	R1-1	30	30							1	X																
		H	R1-1	30	30		 II/15/14	6.25																X		MISSILE BASE RD (TH-56)			
WB	3.232	F	D1-1	72	10		D-BOARD ASSEMBLY II/18/14					1	X													SLIP BASES			
		F	D1-1	72	10												10.75 10.75												
		F	D1-1A	72	20																								
		F	VD1-1	72	12			6.00						2															
SIGN SUMMARY SHEET							SHEET TOTALS	44.58 39.53	0.00	1	0	0	7	0	0	4	77.25 66.0	0	0.0	0.0	0.0	0.0	PROJECT NAME: ALBURGH-COLCHESTER PROJECT NUMBER: STPG SIGN(45)						
VERMONT AGENCY OF TRANSPORTATION							TOWN DIRECTIONAL TOTALS	870.8	0.0	23	3	2	157	0	0	80	1200.0	0		0.0			FILE NAME: 2 Alburgh US2 WB TSS.xls PROJECT MANAGER: D. BRYANT DESIGNED BY: B. TOOTHAKER ALBURGH WB SHEET 19						
																						PLOT DATE: 4/15/2014 DRAWN BY: J. BLANCHARD CHECKED: K. KERN SHEET 60 OF 167							