



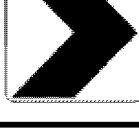
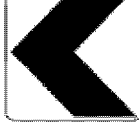
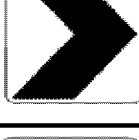
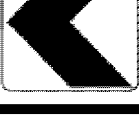


DIRECTION	MILEPOINT	LOCATION CODE (SHEET 2)	SIGN CODE	WIDTH (IN)	HEIGHT (IN)	SHEETING REMARKS	SIGN LEGEND	NEW SIGNS		EXISTING SIGNS				EXIST POST		NUMBER OF NEW POSTS	SQUARE STEEL (IN)			TUBULAR STEEL Ø (IN)				SIGN FRAME REQUIRED	REMARKS	SIGN DETAIL LOCATION				
								"A"	"B"	RETAIN	SALVAGE FROM	SALVAGE TO	REMOVE	RETAIN	REMOVE		1.75	2.00	2.50	FOUNDATION	3.00	3.50	4.00			5.00	SHSM	PROJECT SHEET #	STANDARD SHEET #	
																	(LB / FT)				(LB / FT)									
ALBURGH US-2 WB							FY-FLUORESCENT YELLOW FYG-FLUORESCENT YELLOW GREEN															"SHSM"-STANDARD HIGHWAY SIGNS AND MARKINGS								
WB	3.049 - 2.830	F/G	N/A	6	8		INSTALL (11) NEW DELINEATOR ASSEMBLIES																	INSTALL 11 BACK TO BACK DELINEATOR ASSEMBLIES AT 100 FT SPACINGS. SEE SHEET 4						
WB	2.862	F	VW-619	36	36																									
		F	VW-619	36	36			11/18/14	9.00																	11				
WB	2.159	F	W13-1	18	18		45 MPH																							
		F	W1-2MR	30	30		MODIFIED RIGHT CURVE																							
WB	2.085	F	W1-10bR	36	36			11/18/14	9.00																		INSTALL 100 FT EAST OF BEGINNING OF CURVE (391 FT WEST OF EXISTING)	X		
WB	1.609	F	W13-1	18	18		45 MPH																							
		F	W1-2L	30	30																									
		F	W1-2L	30	30			11/18/14	6.25																					
WB	1.522	F	W1-8L	18	24			11/18/14	3														X				INSTALL 58 FT EAST OF LEFT LARGE ARROW	X		
		E	W1-8R	18	24				3																					
WB	1.511	F	W1-6	48	24		<=== LEFT LARGE ARROW	11/18/14																						
WB	1.492	F	W1-8L	18	24			11/18/14	3														X				INSTALL 100 FT WEST OF LEFT LARGE ARROW	X		
		E	W1-8R	18	24				3																					
WB	1.462	F	W1-8L	18	24			11/18/14	3														X				INSTALL 158 FT WEST OF PREVIOUS CHEVRON	X		
SIGN SUMMARY SHEET							SHEET TOTALS	39.25	0.00	0	0	0	6	0	0	6	98.00	0	0.0	0.0	0.0	0.0	PROJECT NAME: ALBURGH-COLCHESTER							
								SF	SF	EA	EA	EA	EA	EA	EA	EA	FT	EA	LB	LB	LB	LB	PROJECT NUMBER: STPG SIGN(45)							
VERMONT AGENCY OF TRANSPORTATION							TOWN DIRECTIONAL TOTALS	870.8	0.0	23	3	2	157	0	0	80	1200.0	0		0.0				FILE NAME: 2 Alburgh US2 WB TSS.xls PLOT DATE: 4/15/2014						
																							PROJECT MANAGER: D. BRYANT DRAWN BY: J. BLANCHARD							
																							DESIGNED BY: B. TOOTHAKER CHECKED: K. KERN							
																							ALBURGH WB SHEET 22 SHEET 63 OF 167							