


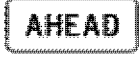






DIRECTION	MILEPOINT	LOCATION CODE (SHEET 2)	SIGN CODE	WIDTH (IN)	HEIGHT (IN)	SHEETING REMARKS	SIGN LEGEND	NEW SIGNS		EXISTING SIGNS				EXIST POST		NUMBER OF NEW POSTS	SQUARE STEEL (IN)			TUBULAR STEEL Ø (IN)				SIGN FRAME REQUIRED	REMARKS	SIGN DETAIL LOCATION		
								"A"	"B"	RETAIN	SALVAGE FROM	SALVAGE TO	REMOVE	RETAIN	REMOVE		1.75	2.00	2.50	3.00	3.50	4.00	5.00			SHSM	PROJECT SHEET #	STANDARD SHEET #
																	(LB / FT)			(LB / FT)								
<b>NORTH HERO US-2 EB</b>							FY-FLUORESCENT YELLOW FYG-FLUORESCENT YELLOW GREEN																"SHSM"-STANDARD HIGHWAY SIGNS AND MARKINGS					
		A	VD-018	30	18		 12/03/14	3.75							1	13.75 X										6		
EB	5.421	A	R2-1	36	48																							
		A	R2-1	30	36		 12/03/14	7.50																				X
EB	5.434	A	W16-9	24	10		AHEAD 12/03/14																					
		A	W11-2	30	30		PEDESTRIAN SYMBOL																					
EB	5.459	A	W11-2	30	30	FYG	 12/03/14	6.25							1	15.25 X											X	
		A	W16-9P	24	10	FYG	 12/03/14	1.67																			X	
EB	5.603	A	R2-1	24	30																							
		A	R2-1	24	30		 12/03/14	5.00																			X	
EB	5.648	A	W16-7	24	12																							
		A	W11-2	30	30																							
		A	W11-2	30	30	FYG	 12/03/14	6.25																			X	
		A	W16-7P	24	12	FYG	 12/03/14	2.00																			X	
EB	5.726	A	W11-8	30	30																							
		A	W11-8	30	30		 12/03/14	6.25																			X	
<b>SIGN SUMMARY SHEET</b>							<b>SHEET TOTALS</b>		38.67	0.00	0	0	0	7	0	0	2	29.00 36.0	0	0.0	0.0	0.0	0.0	PROJECT NAME: <b>ALBURGH-COLCHESTER</b>				
							SF	SF	EA	EA	EA	EA	EA	EA	EA	EA	EA	FT	EA	LB	LB	LB	LB	PROJECT NUMBER: <b>STPG SIGN(45)</b>				
VERMONT AGENCY OF TRANSPORTATION							<b>TOWN DIRECTIONAL TOTALS</b>		320.7	0.0	8	1	0	57	0	0	30	450.0	0		0.0				FILE NAME: <b>3 NORTH HERO US2 EB TSS.xlt</b> PLOT DATE: <b>3/14/2014</b>			
																								DRAWN BY: <b>J. BLANCHARD</b>				
																								DESIGNED BY: <b>B. TOOTHAKER</b> CHECKED: <b>K. KERN</b>				
																								NORTH HERO EB SHEET 5 SHEET <b>71</b> OF <b>167</b>				